


I HEREBY CERTIFY HAVING SURVEYED
LOTS 1 & 2 E.W. HAWKES SUB OF BLK 10 WINDSLOWS ADD.
AND SAME TO BE CORRECT

Feb 23rd 1918

C. F. Scheunemann
Surveyor

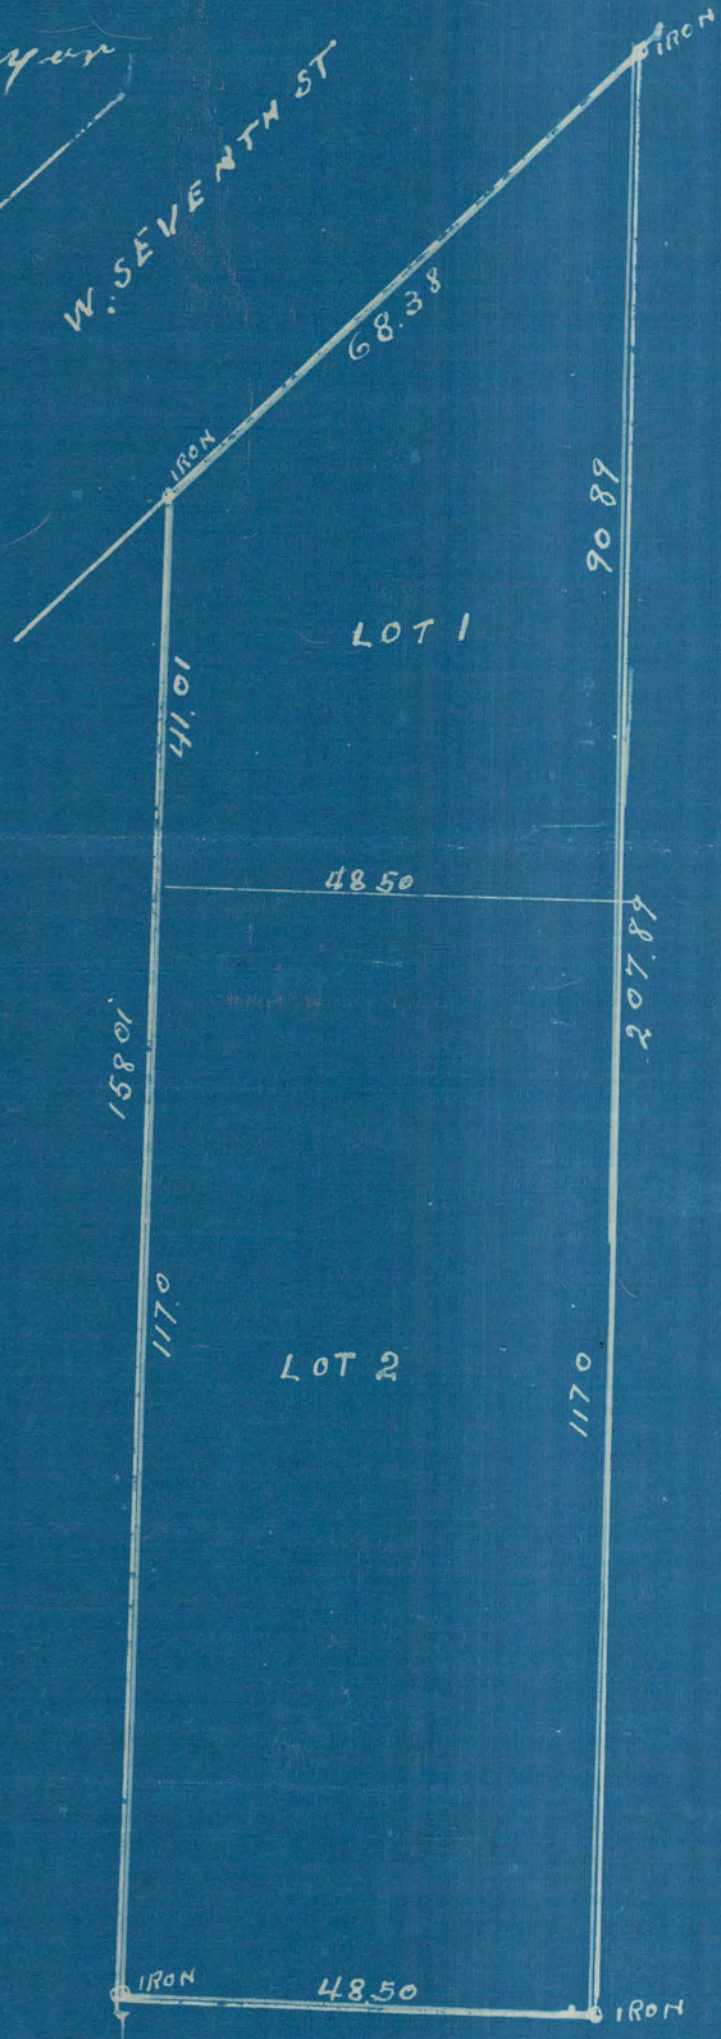

ANN ST.

YANKEE ST

2135