

DAYTON AND IRVINES

ADD

SURVEY OF

SWLY $\frac{1}{2}$ LOT 15.

BLK 67

OCT 30-1919


JENS PEDERSEN
SURV.

SCALE 20' = 1"

2135

SMITH AVE

SMITH AVE

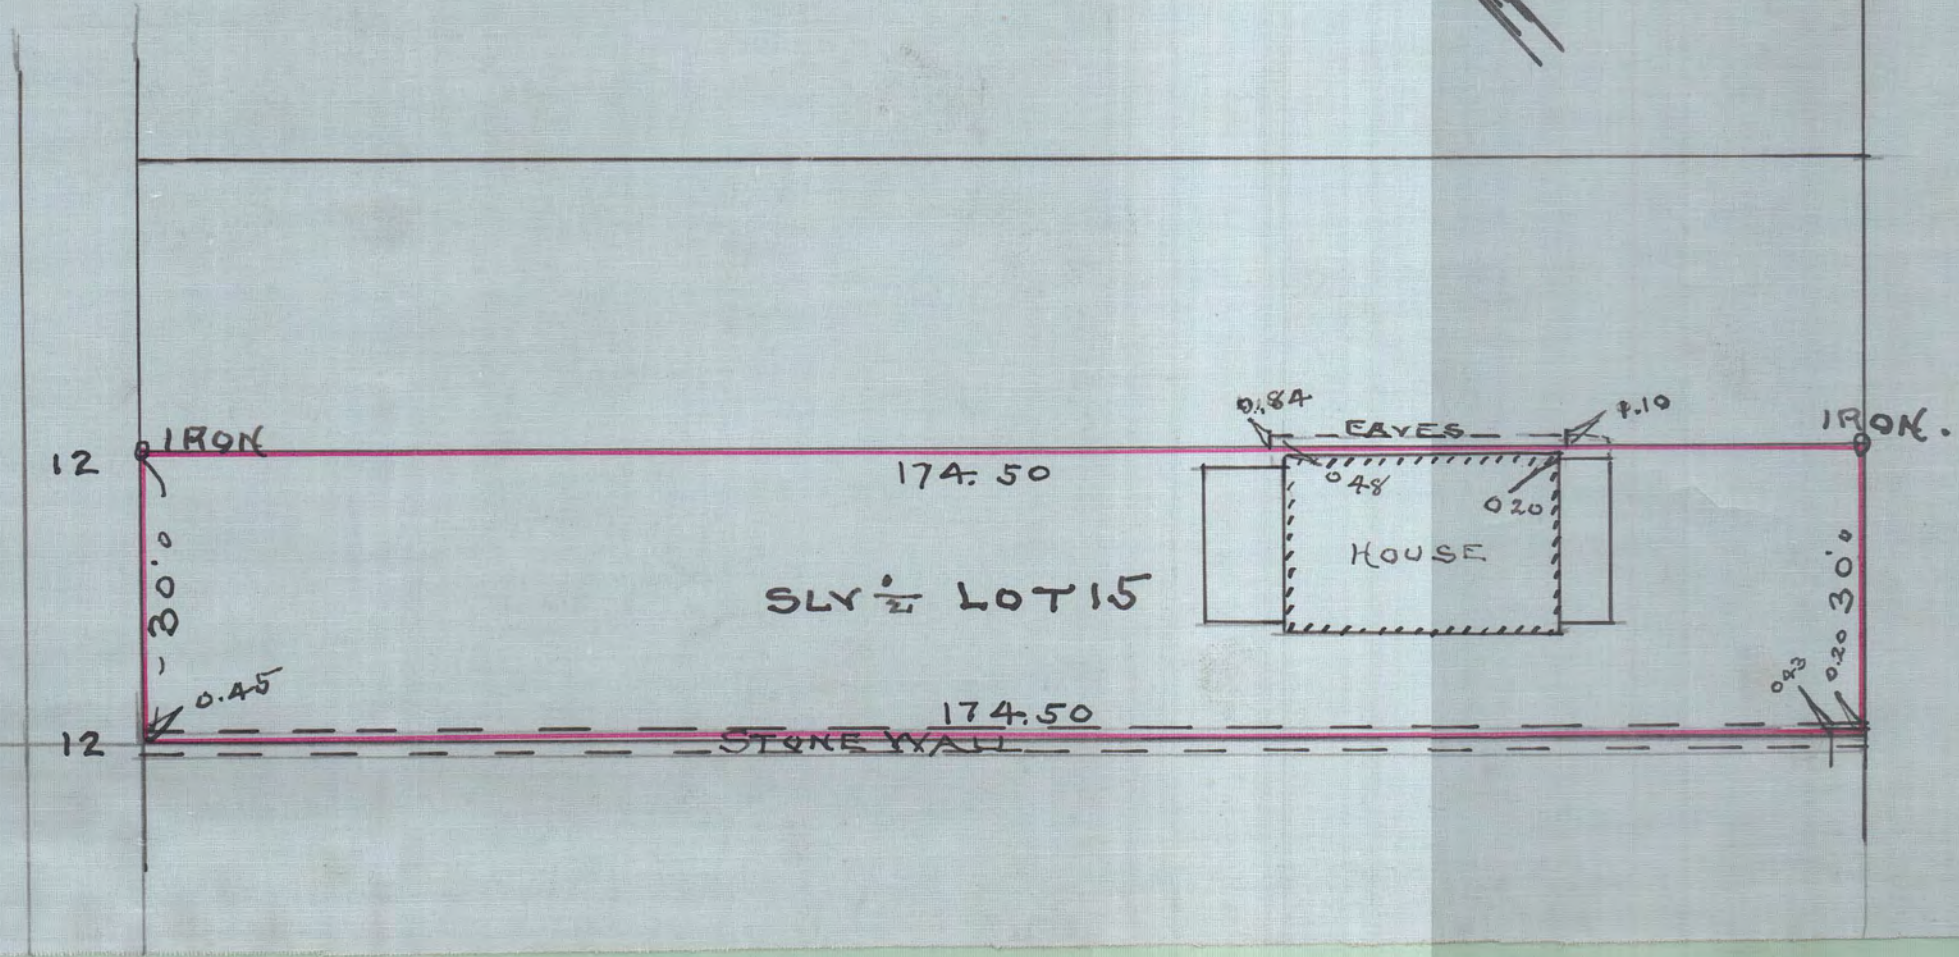

2135