

WEST ST. PAUL PROPER  
SURVEY OF


E. 1/2 LOT 8, & E. 1/2 OF SLY. 15 FT. OF LOT 9; BLK. 58.

JUNE, 22, 1917.

JENS PEDERSEN  
SURVEYOR.

SCALE 1"=20'

2154

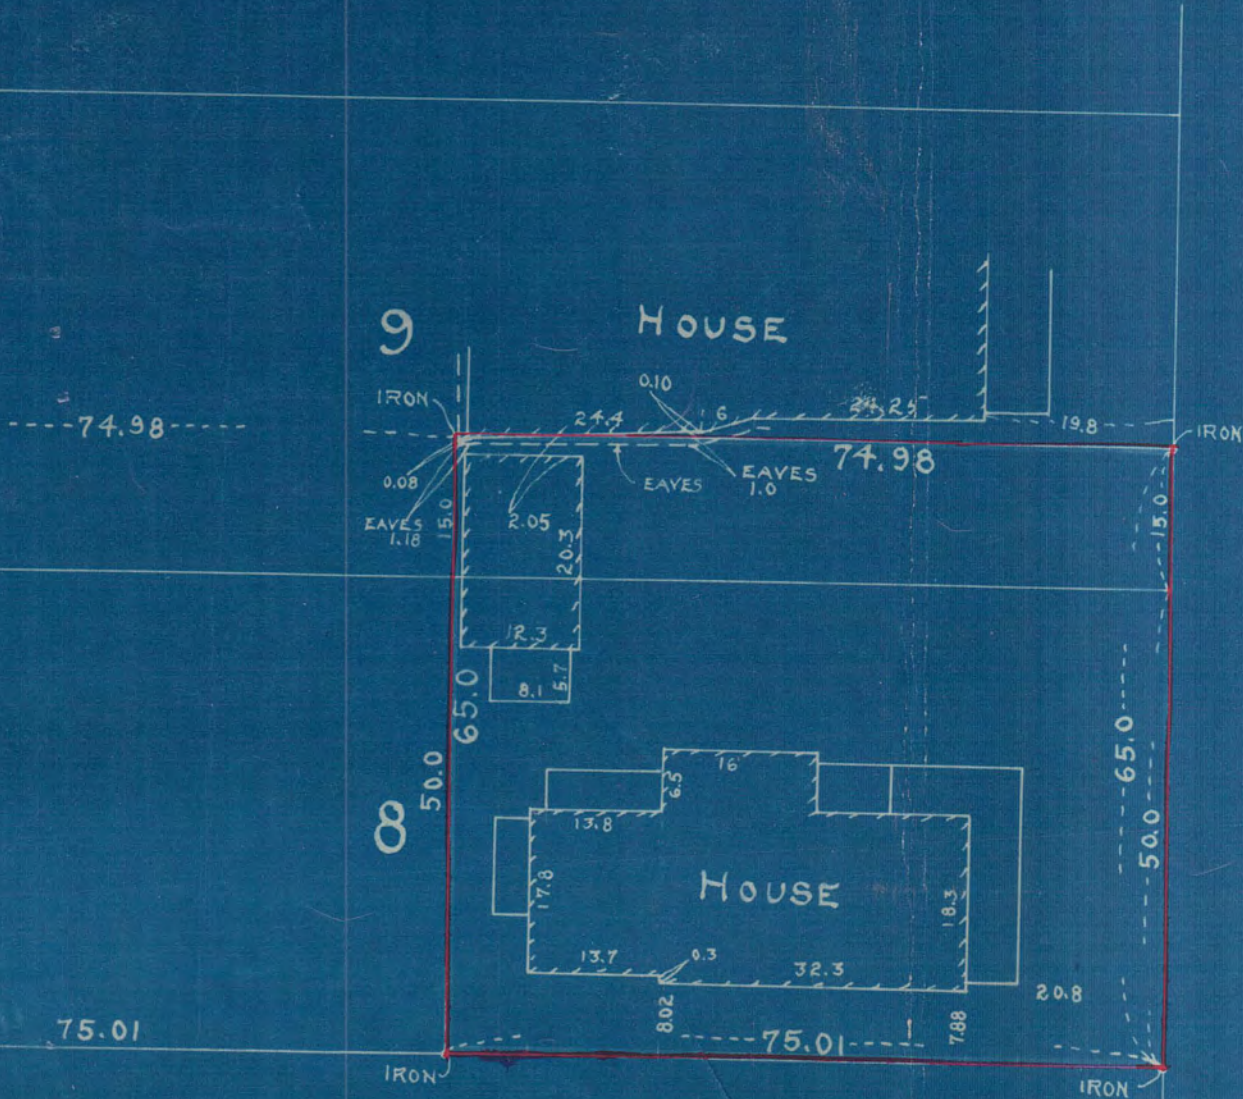

AVE.

WINSLOW

# 2154