

ST. ANTHONY PARK N.

SURVEY OF

LOT 30

BLK. 38.

JULY, 2, 1917.


JENS PEDERSEN

SURVEYOR.

SCALE 1" = 20'

CARTER

AVE.

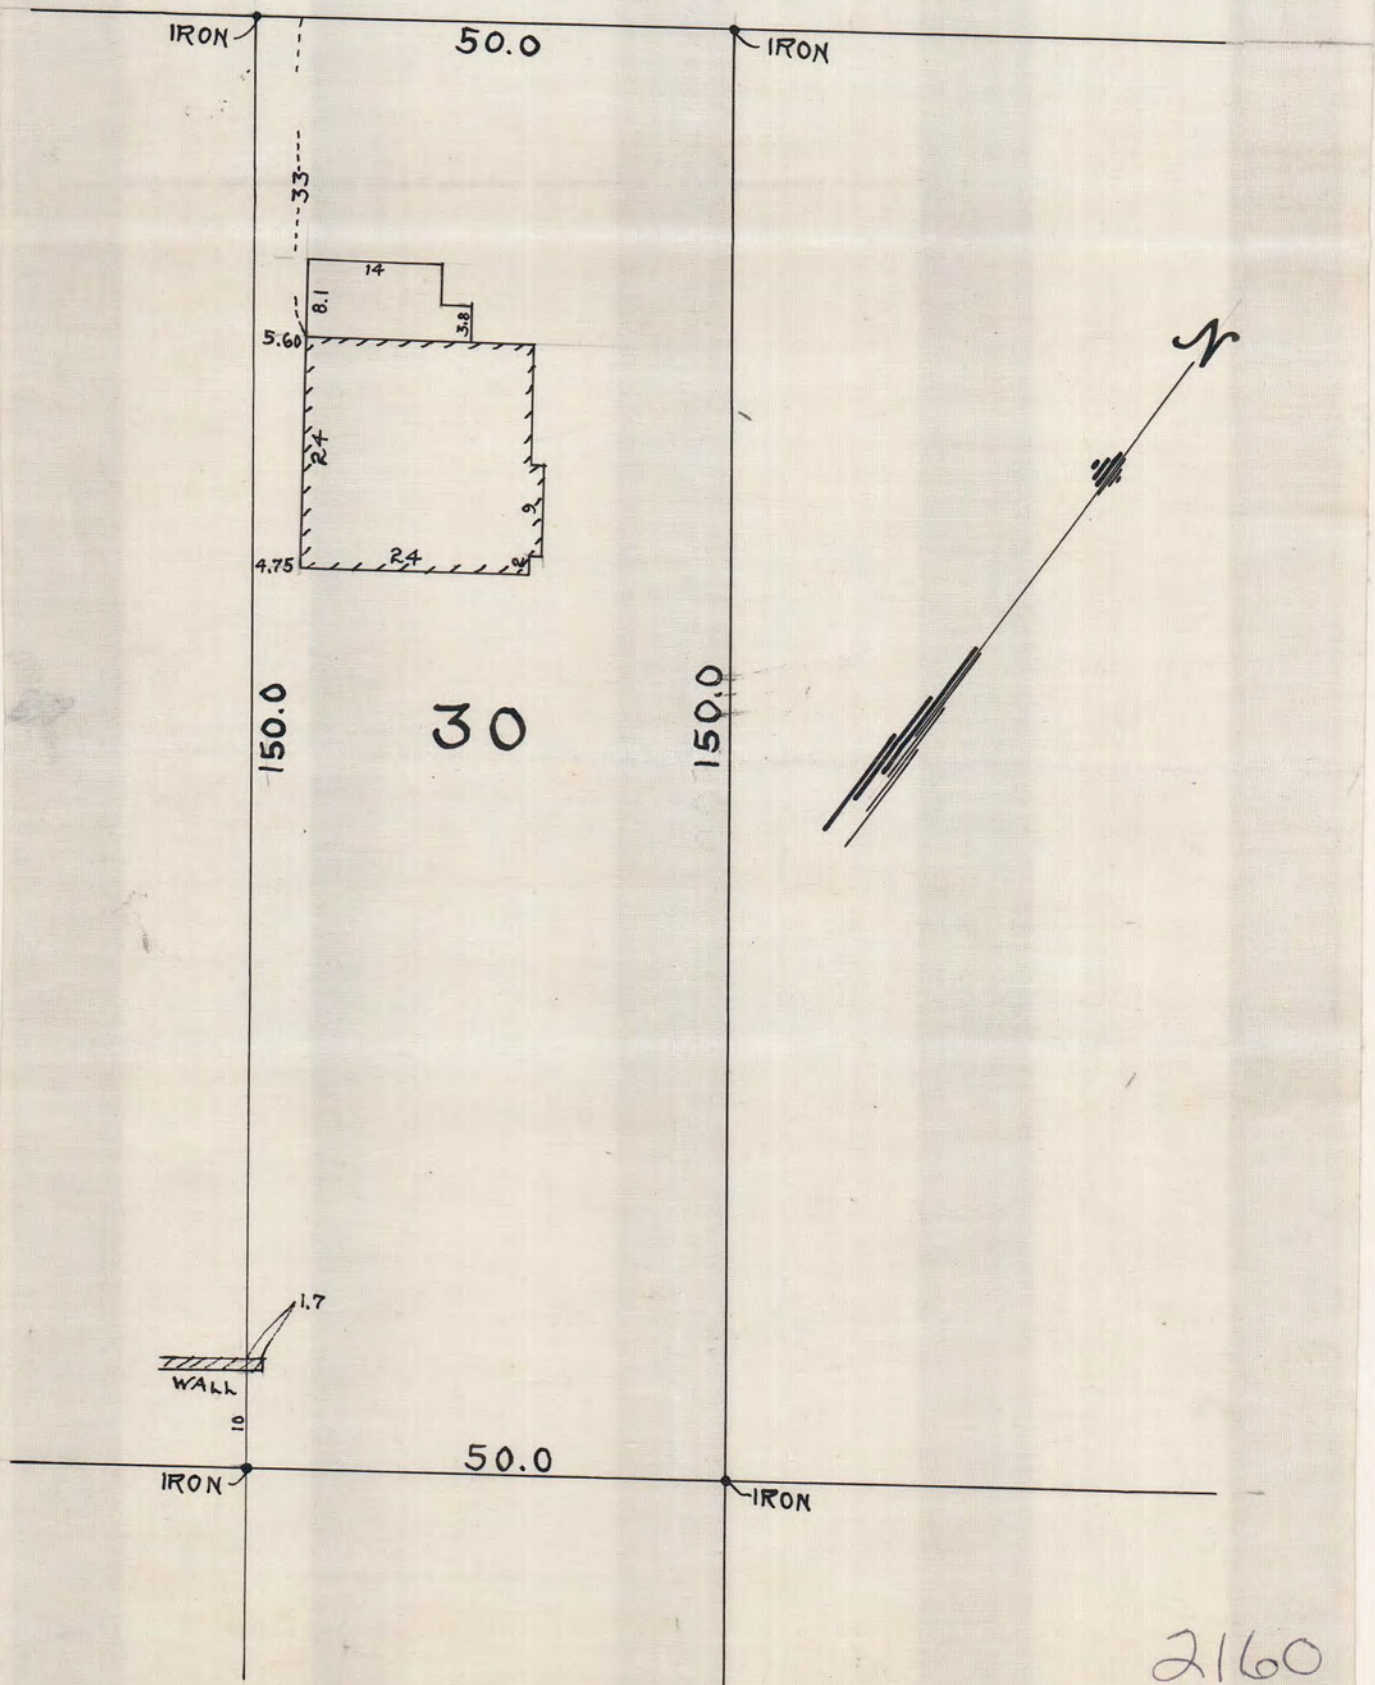

2160