

ST. ANTHONY PARK NORTH

SURVEY OF

LOT 36,

BLK. 38.


JULY, 2, 1917.

JENS PEDERSEN

SURVEYOR.


SCALE 1" = 20'

CARTER

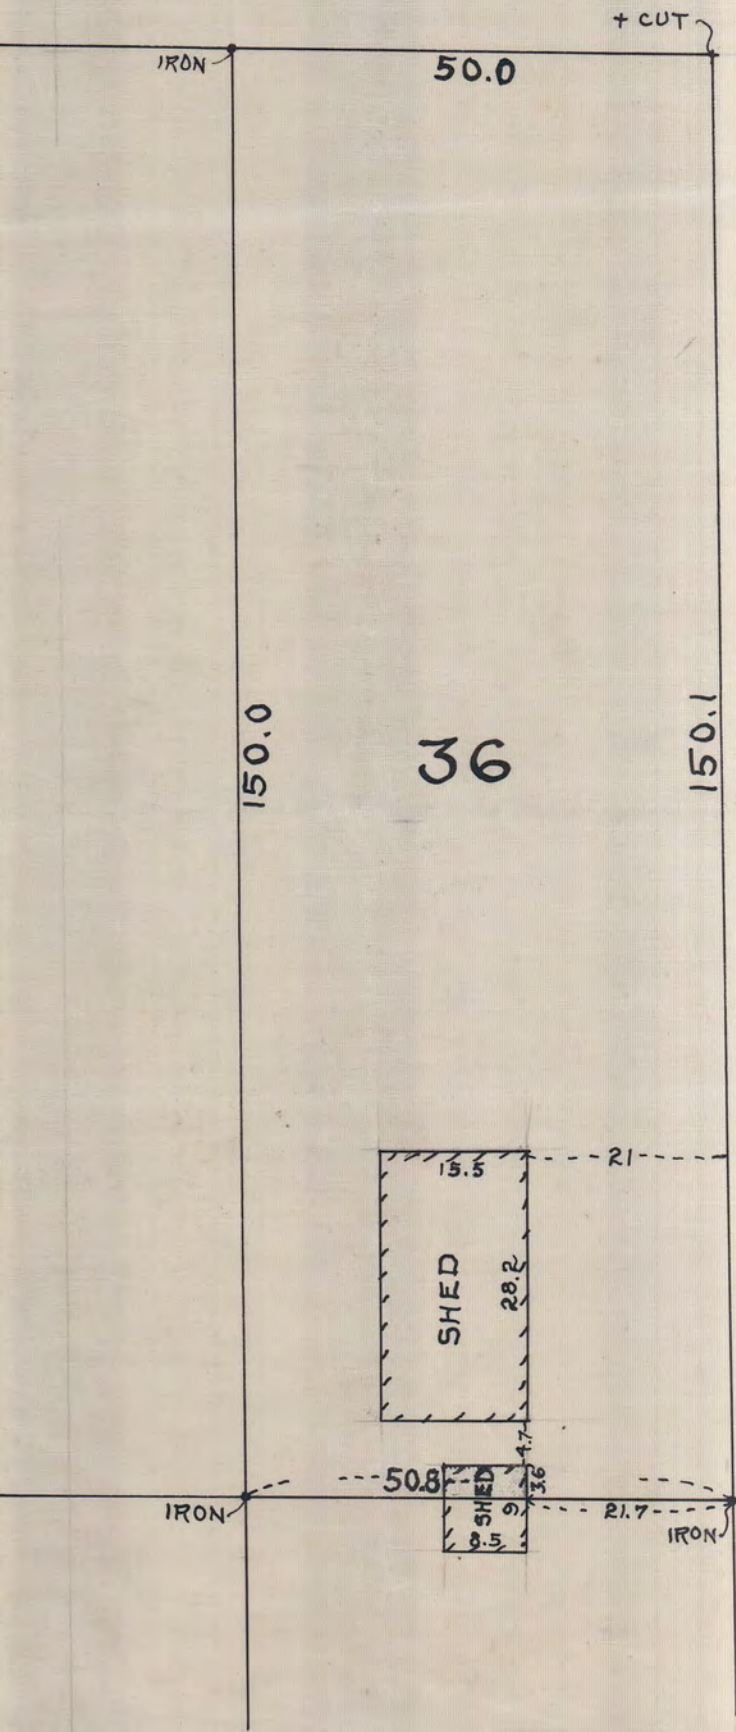

ALLEY

AVE.

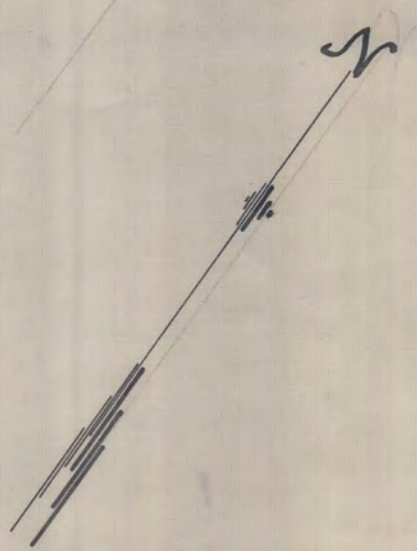

2160