


# WEST ST. PAUL PROPER

SURVEY OF  
LOTS 6, 7 & 8, ALSO WLY. 50 FT. OF LOTS 6 & 7,  
JULY, 14, 1917.

BLK. 30.

JENS PEDERSEN  
SURVEYOR & CIVIL ENGINEER.

SCALE 1"=10'

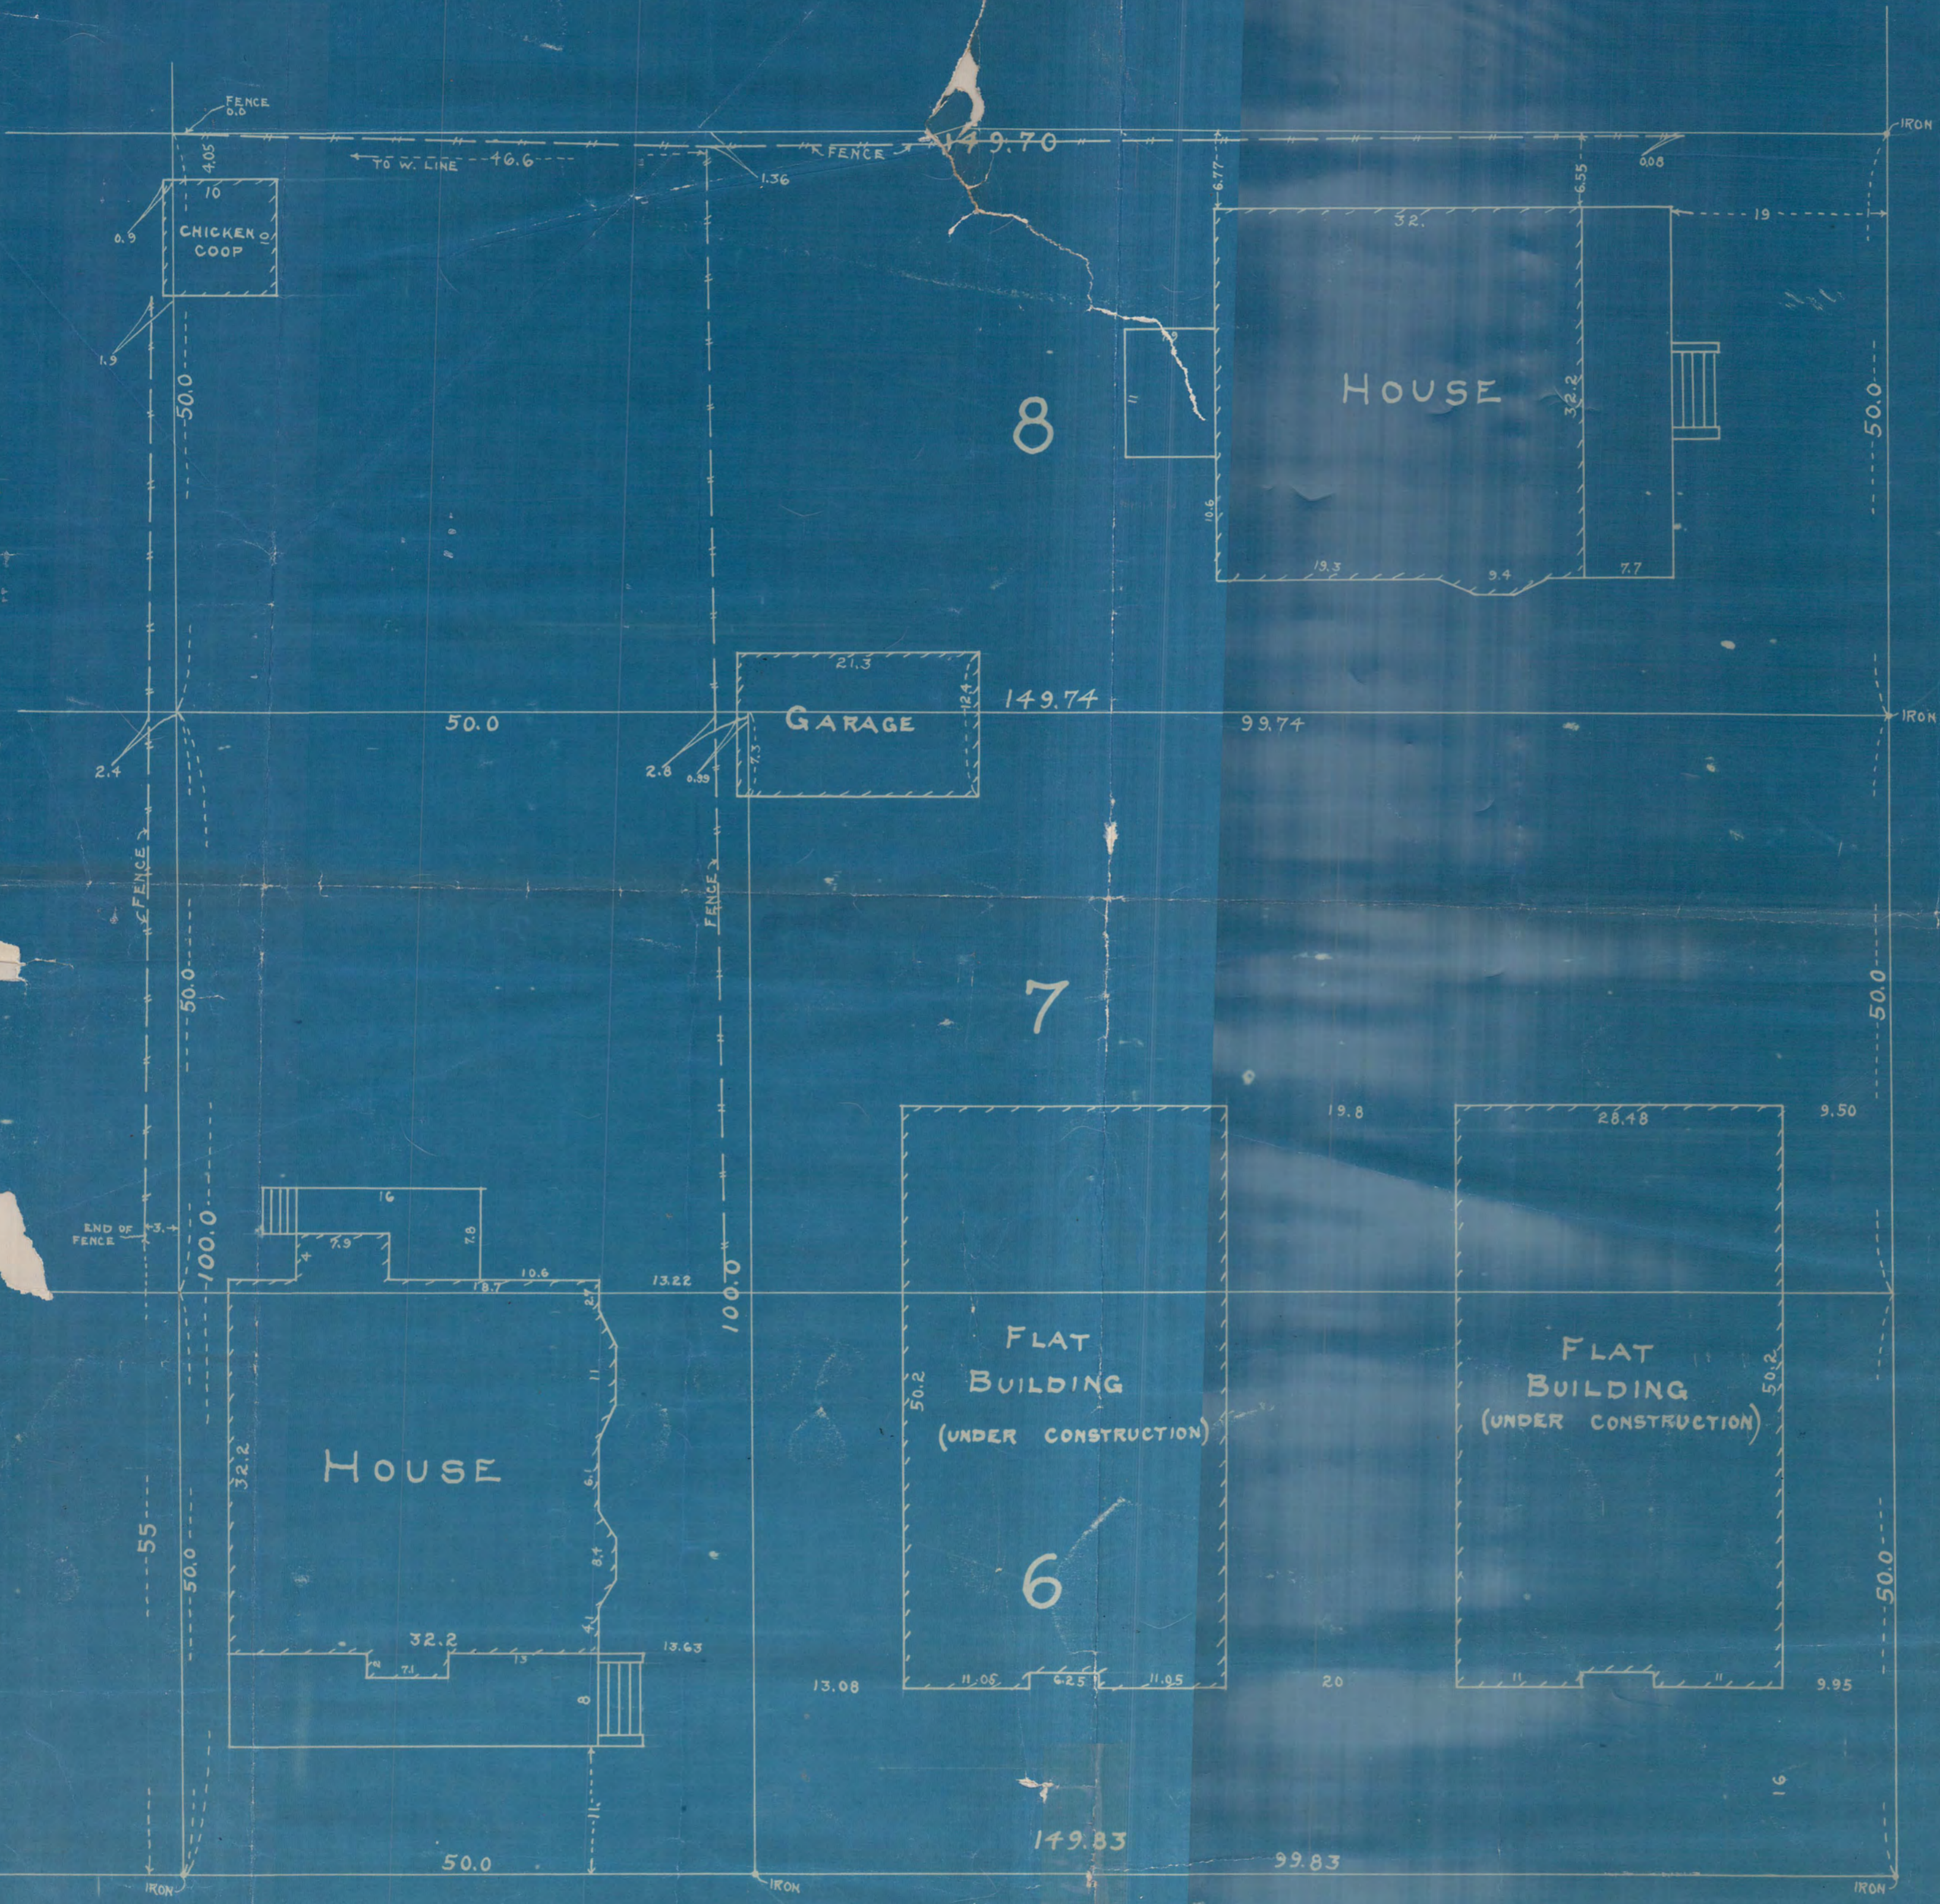

AVE.

STRYKER

ISABEL

ST.

# 2168