


SURVEY OF LOT 3 AUDITOR'S SUB. No 12

Scale 10 ft. per inch

April 6. 1918

J. J. Armstrong  
Civil Eng'r.

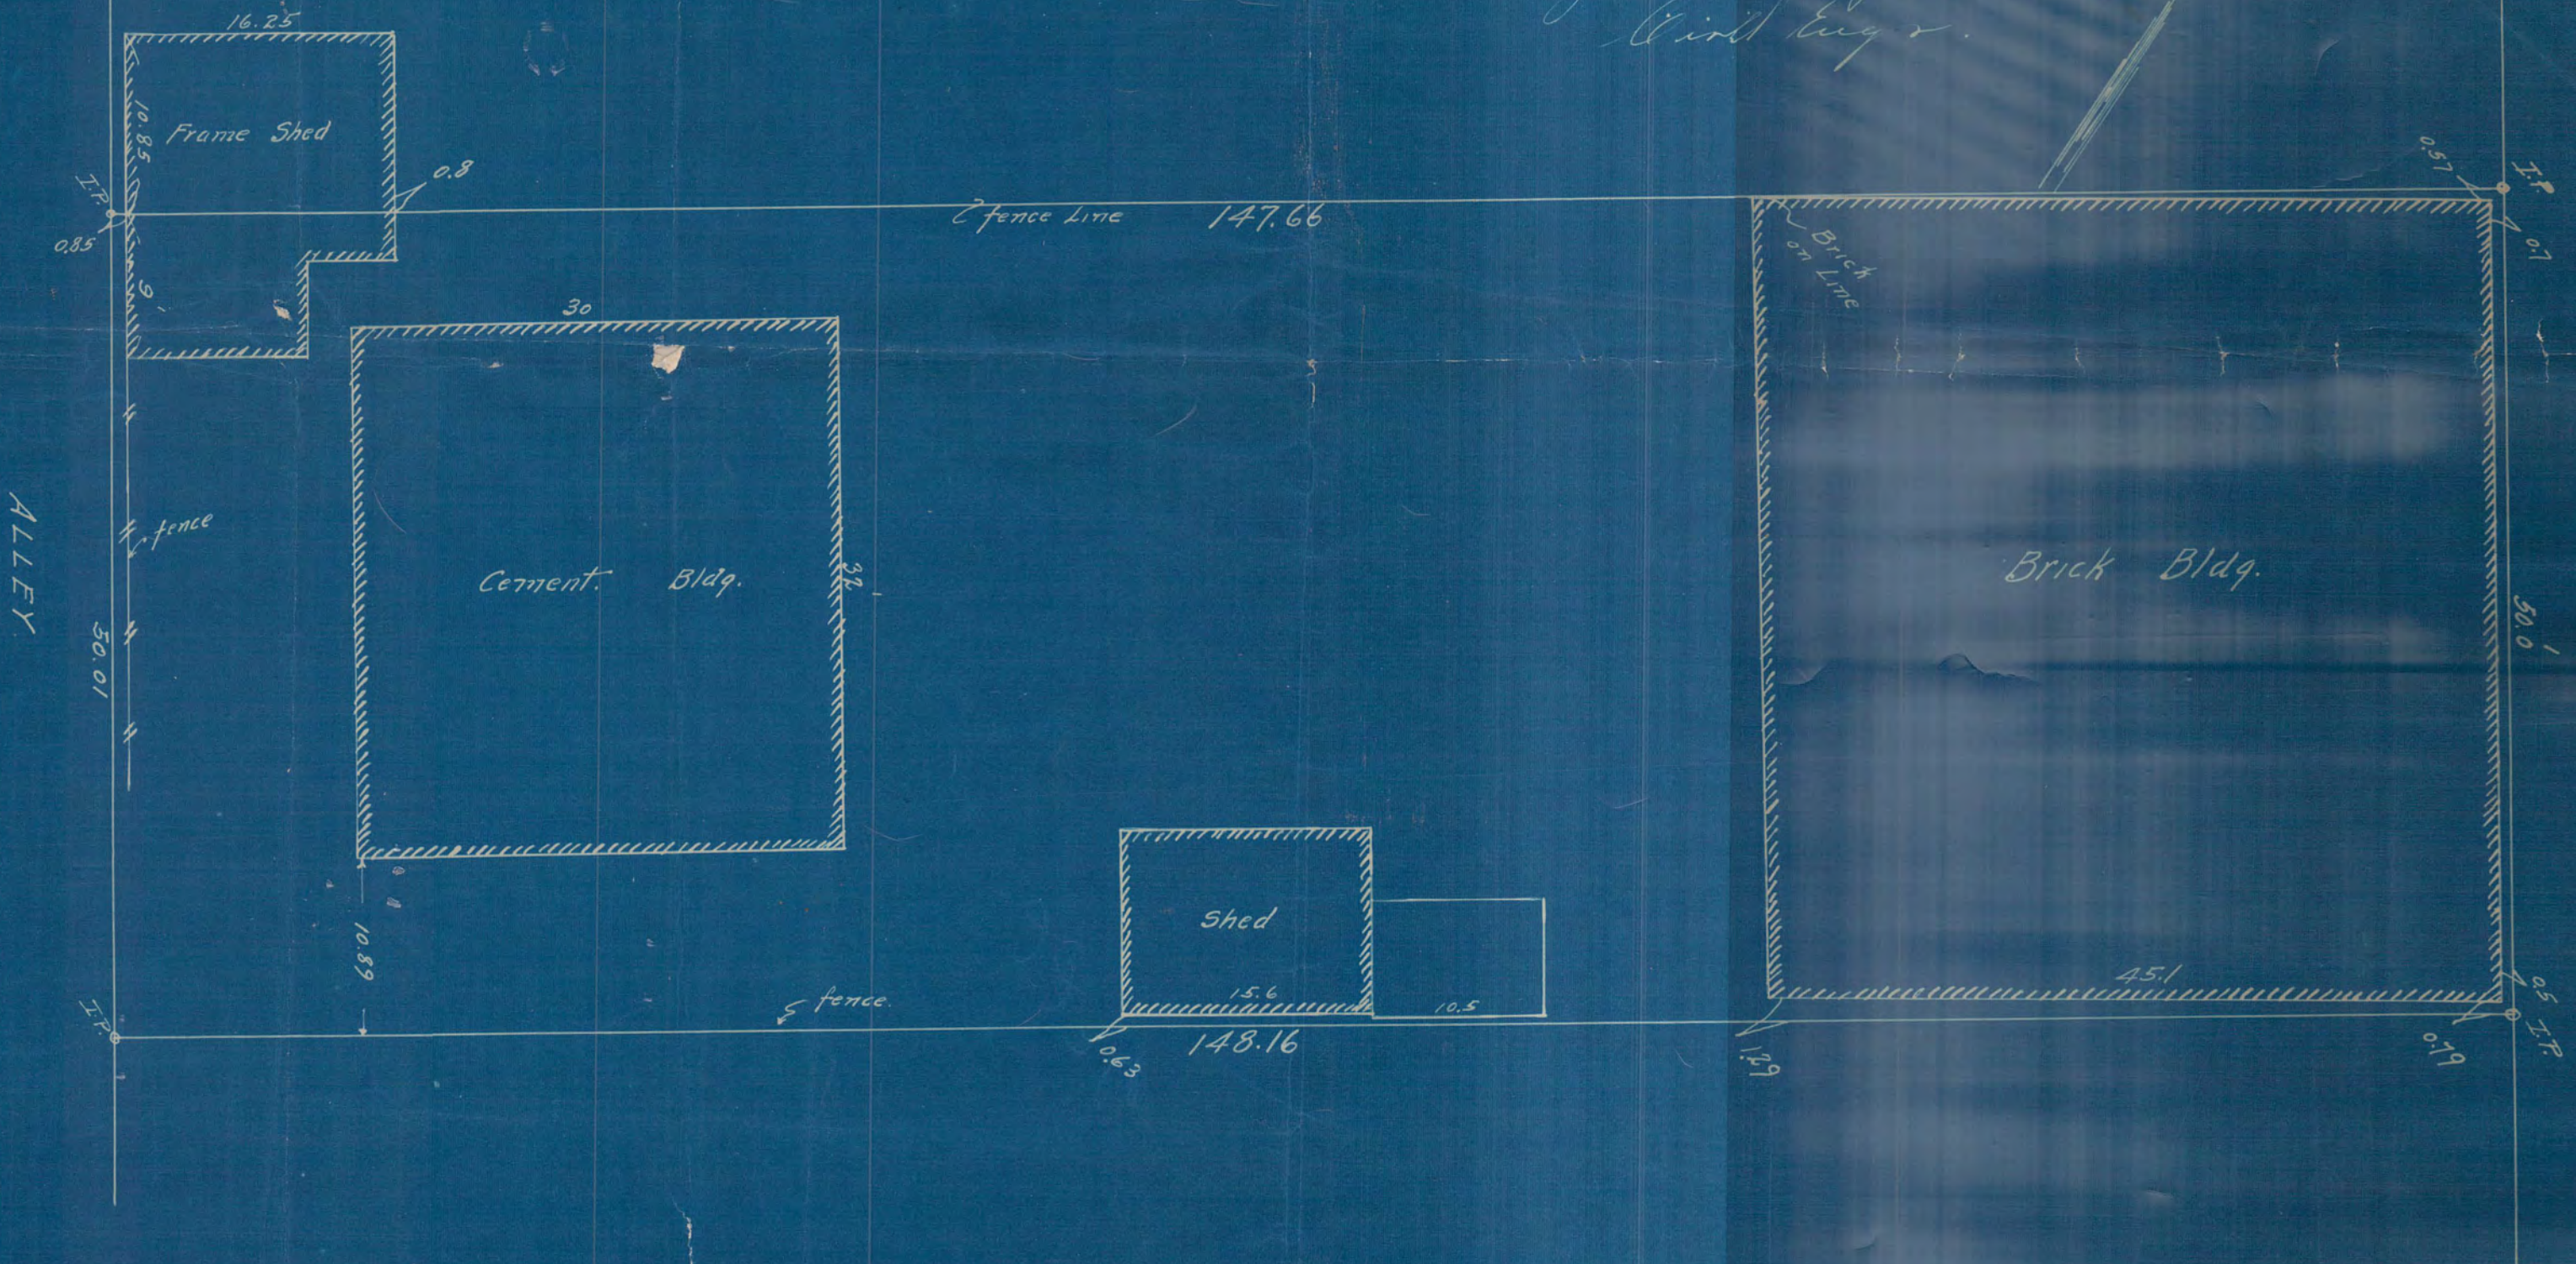

# 2236