

MORIN'S ENLG
 OF
 LA FOND'S ADD
 SURVEY OF
 WLY 19 FT 8 IN OF LOT 4 AND ELY 17 FT LOT 5
 BLOCK 32


JUNE 22-1918

SCALE 10 FT = 1 IN

JENS PEDERSEN
 SURV.

LA FOND

ST.

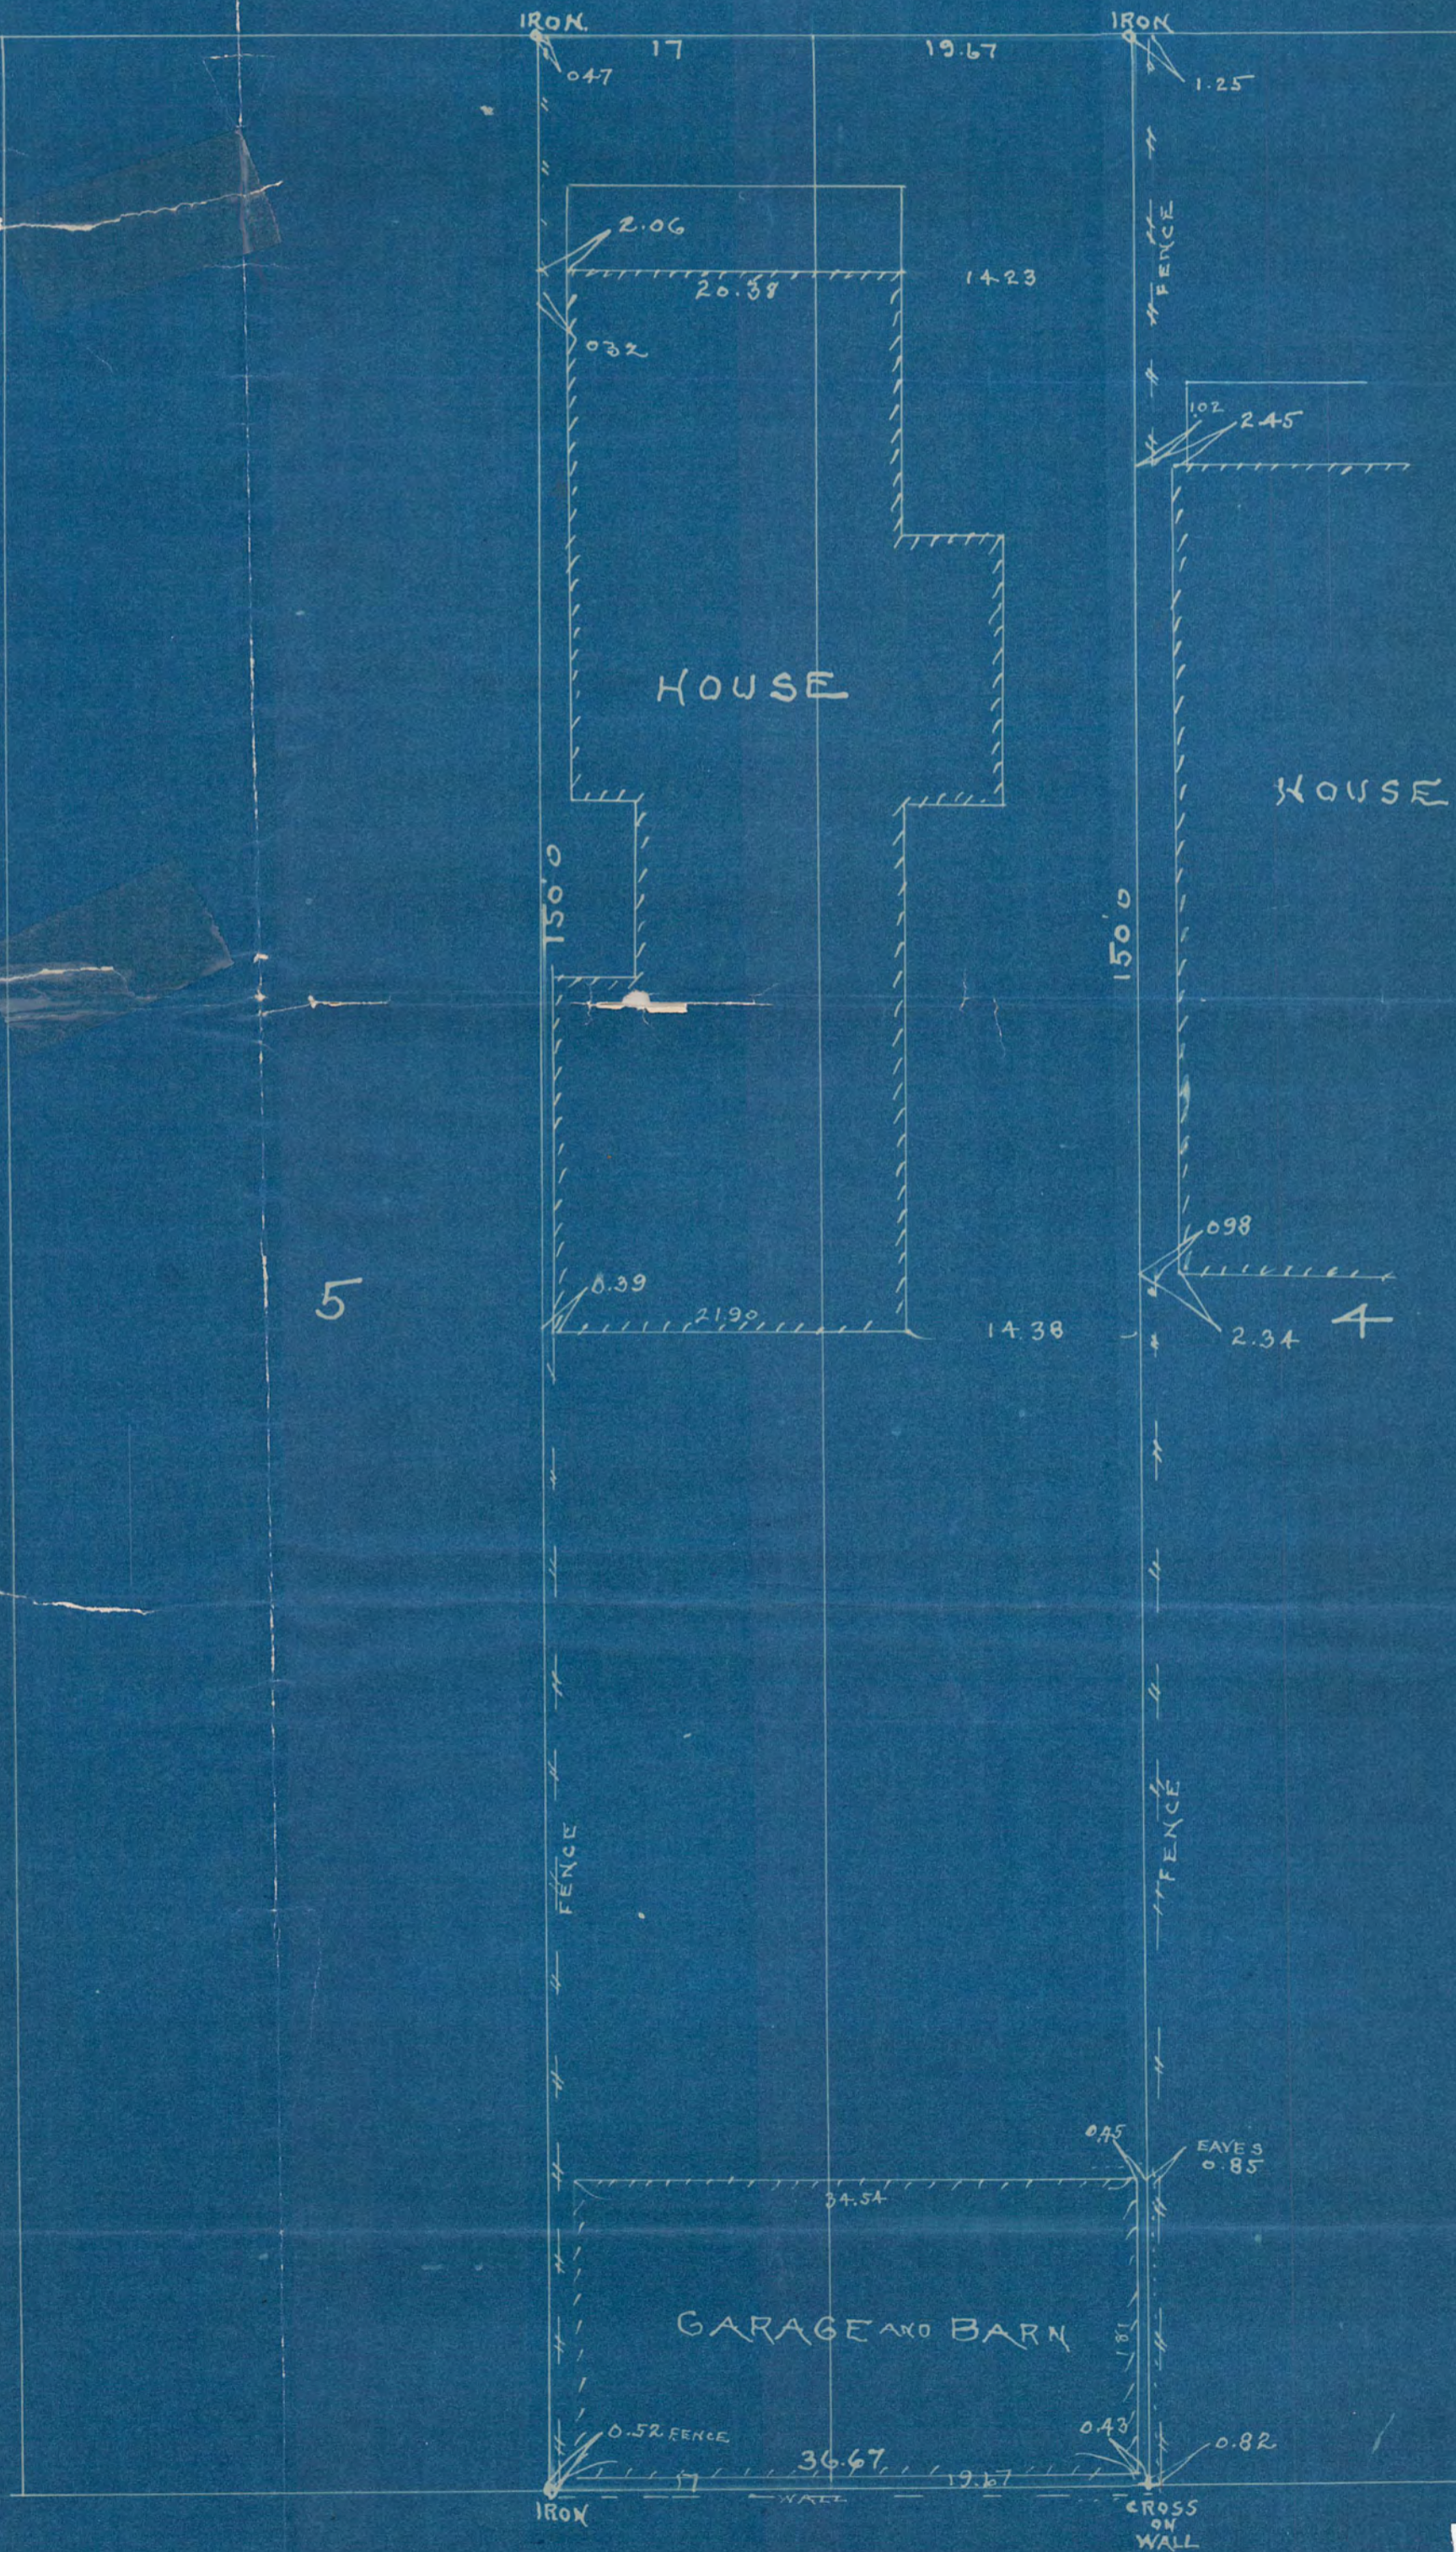

2276