

ADD.


SURVEY OF

LOTS 1 AND 2 Block 5 AND
also all that parcel of land lying between
the front line of said lots and Martin St.
(now Central Ave.) and Summit Place (now
Cathedral Place) in the City of St. Paul.

Jens Pedersen
Surveyor



Scale 10' = 1"

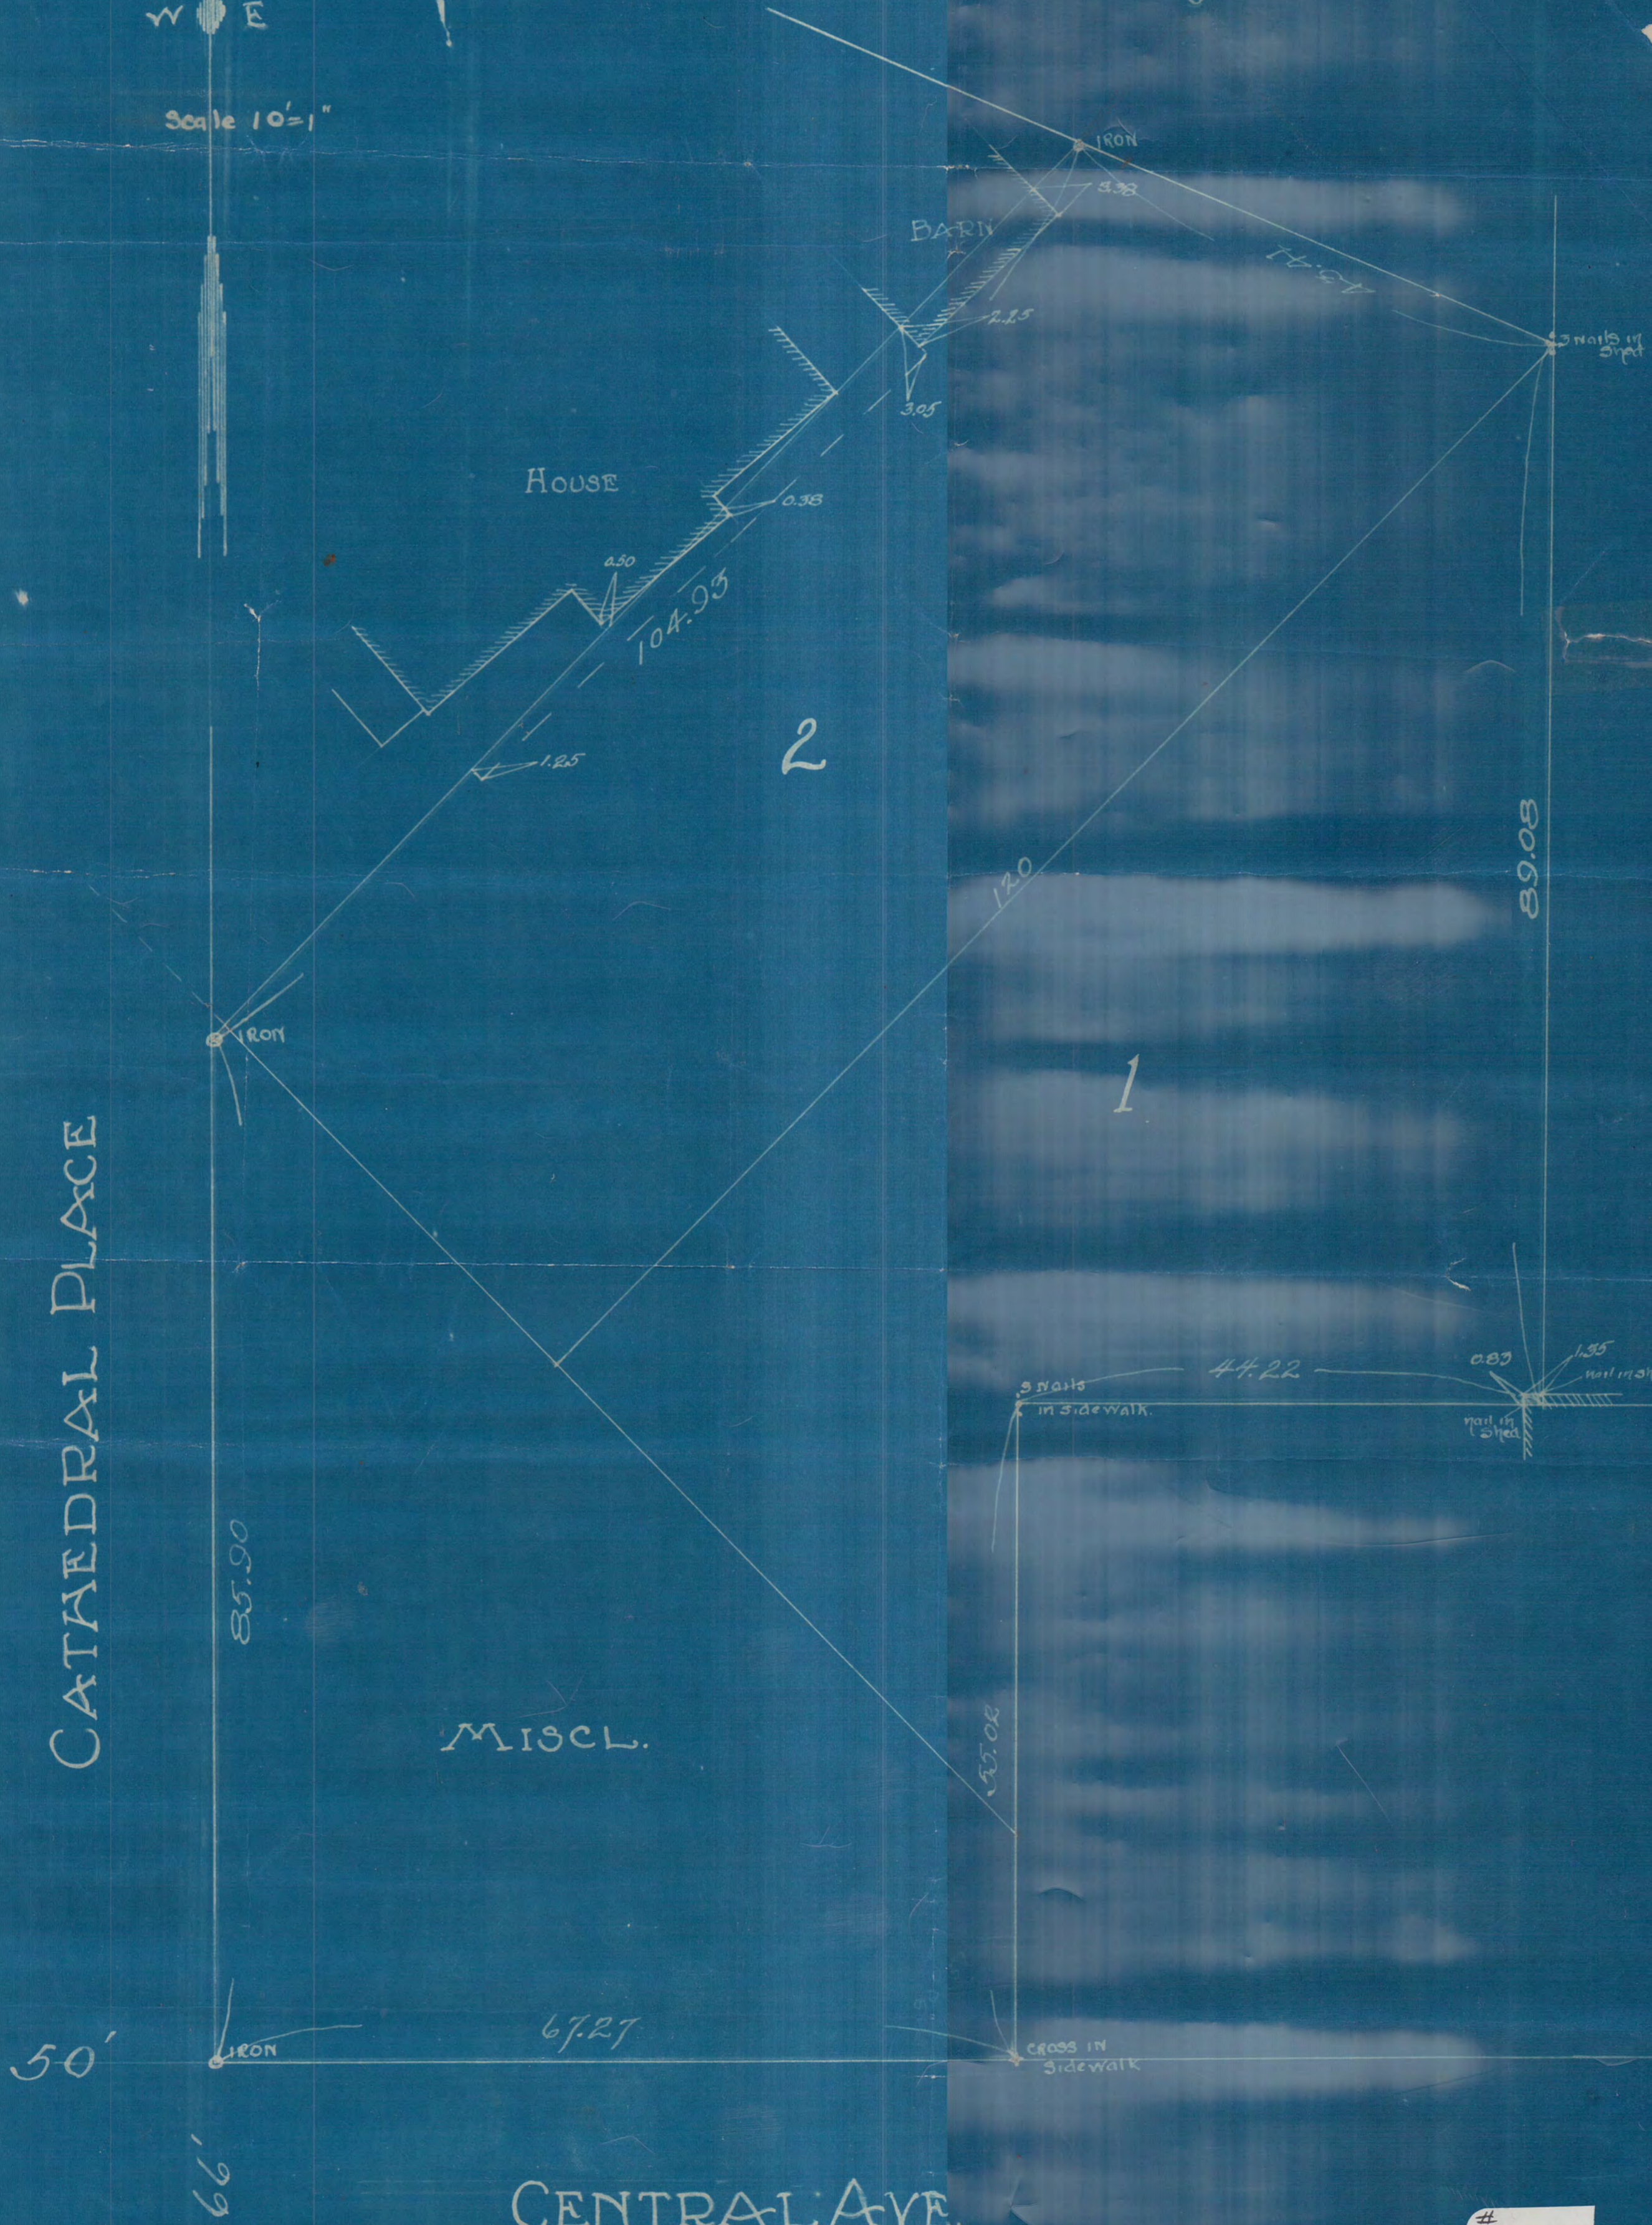

CATHEDRAL PLACE

MISCL.

CENTRAL AVE.


2300

AG FULLER'S ADD.

SURVEY OF

LOTS 1 AND 2 Block 5 AND
also all that parcel of land lying between
the front line of said lots and Martin St.
(now Central Ave.) and Summit Place (now
Cathedral Place) in the City of St. Paul.

Jens Pedersen
Surveyor

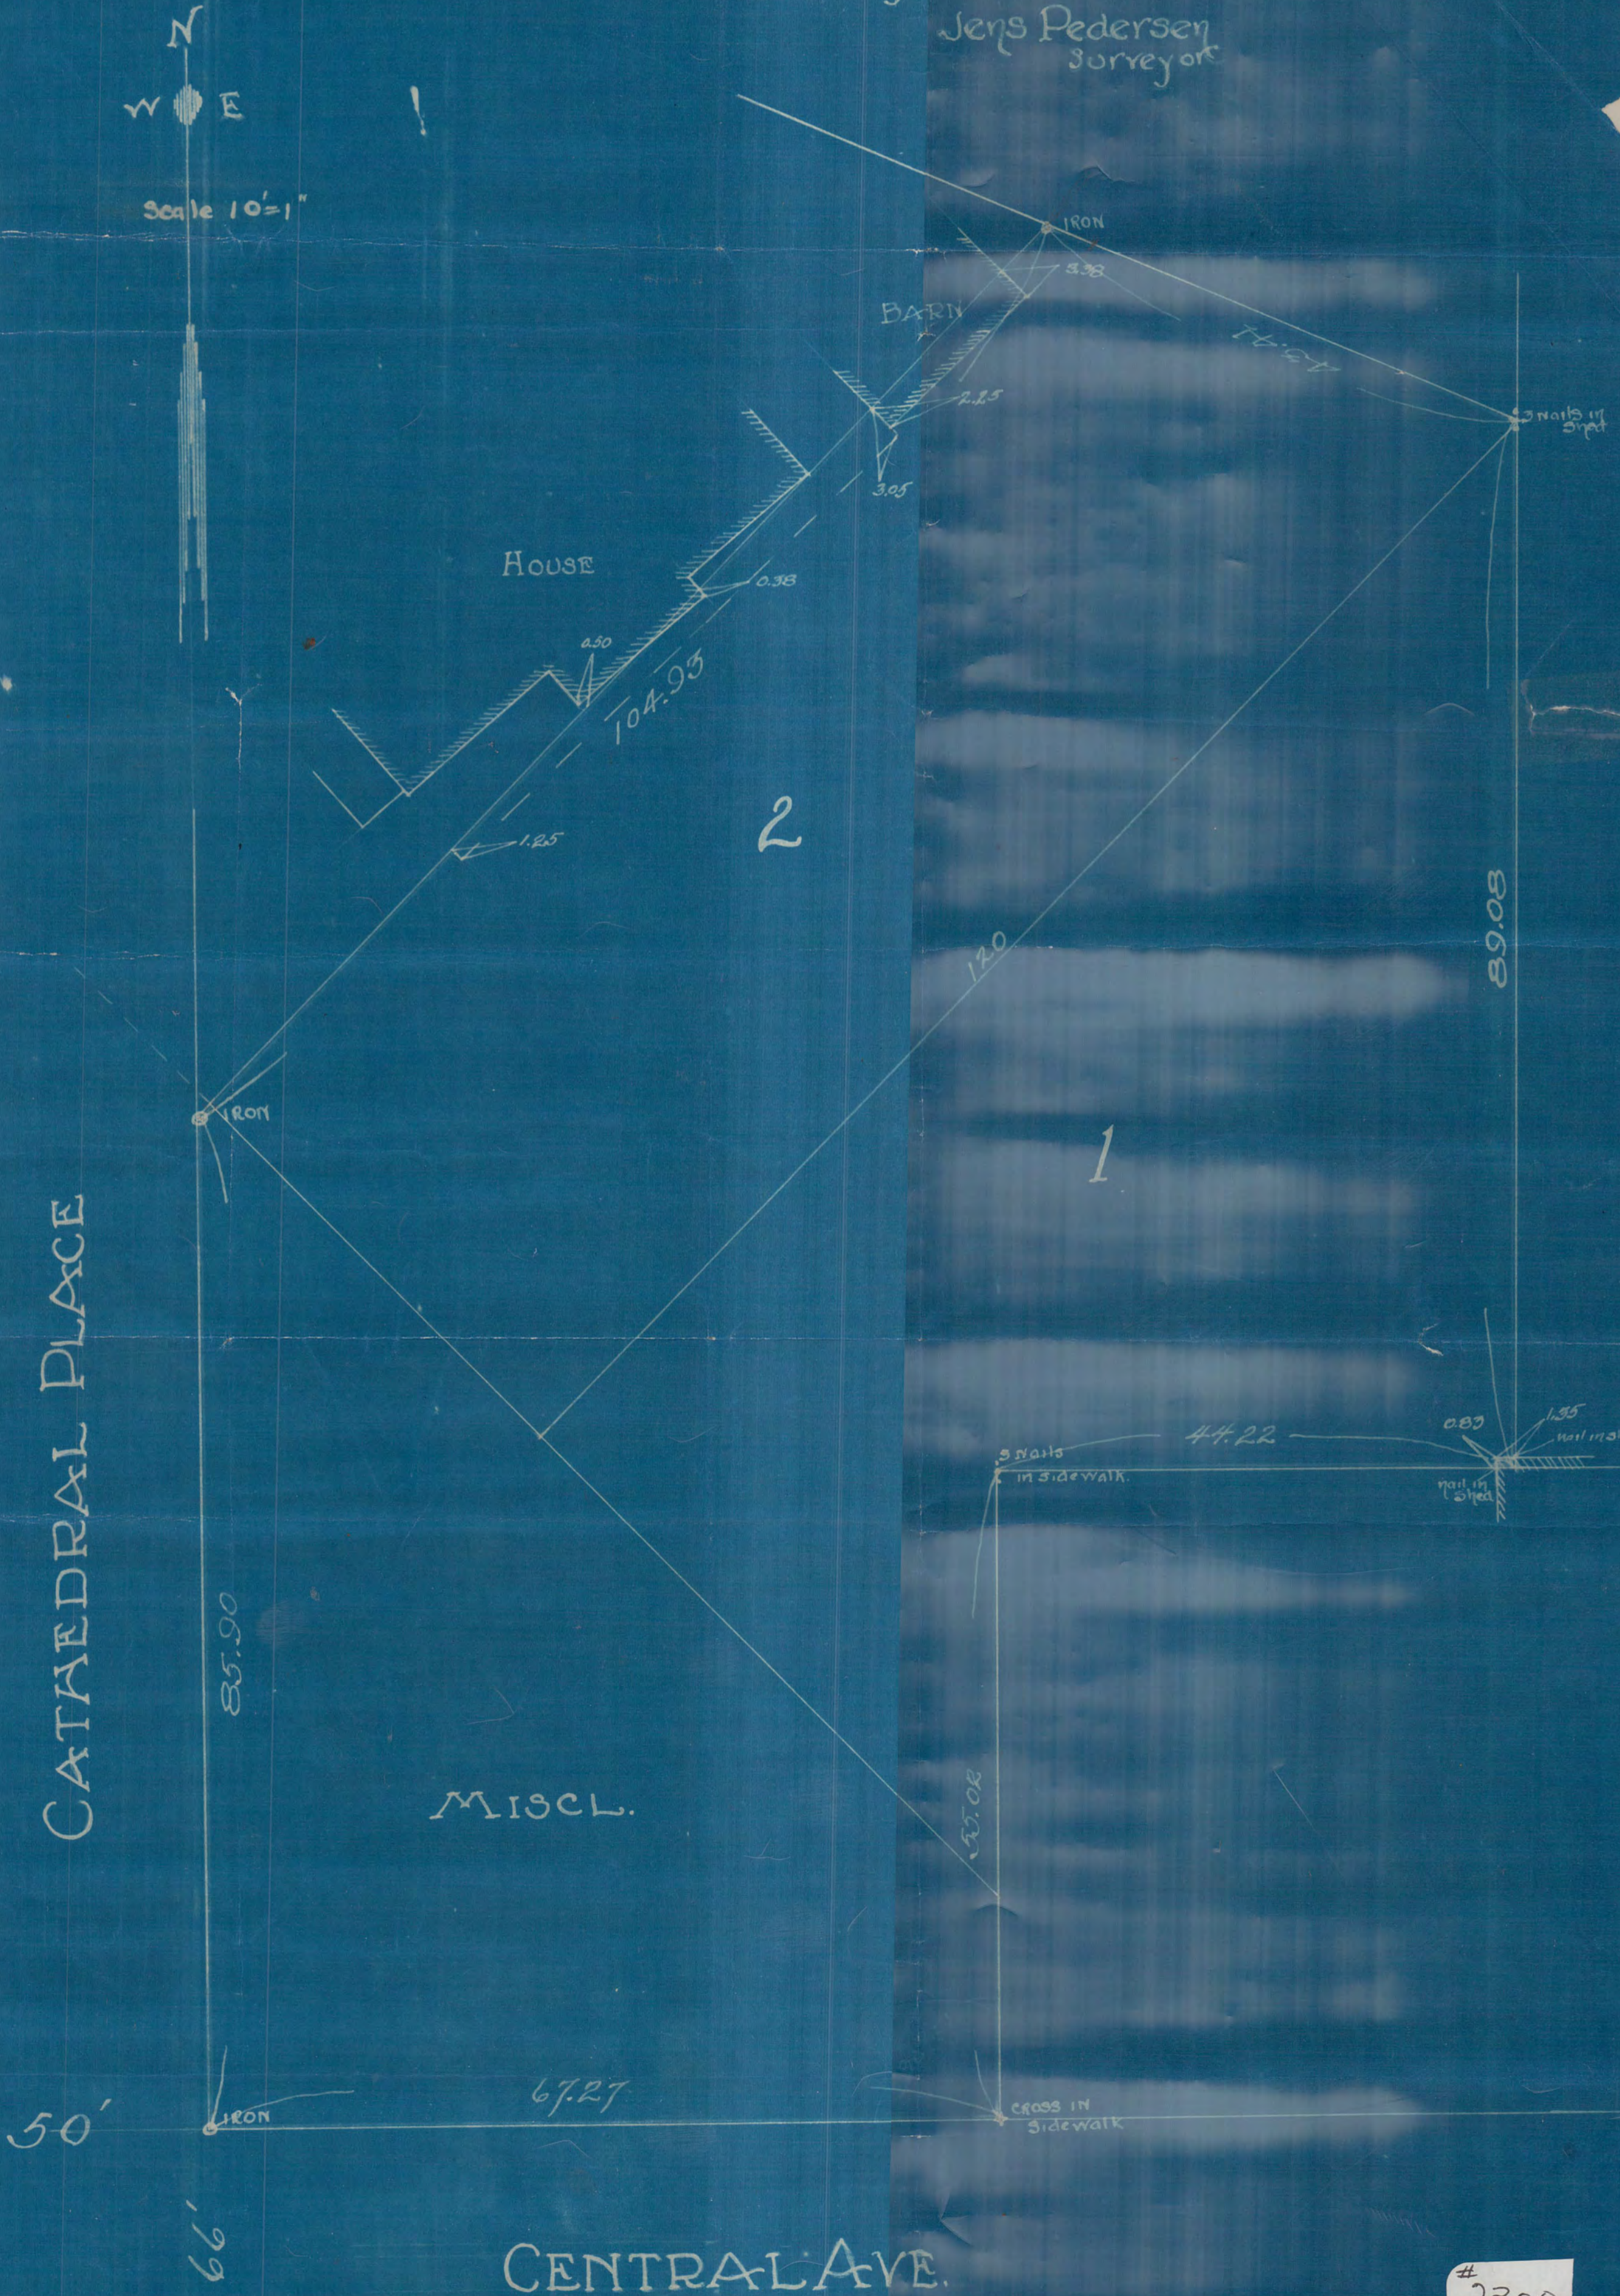

2300