

JOSEPH R. WEIDES 5TH ADD.

SURVEY OF
LOT 10 AND $\frac{1}{2}$ OF LOT 11 BLK 2


APR 10-1919

JENS PEDERSEN
SURY.

SCALE 20' = 1"

2348

ALLEY 9

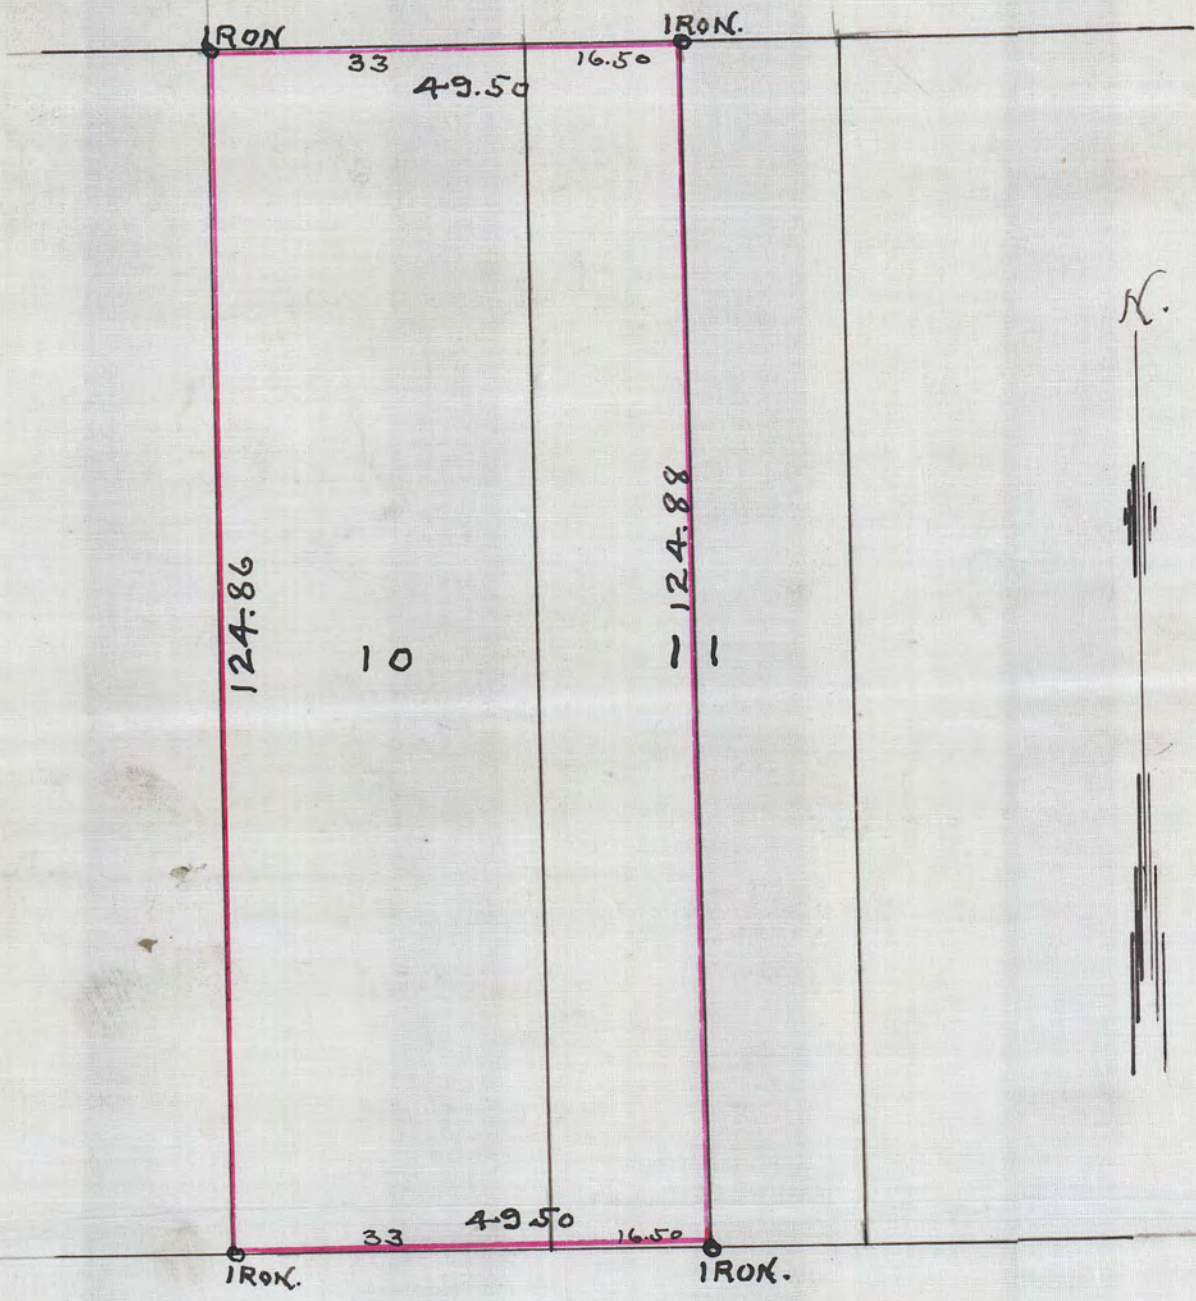

THOMAS ST.

2348