MILHAM PARK

SURVEY OF

LOTS 9 AND 10 BLK 1

NOV. 20-1919 JENS PEDERSEN SURV.

SCALE 20'=1"

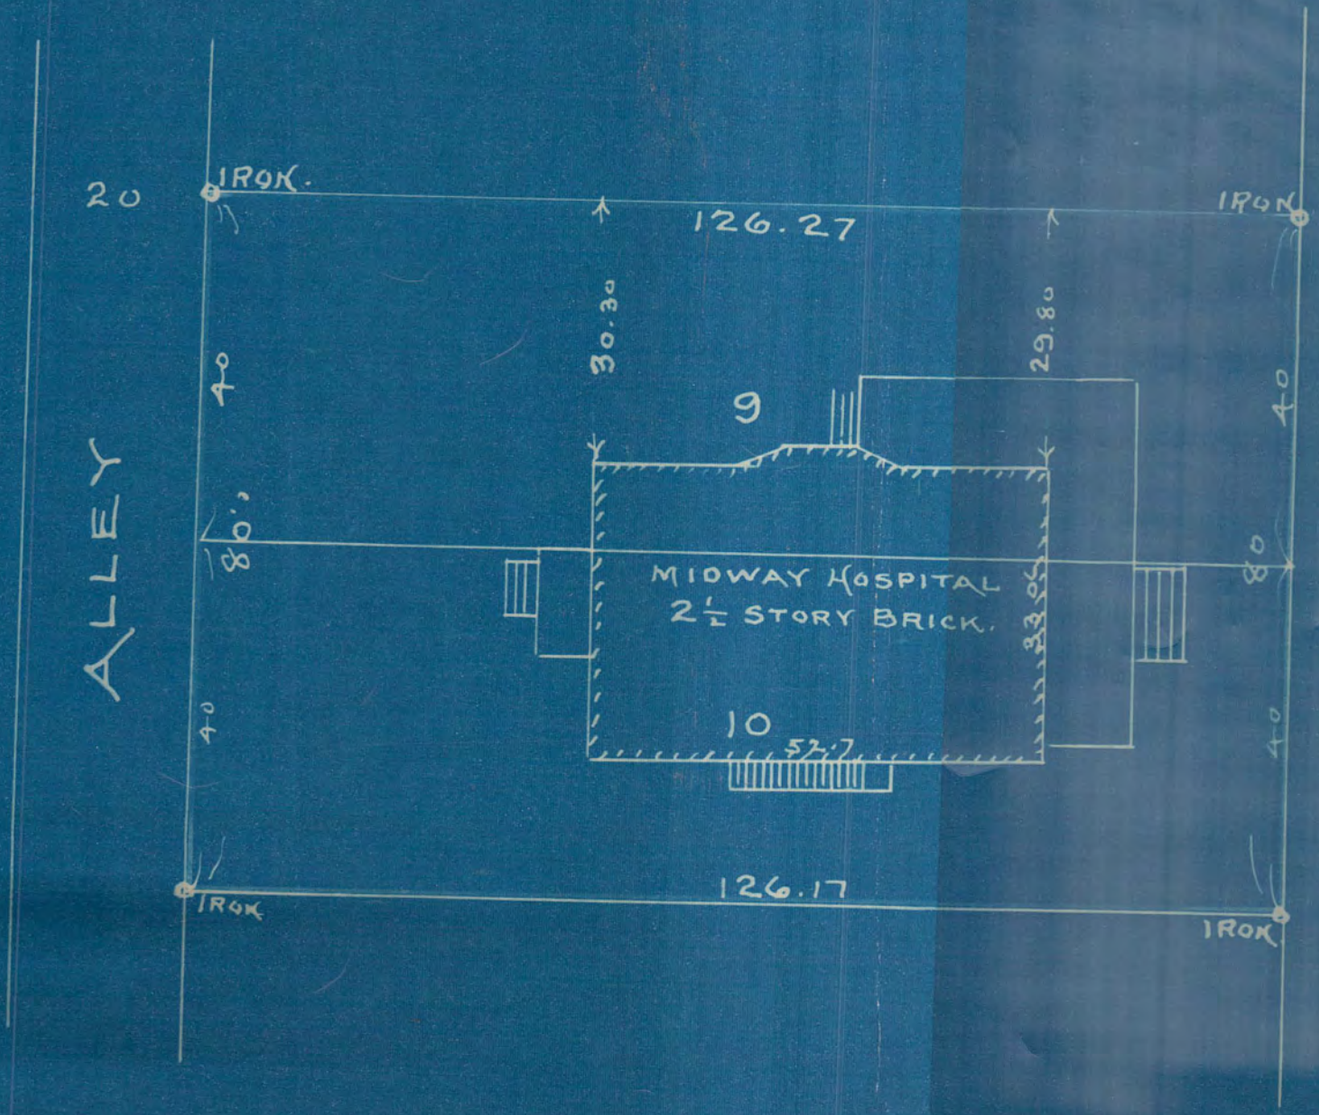

2433

2433