

2485

MERRIAM'S RE-AR.

SURVEY OF

W. 31 FT. OF E. 38 FT. OF LOT 4, BLK. 27.

APR., 13, 1920.

JENS PEDERSEN

SURVEYOR.

SCALE 1"=20'

DISTRICT COURT

JUDICIAL DISTRICT.

* *


County, Administrator
under the title
Ramsey County,

8 feet of Lot
26, 27, 28 and
roof on file
in and for

IGLEHART

ST.

EXHIBIT
A

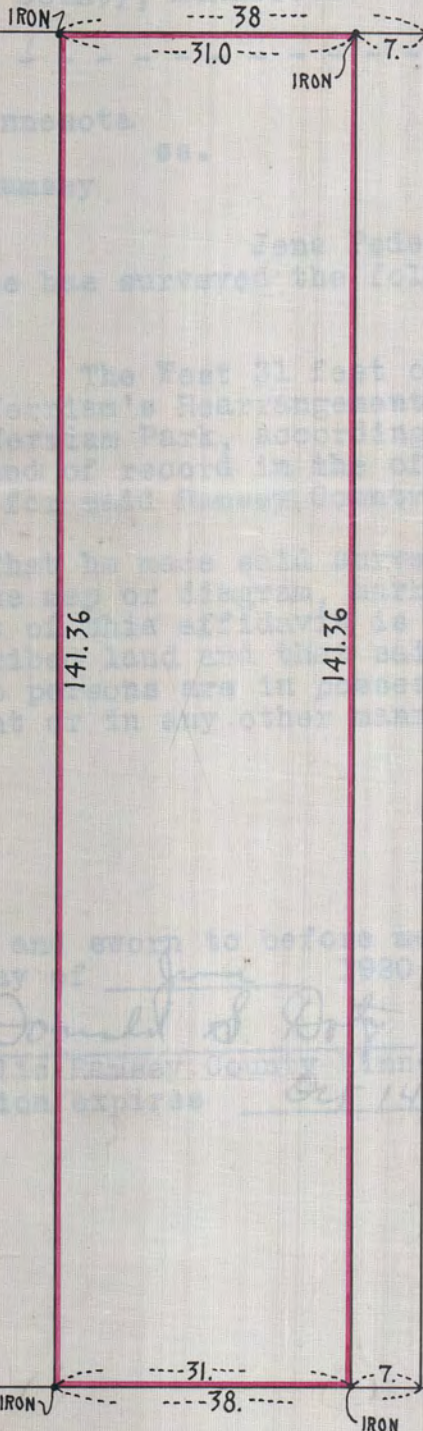

Jens Pedersen, being duly sworn makes oath and
and in Ramsey County

of Lot 4, Block 27
26, 27, 28 and 29
that thereof on file
of Deeds in and

of April 1920
attached hereto and
diagram of said
by a dwelling house
this land by
of said house and

Jens Pedersen

Subscribed and sworn to before me
this 3rd day of June 1920

Donald S. [Signature]

Notary Public in Ramsey County, Minnesota
My commission expires Oct 14 1925

ALLEY

20'

2485