


AEURBACH & HAND'S ADD.
SURVEY OF
W. 1/2 OF E. 1/2 OF LOTS 8 & 9,
AUG., 16, 1920.

BLK. 33.
JENS PEDERSEN
SURVEYOR.

SCALE 1" = 20'

Joseph Fink

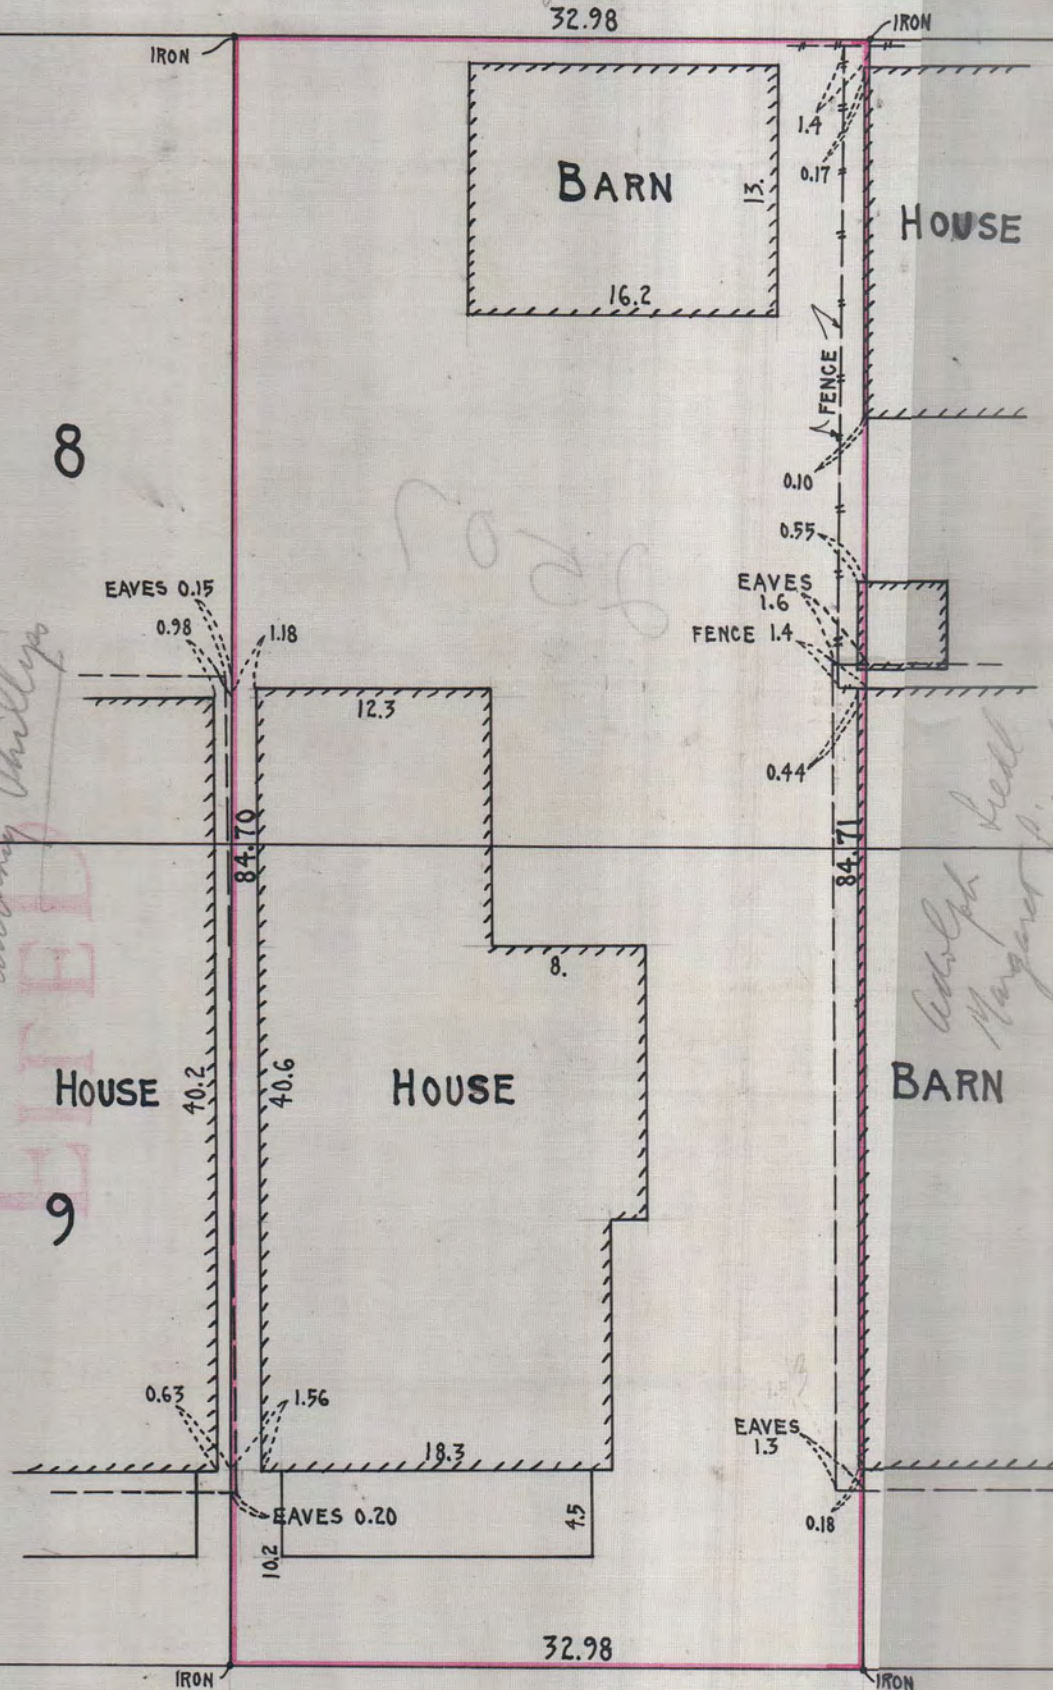

AVE.



LAWSON

ST.

2507.