

ST. ANTHONY PARK

SURVEY OF

LOTS 15 TO 19, INCL.,
Nov., 9, 1920.

BLK. 80.
JENS PEDERSEN
SURVEYOR.

SCALE 1"=20'

HAMPDEN

AVE.

ST.

BRADFORD

-----274.3-----

-----274.3-----

ALLEY

20.

IRON

IRON

IRON

IRON

54.9

"

"

54.9

54.7

19

18

17

16

15

139.9

139.9

54.9

"

"


54.9

54.7

9168

Handwritten notes:
19
18
17
16
15

Red stamp:
RECORDED
DEC 15 1920

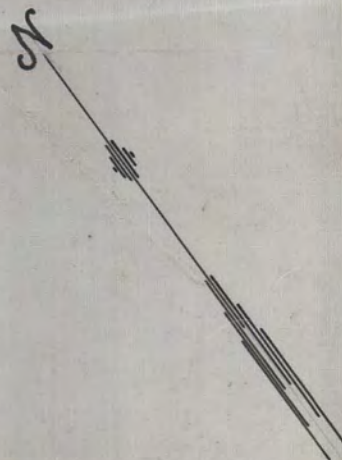

2517