


N?

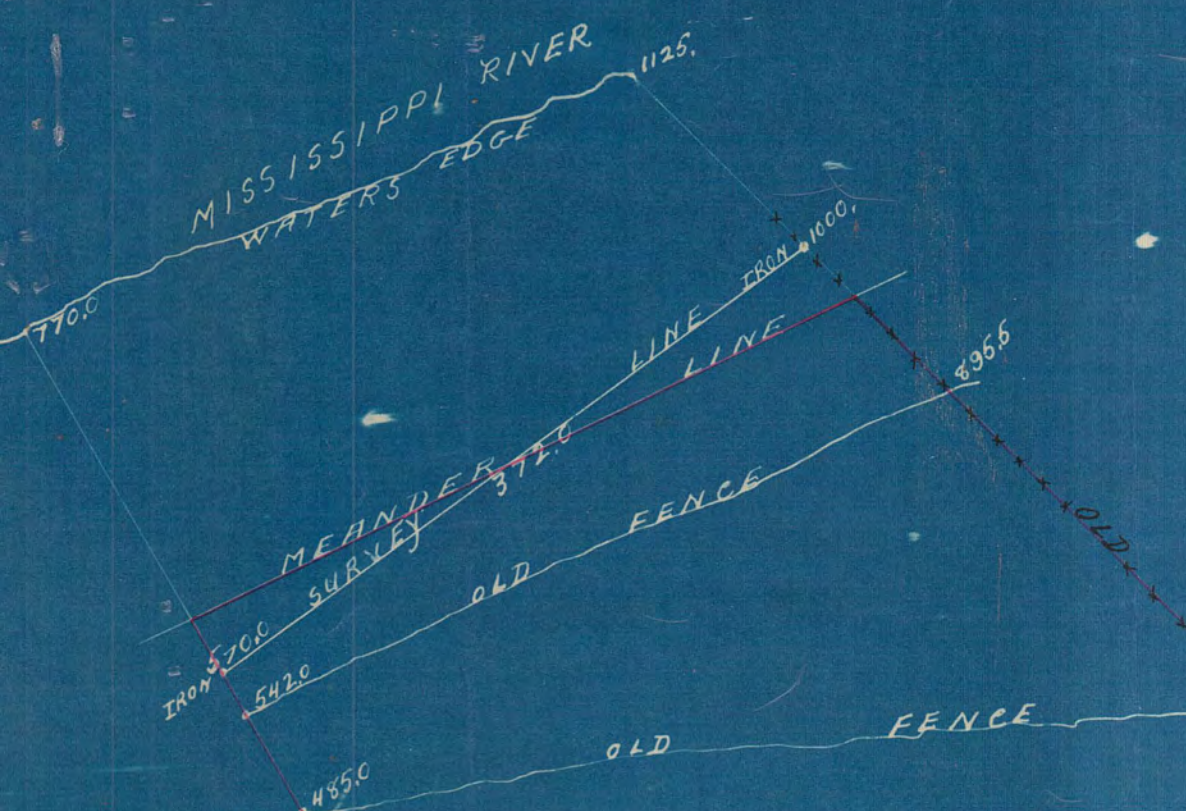

SCALE 100 FT. = 1-INCH  
7-18+19-1921

PART OF GOV. LOT 6 SECT. 12 T. 28 R. 23  
8 ACRES BETWEEN MEANDER LINES


I hereby certified to having surveyed  
the trace of land as shown on this  
map, and described as follows:

All that part of GOV LOT 6 SECT. 12 T. 28 R. 23  
lying between the easterly line of  
PICKEREL LAKE ADDITION to ST.  
PAUL, and the westerly line of  
the easterly fifteen acres  
of said GOV. LOT 6

FRANK J. TAVERNIER,  
Surveyor.

OFFICE 509  
COURT BLOCK  
ST. PAUL  
MINN.

PICKEREL LAKE  
ADD.

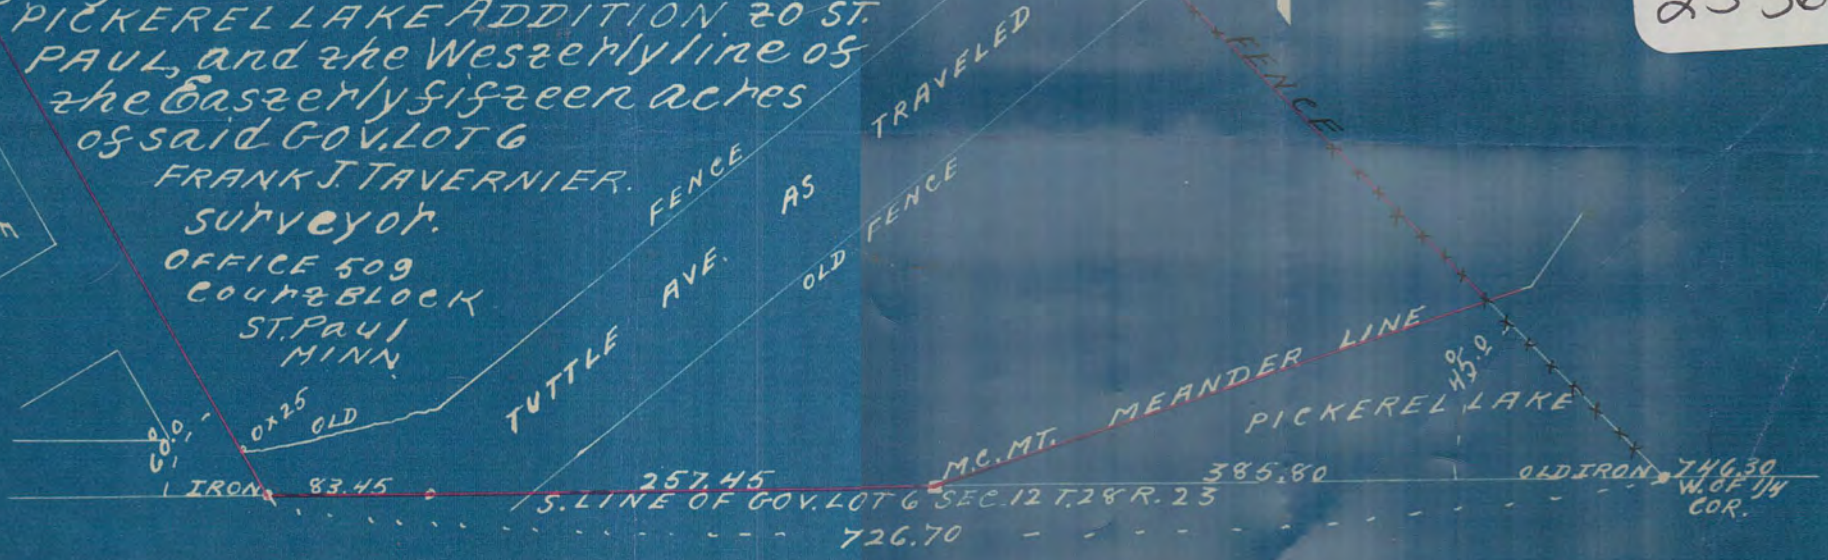

#  
2536