

SURVEY OF  
 LAND DESCRIBED IN APPLICATION IN FILE  
 DISTRICT COURT  
 FILE NO. 2570

ALSO PRIVATE ALLEYS AND OTHER LANDS ADJOINING SAME


OCT 28-1920

SCALE 20' = 1"

JENS PEDERSEN  
 SURV.

*Exhibit A*

CATHEDRAL PL.

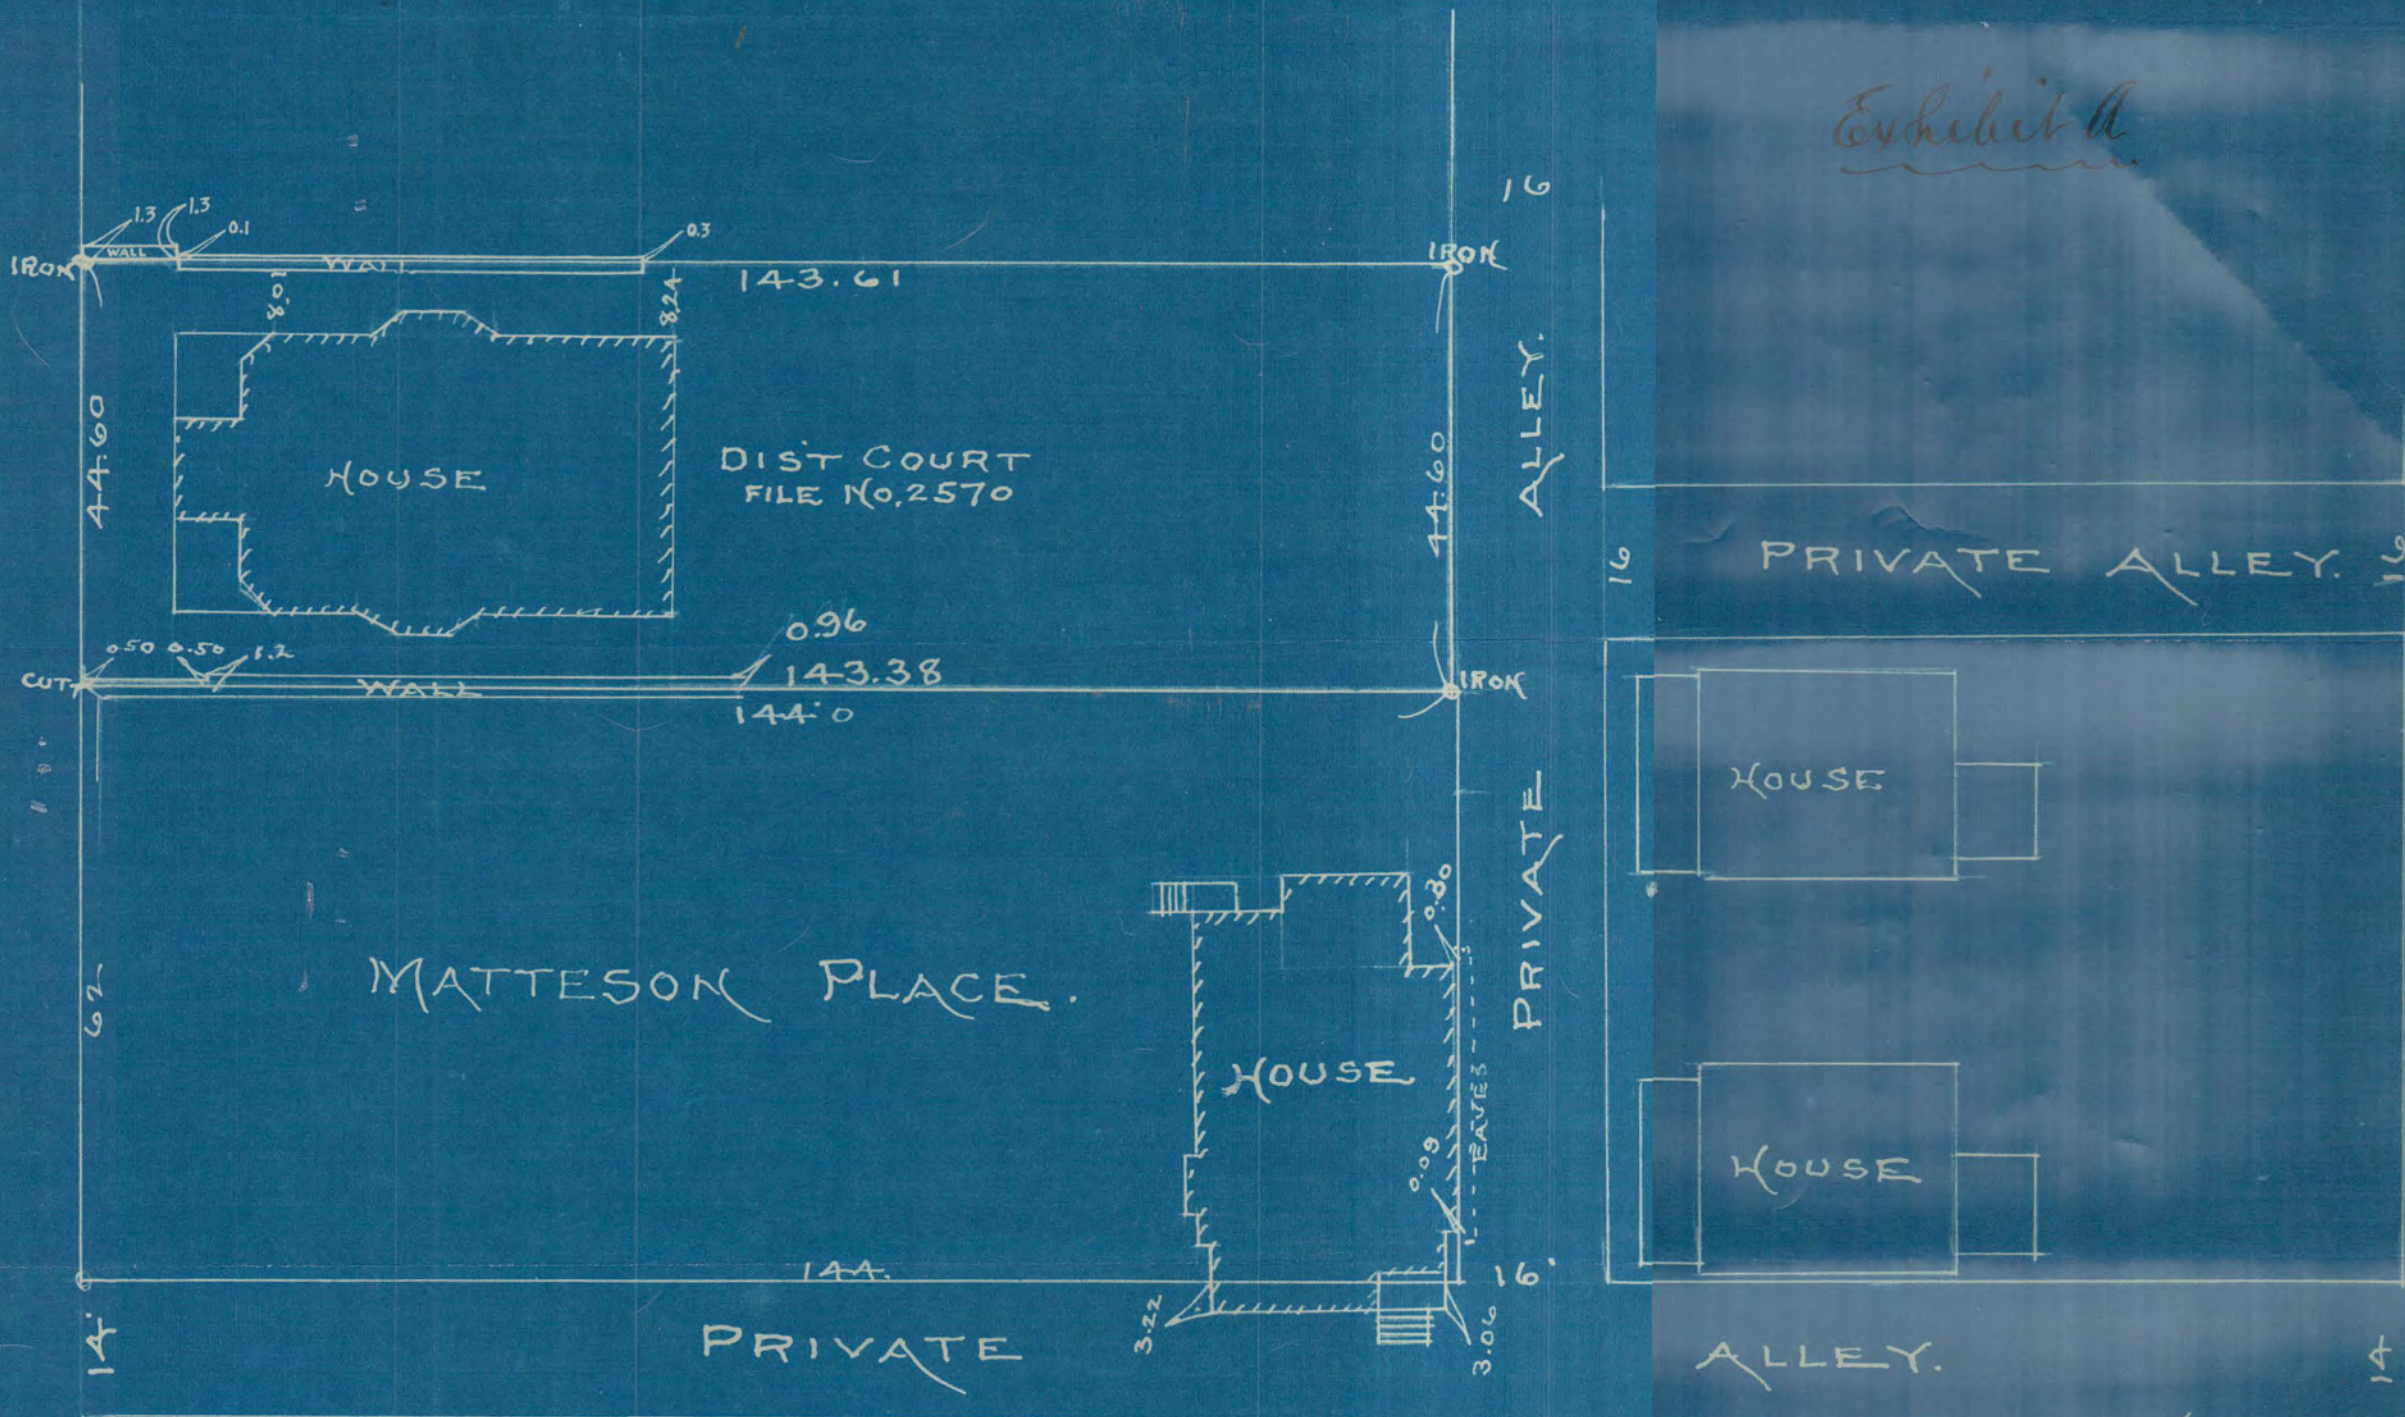


#  
 2570

IGLEHART STREET.

2570

SUMMIT PLACE.

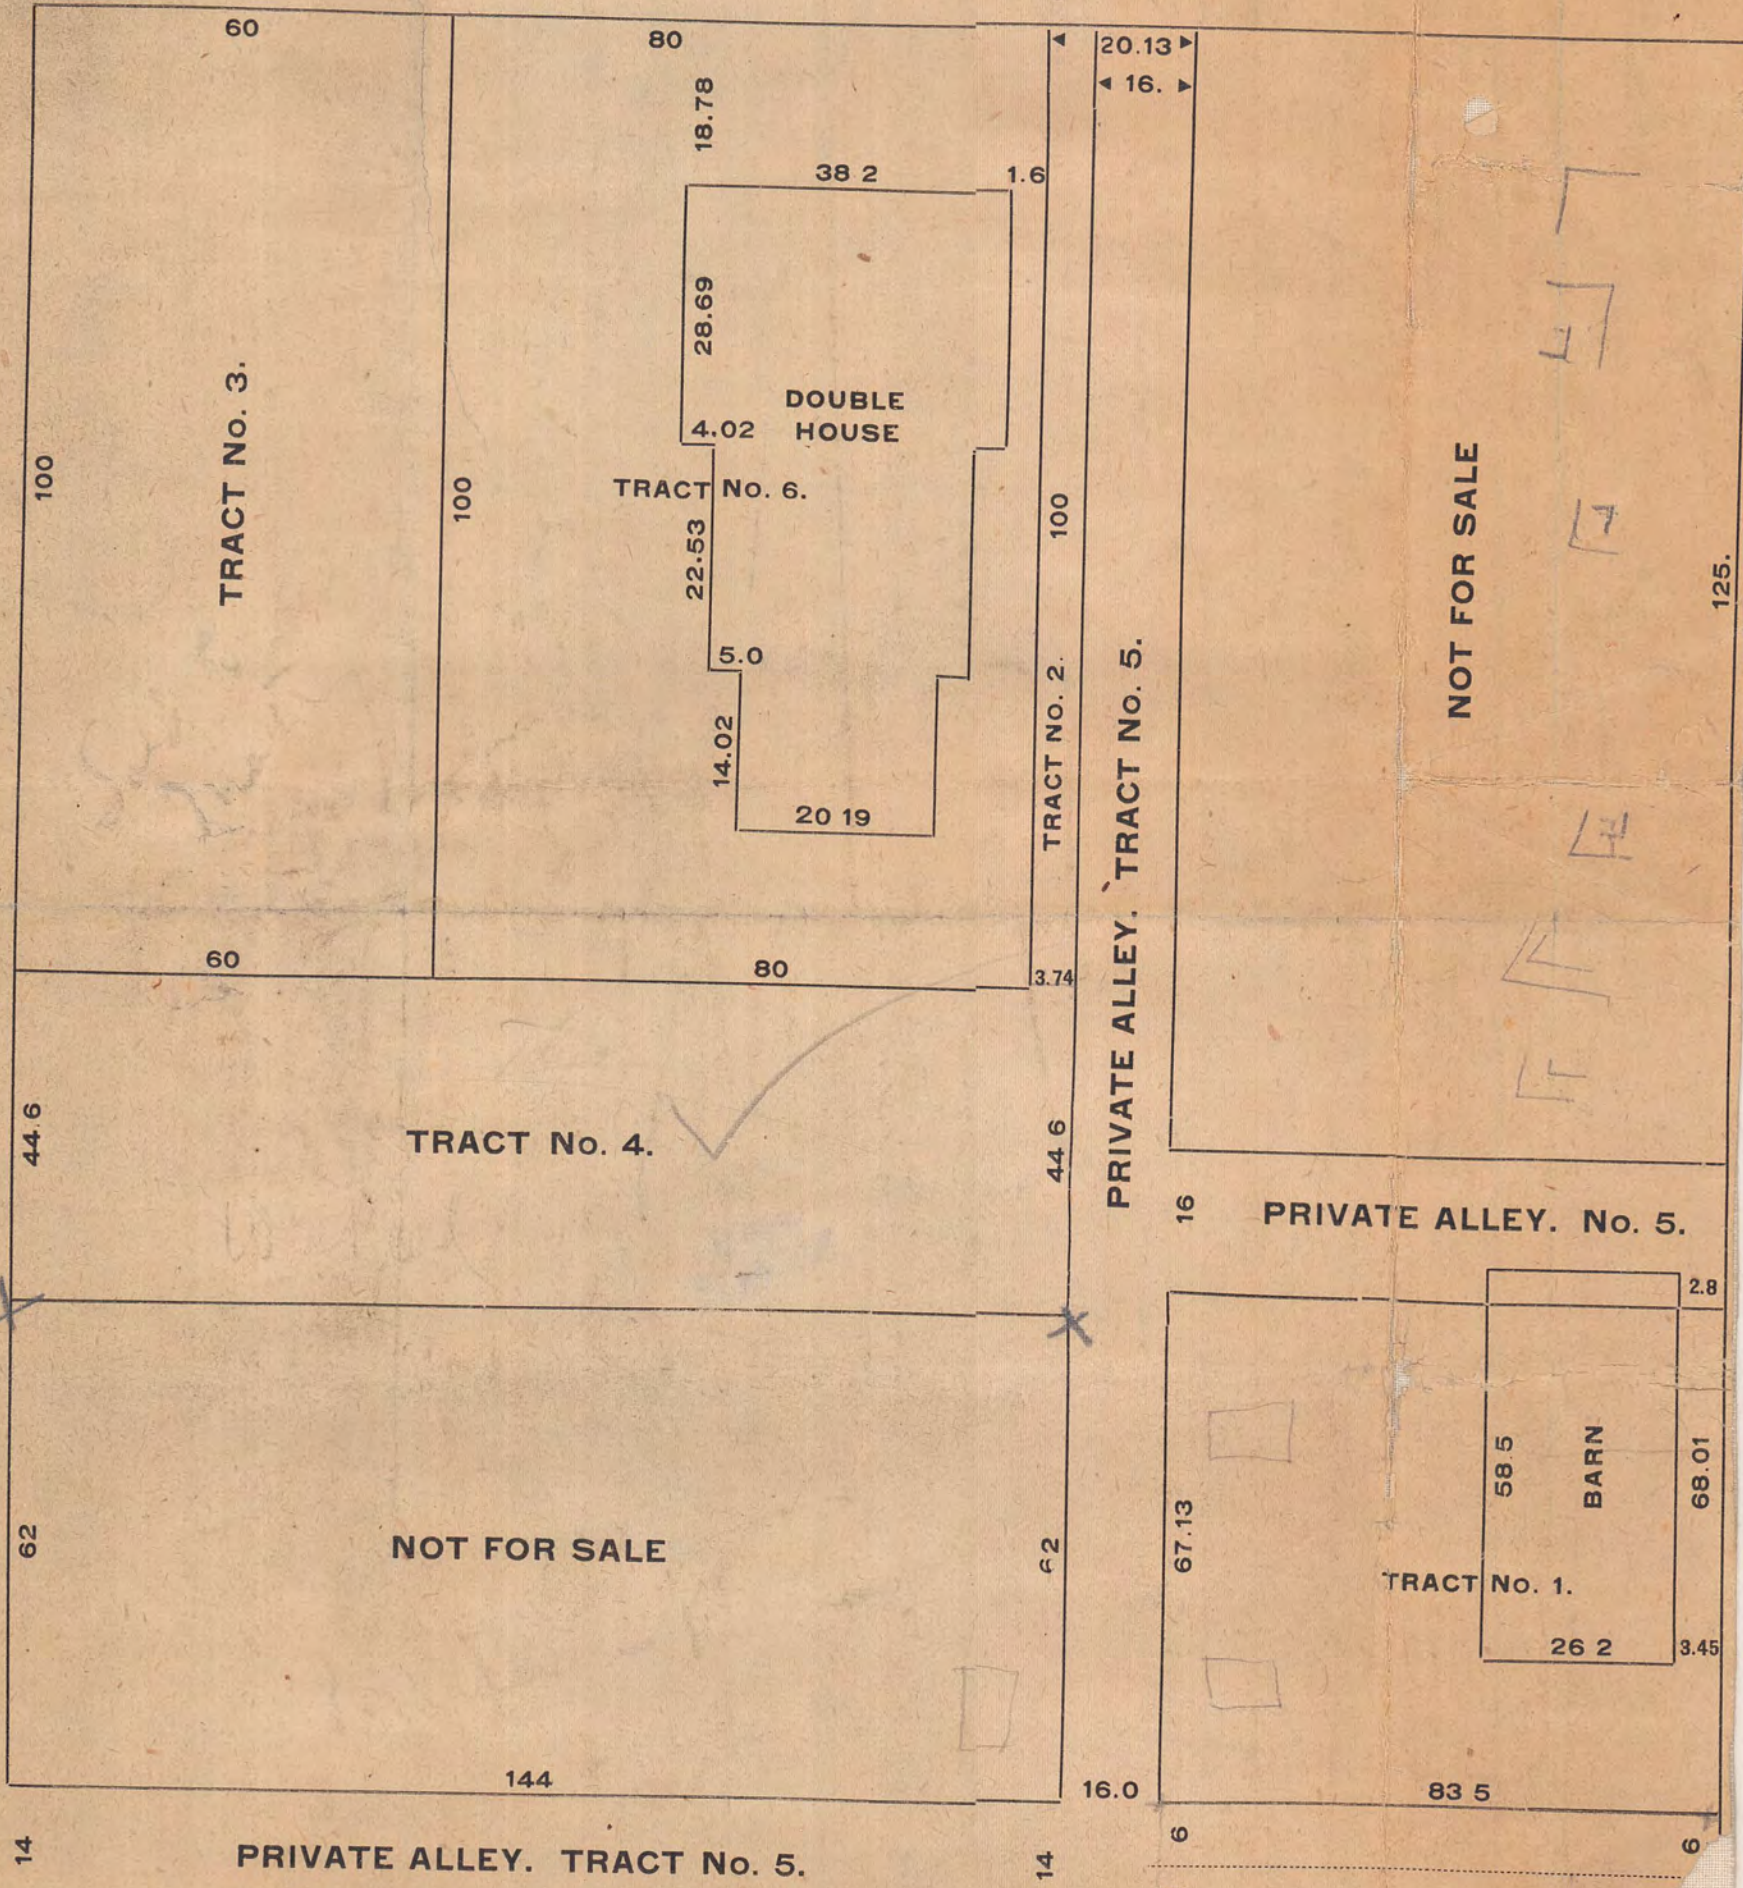

NOT FOR SALE

TRACT No. 4.

NOT FOR SALE

DOUBLE HOUSE

TRACT No. 1.

BARN

#2570