

AUDITORS SUB No. 31

SURVEY OF


LOTS 1 & 2

JUNE 30, 1921

BLK. 2

JENS PEDERSEN  
SURV.

SCALE 1"=20'

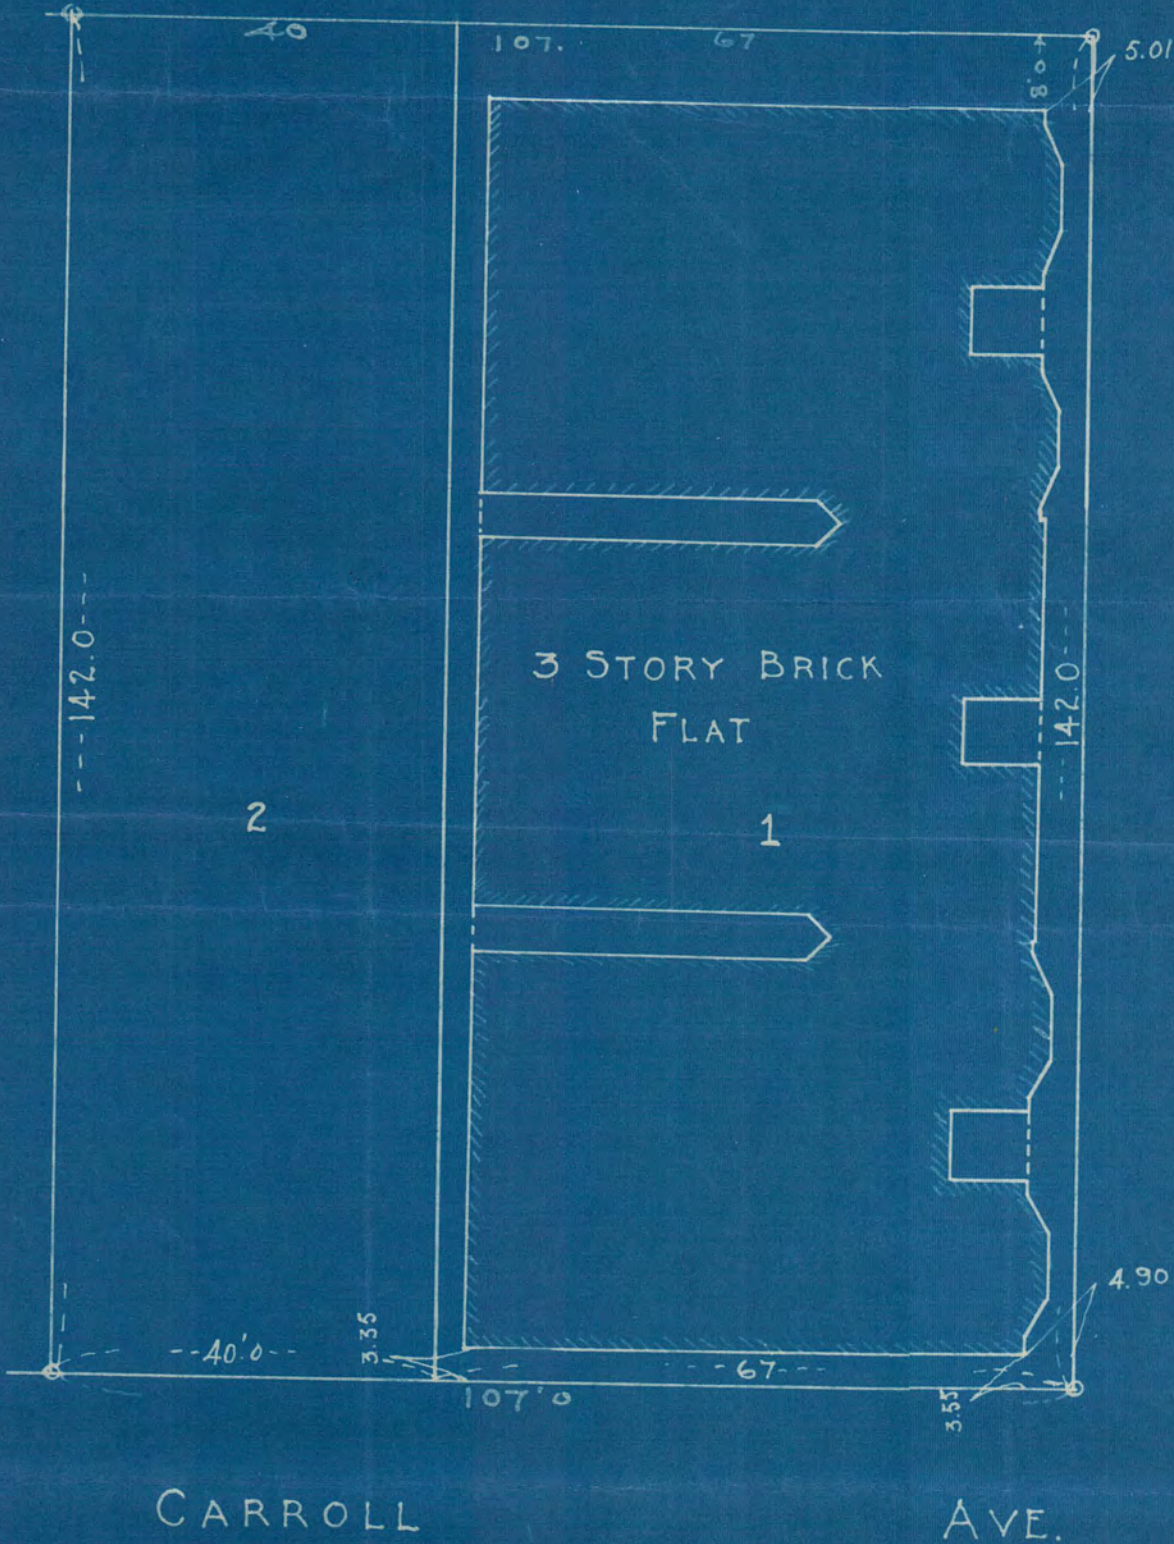

ST.

MACKUBIN

CARROLL

AVE.

#  
2574