


2584

E MINNESOTA ST.

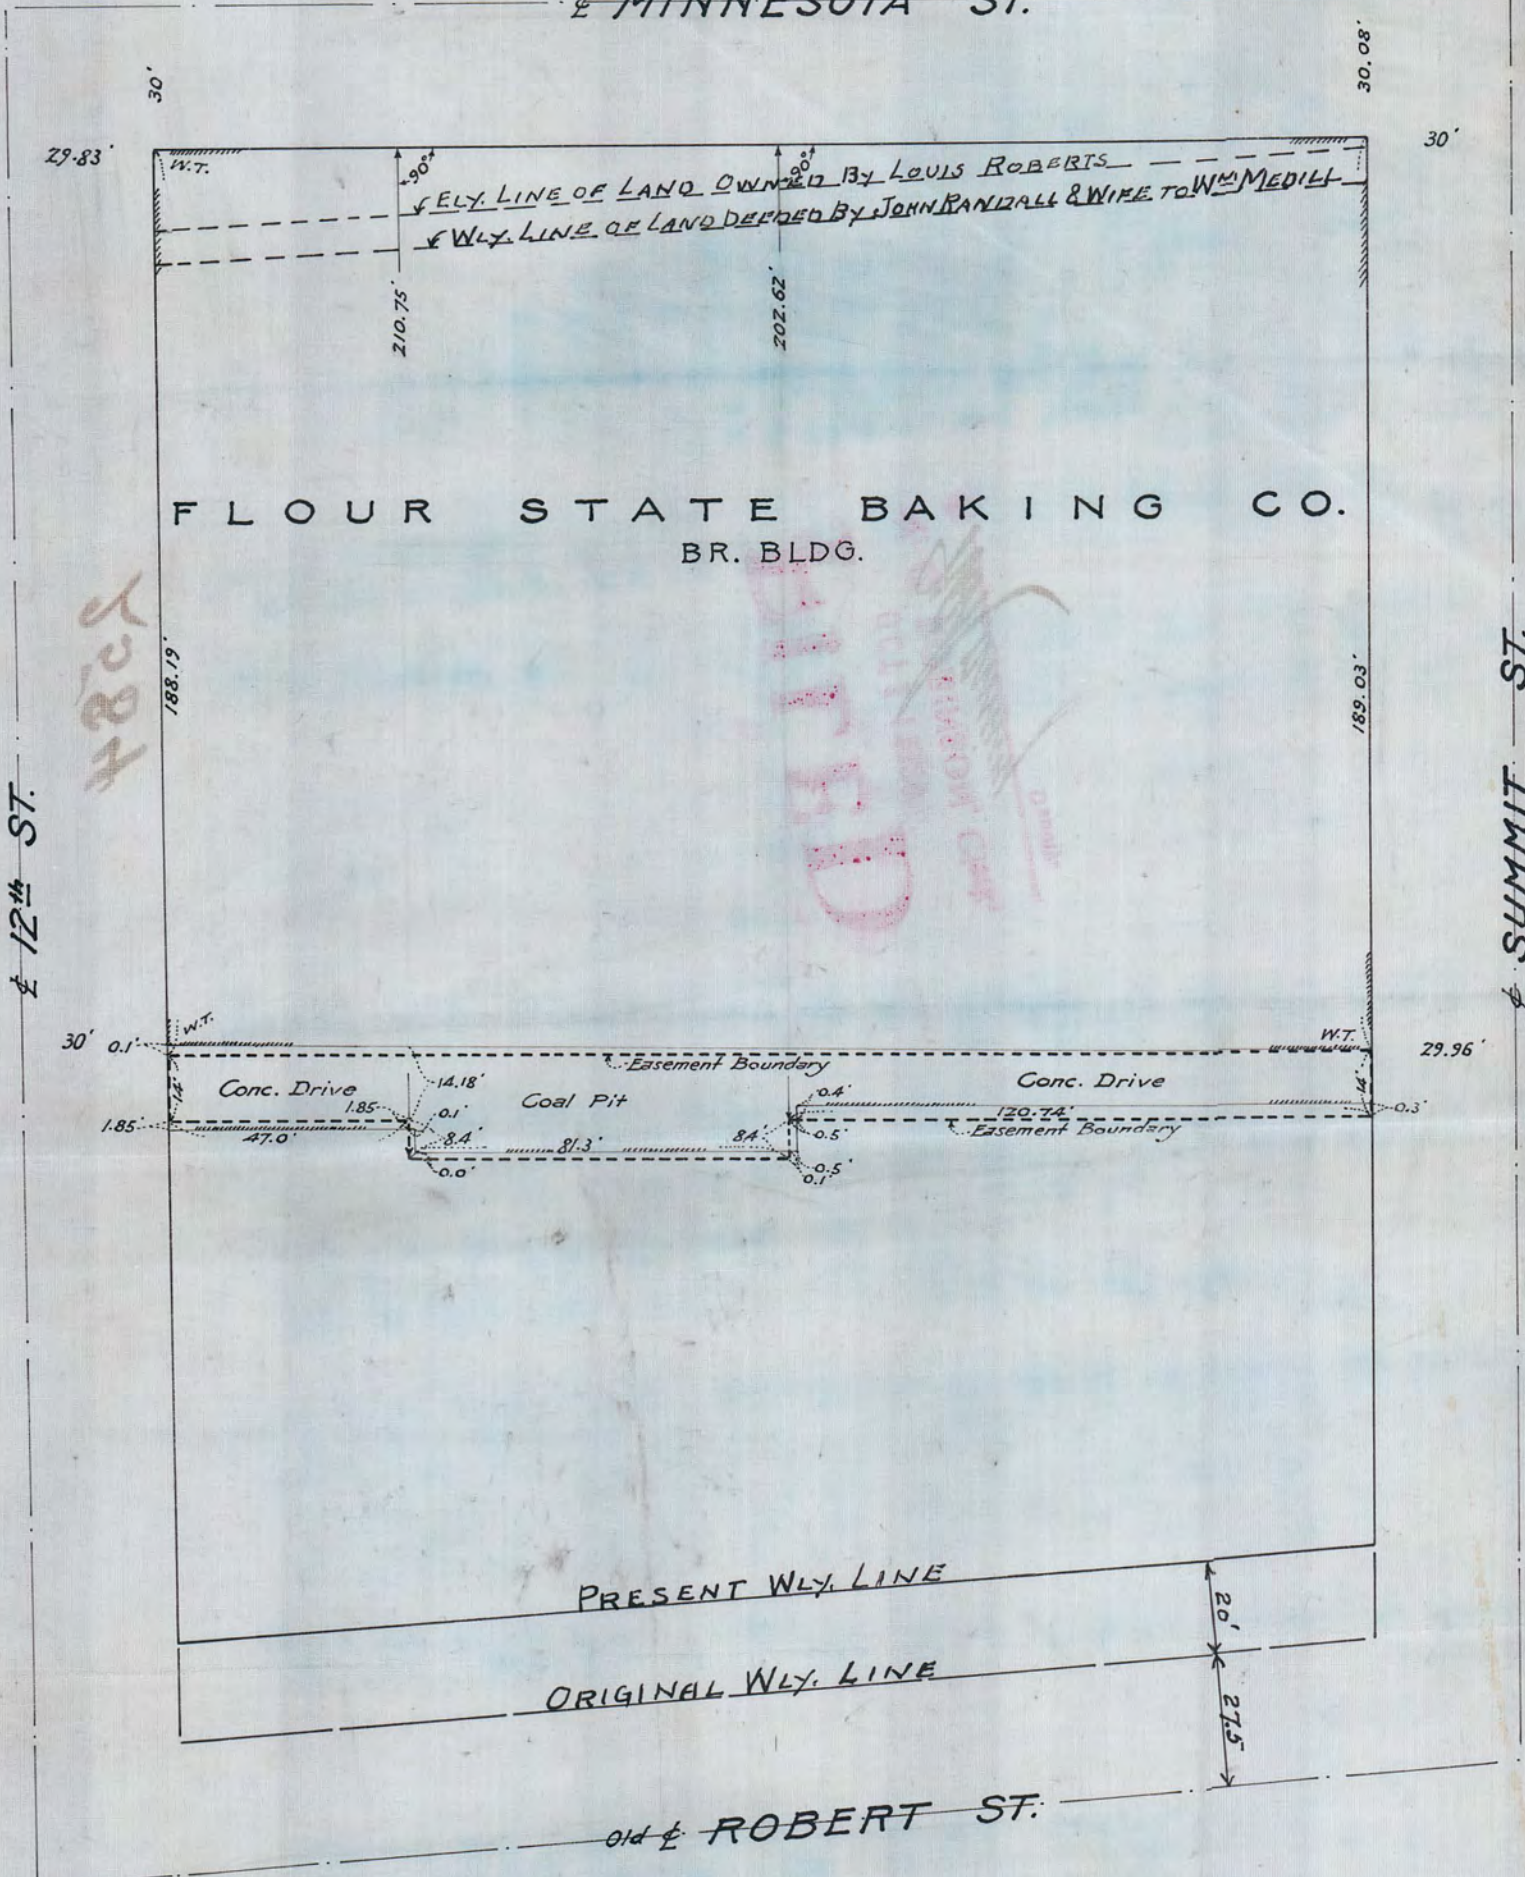

SURVEY OF
PART OF BLOCK 5, CENTRAL PARK

R·R·GODFREY, SURVEYOR

OCT. 2, 1920

Scale: 1"=40'

2584