

NININGER AND DONNELLY'S ADD.

SURVEY OF

LOT 10

BLK 1

NOV. 23-1920


JEKS PEDERSEN
SURV.

SCALE 10' = 1IN.

MARSHALL AVE

ST
AYON

AYON

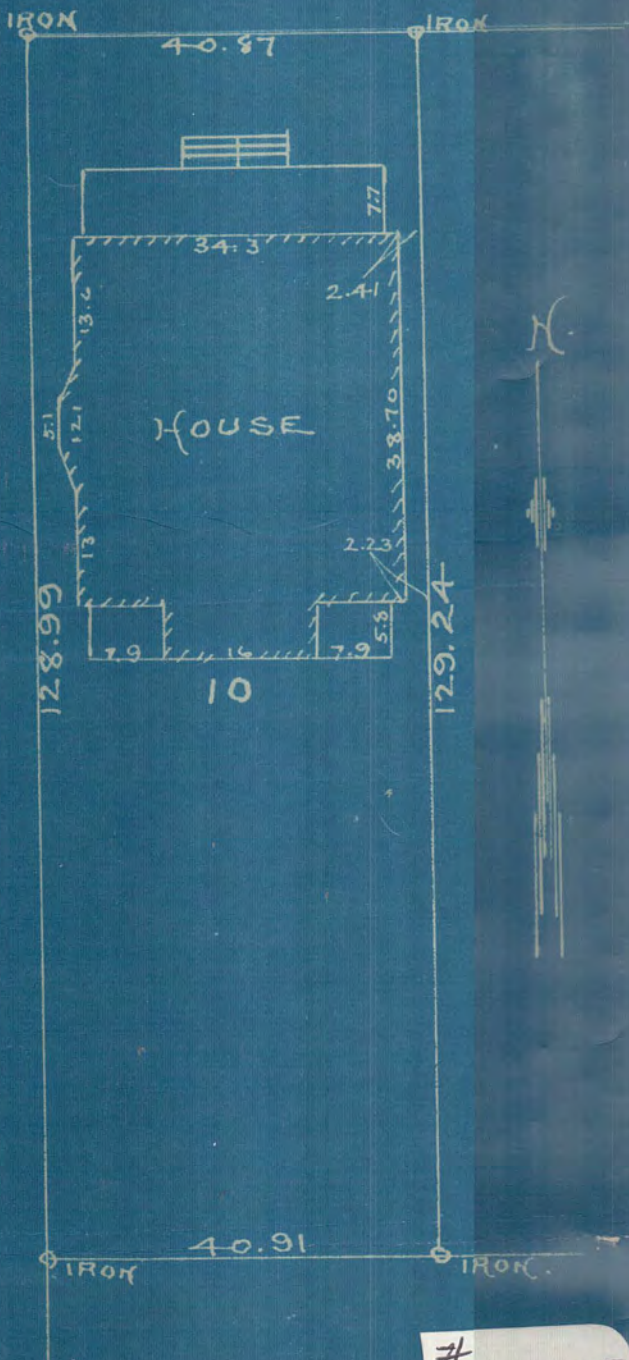

2588