


OTTO HOLMGREN

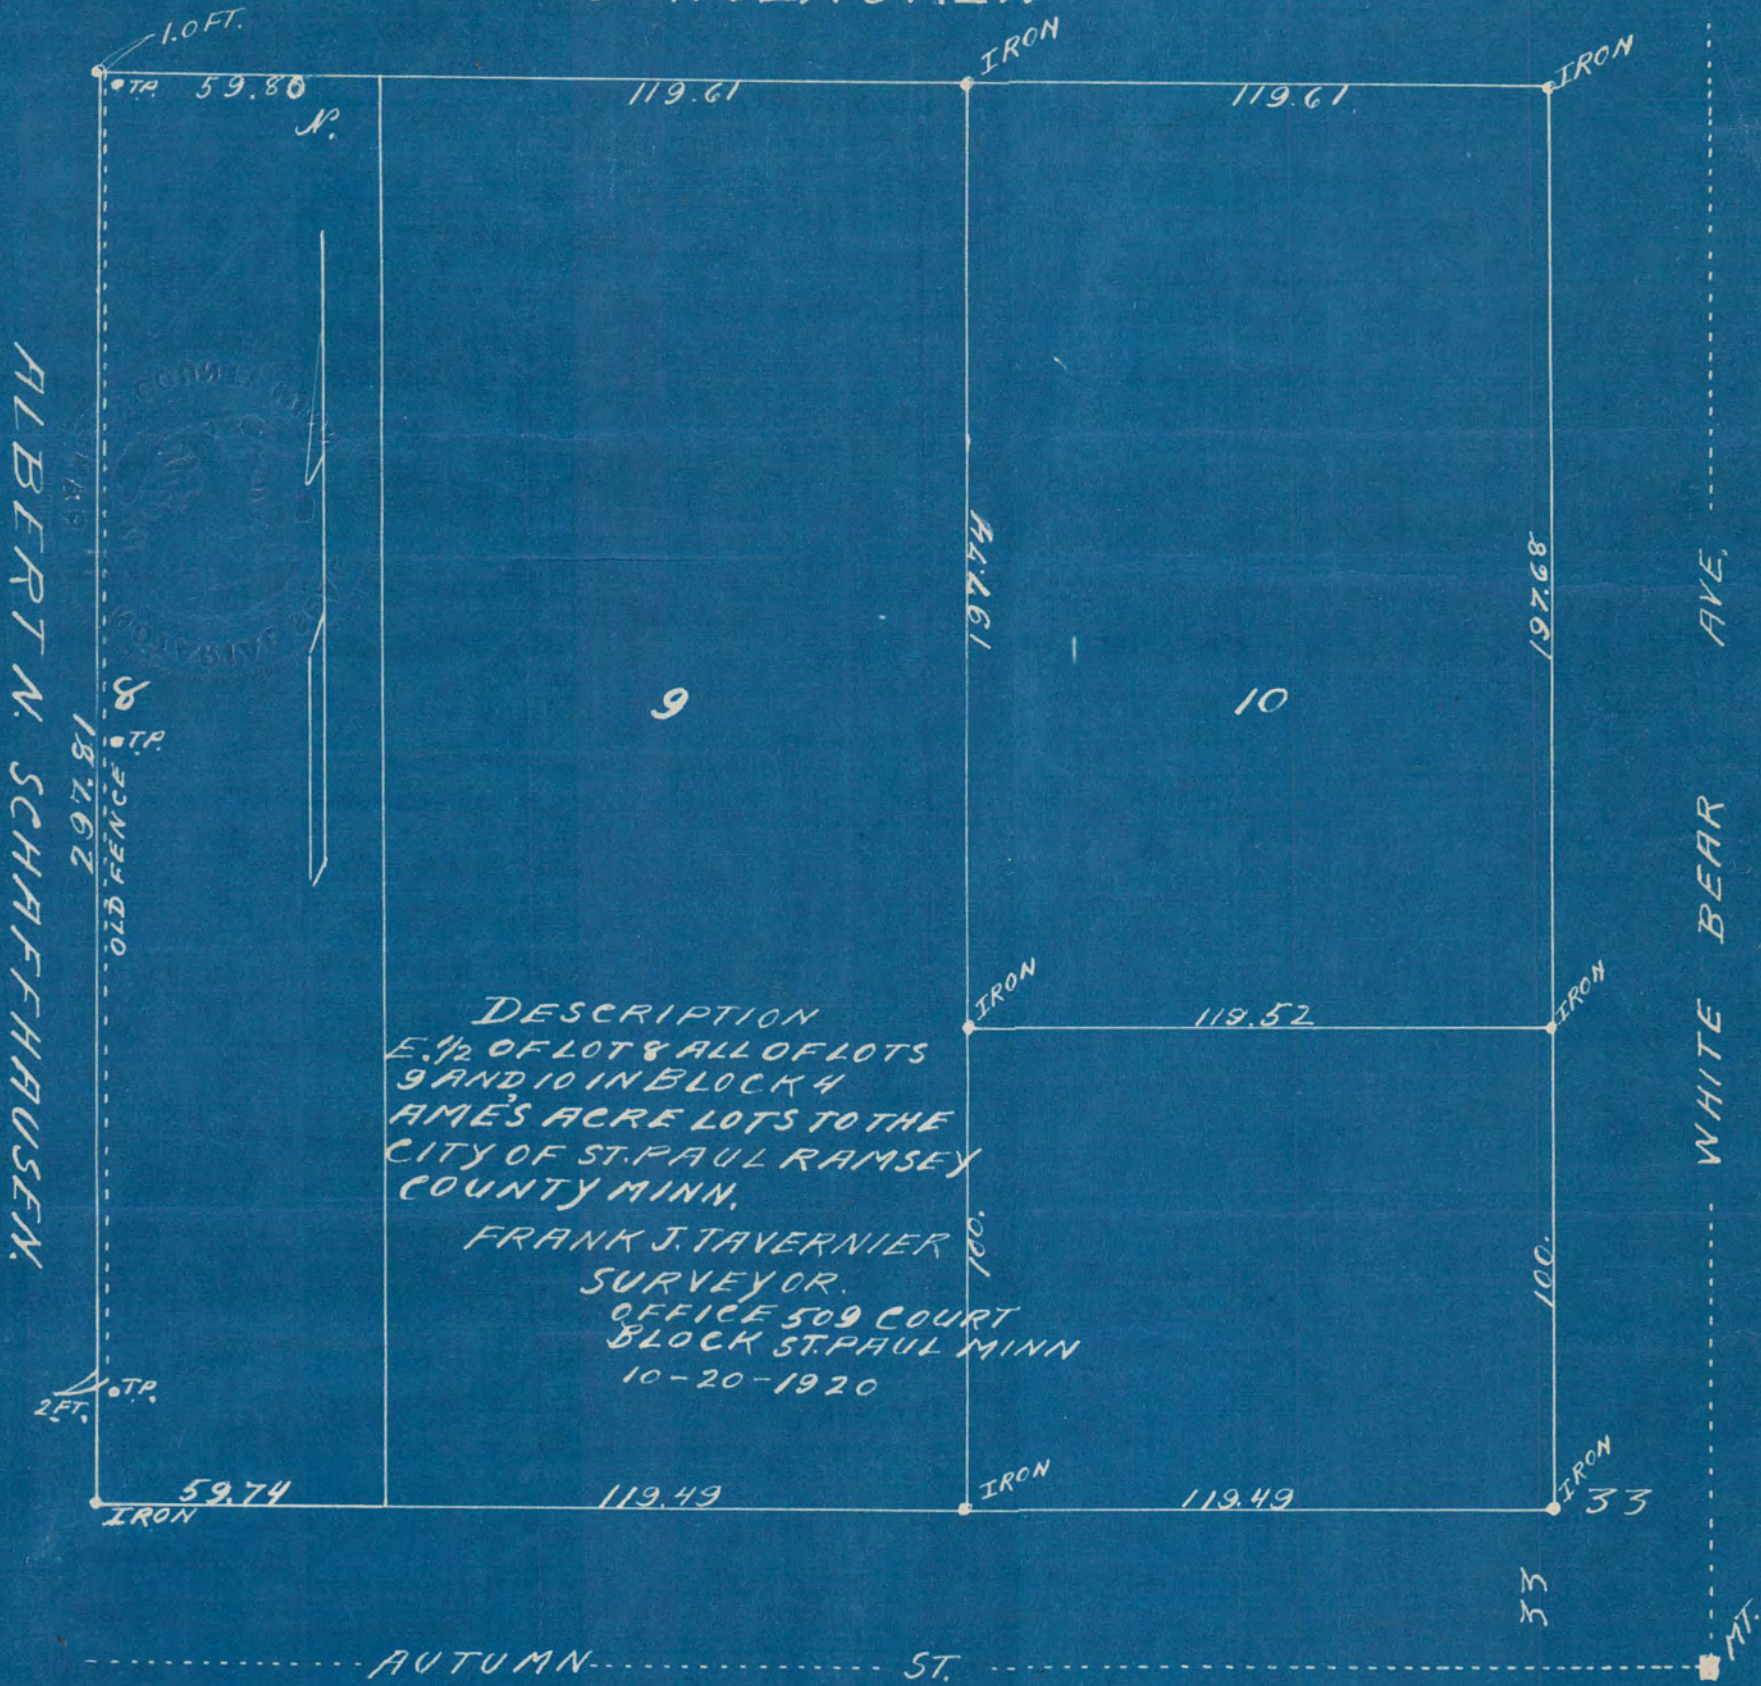

DESCRIPTION
 E. 1/2 OF LOT 8 AND OF LOTS
 9 AND 10 IN BLOCK 4
 AMES ACRE LOTS TO THE
 CITY OF ST. PAUL RAMSEY
 COUNTY MINN.

FRANK J. TAVERNIER
 SURVEYOR.
 OFFICE 509 COURT
 BLOCK ST. PAUL MINN
 10-20-1920

 2615
 x