


SURVEY OF

LOTS 3, 4 & 5; BLK. 47, WEST ST. PAUL PROPER, AND PART OF STATE ST. ADJACENT,
OR LOTS 3, 4 & 5; BLK. 2, BELL'S 2ND ADD., EXCEPT PART TAKEN FOR STATE ST.

Nov., 19, 1920.

JENS PEDERSEN
SURVEYOR.

SCALE 1"=10'

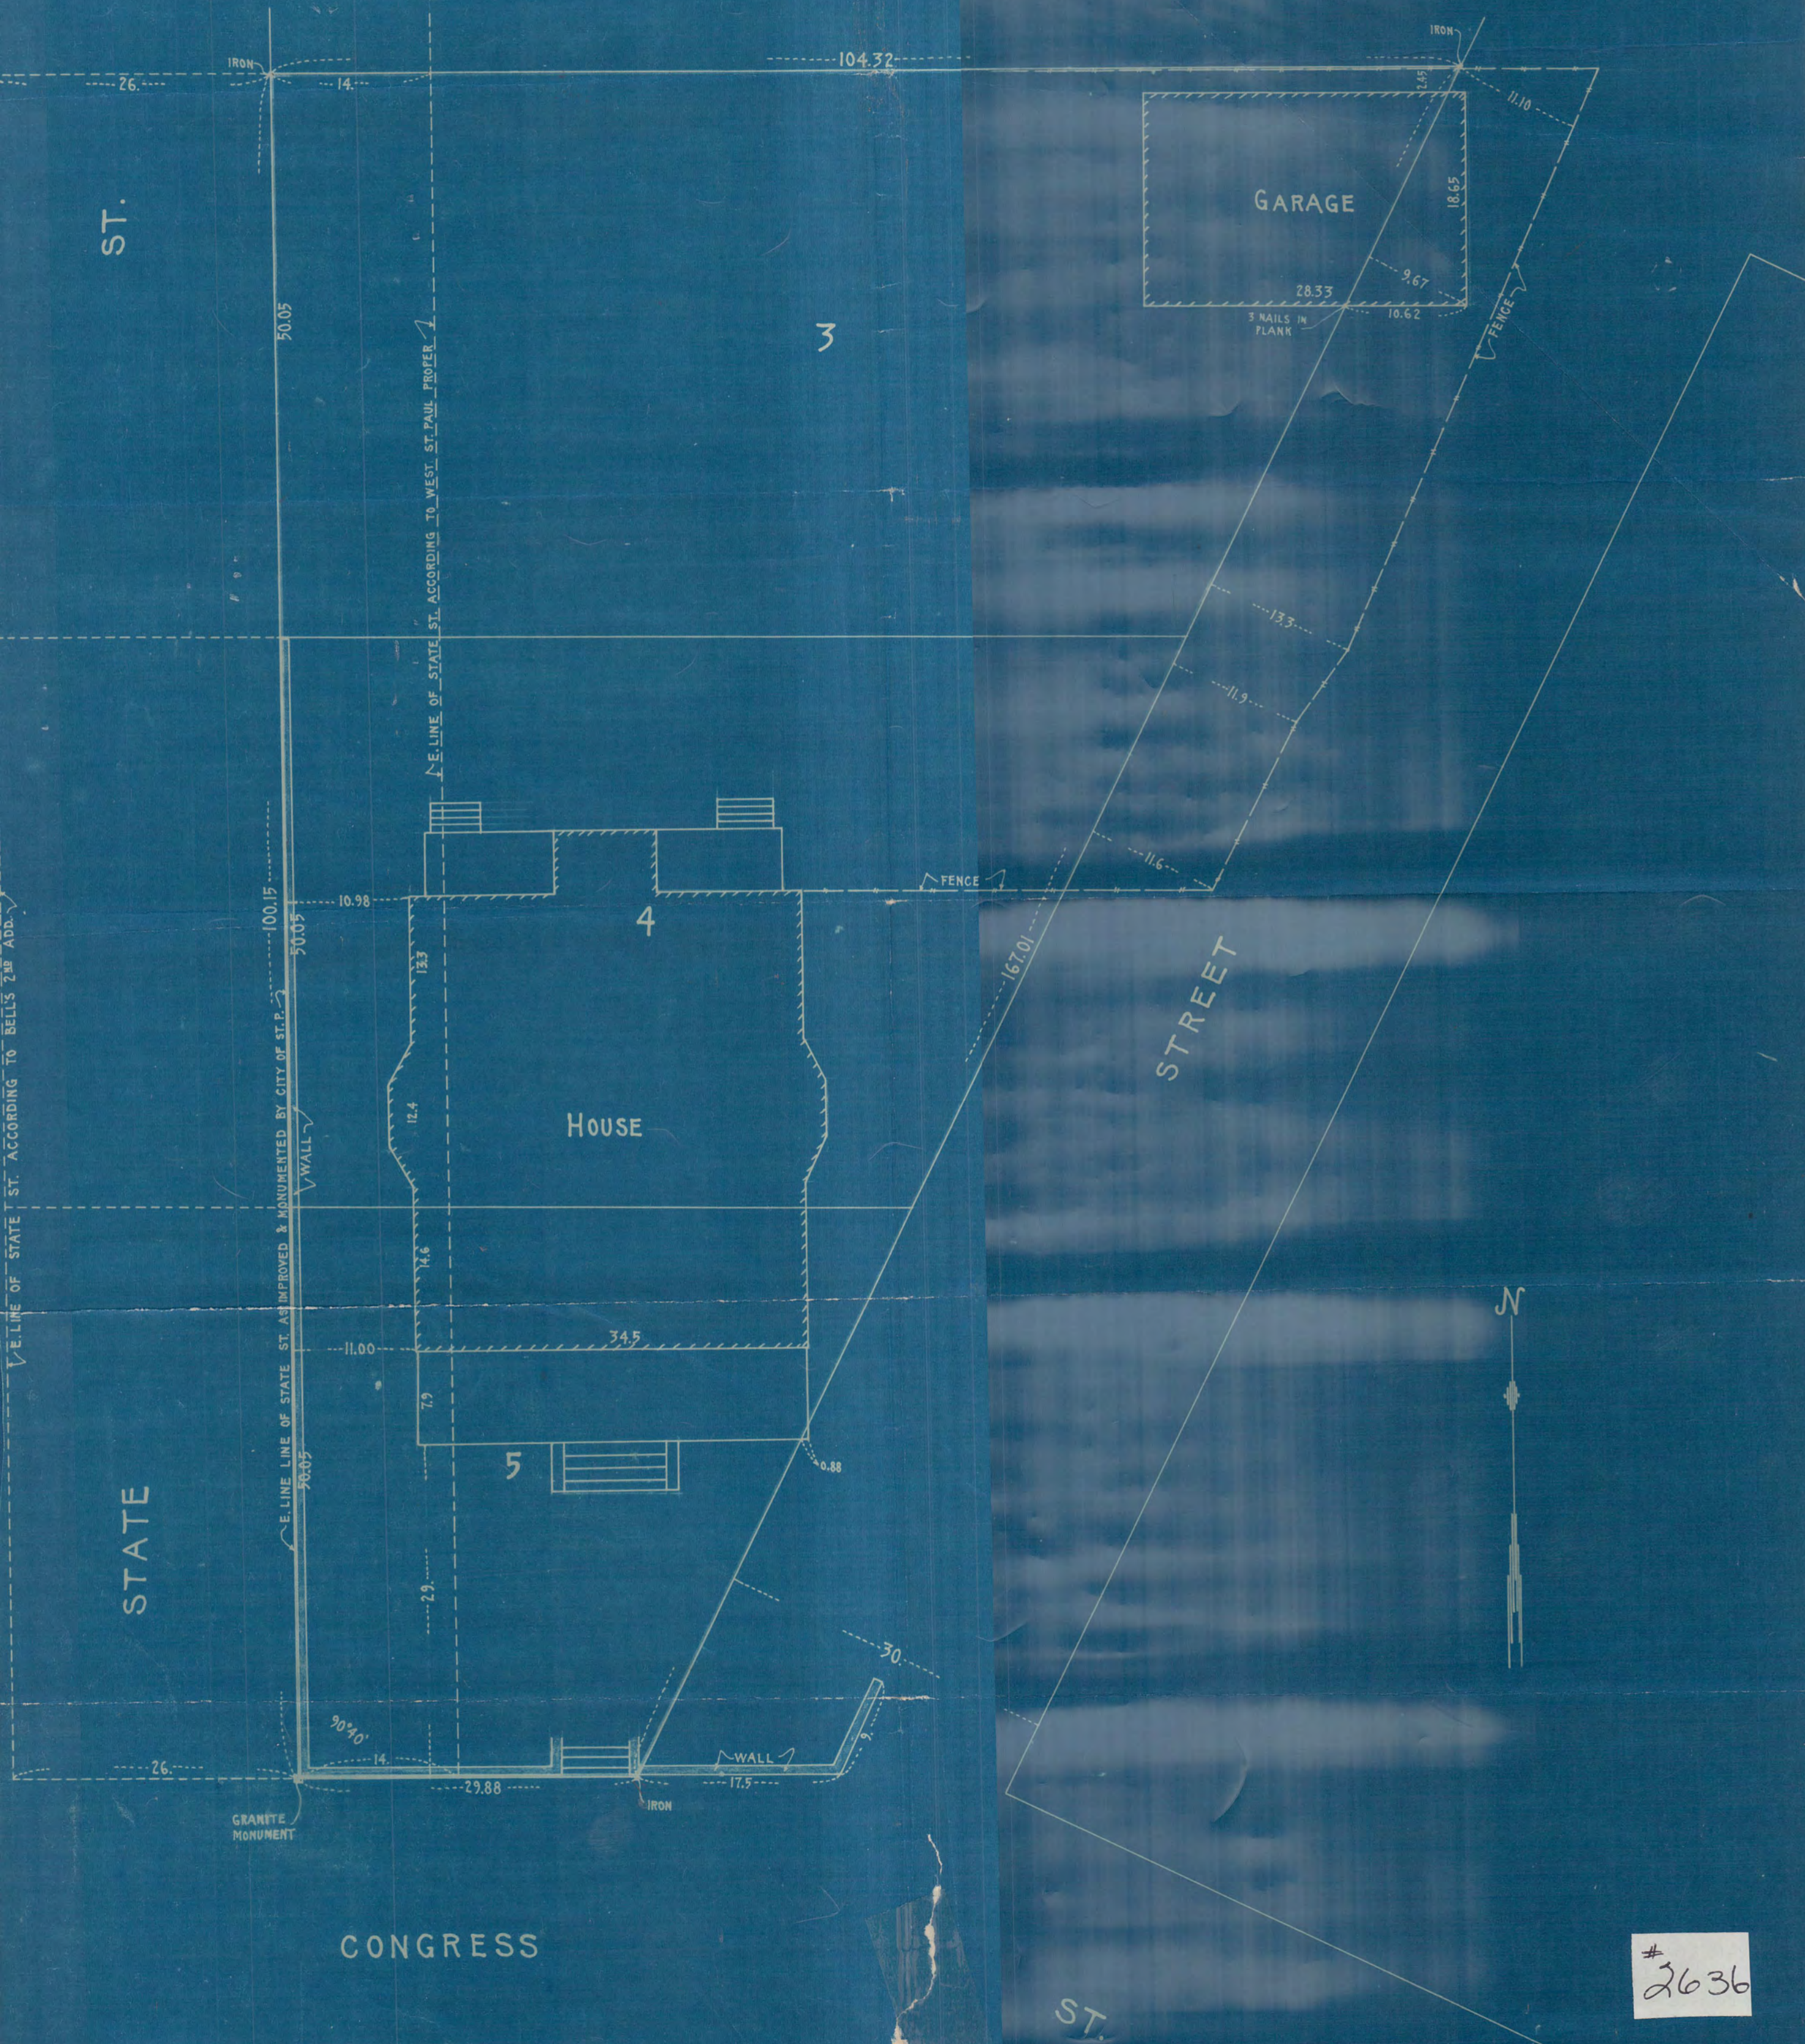

2636