

# WHITE BEAR

MINN  
SURVEY OF

LOT 1

JAN 22-1921

BLK 59

JENS PEDERSEN  
SURV.


SCALE 20' = 1"

EXCEPT SLY 70 FT.

THIRD

ST.

*Exhibit A.*

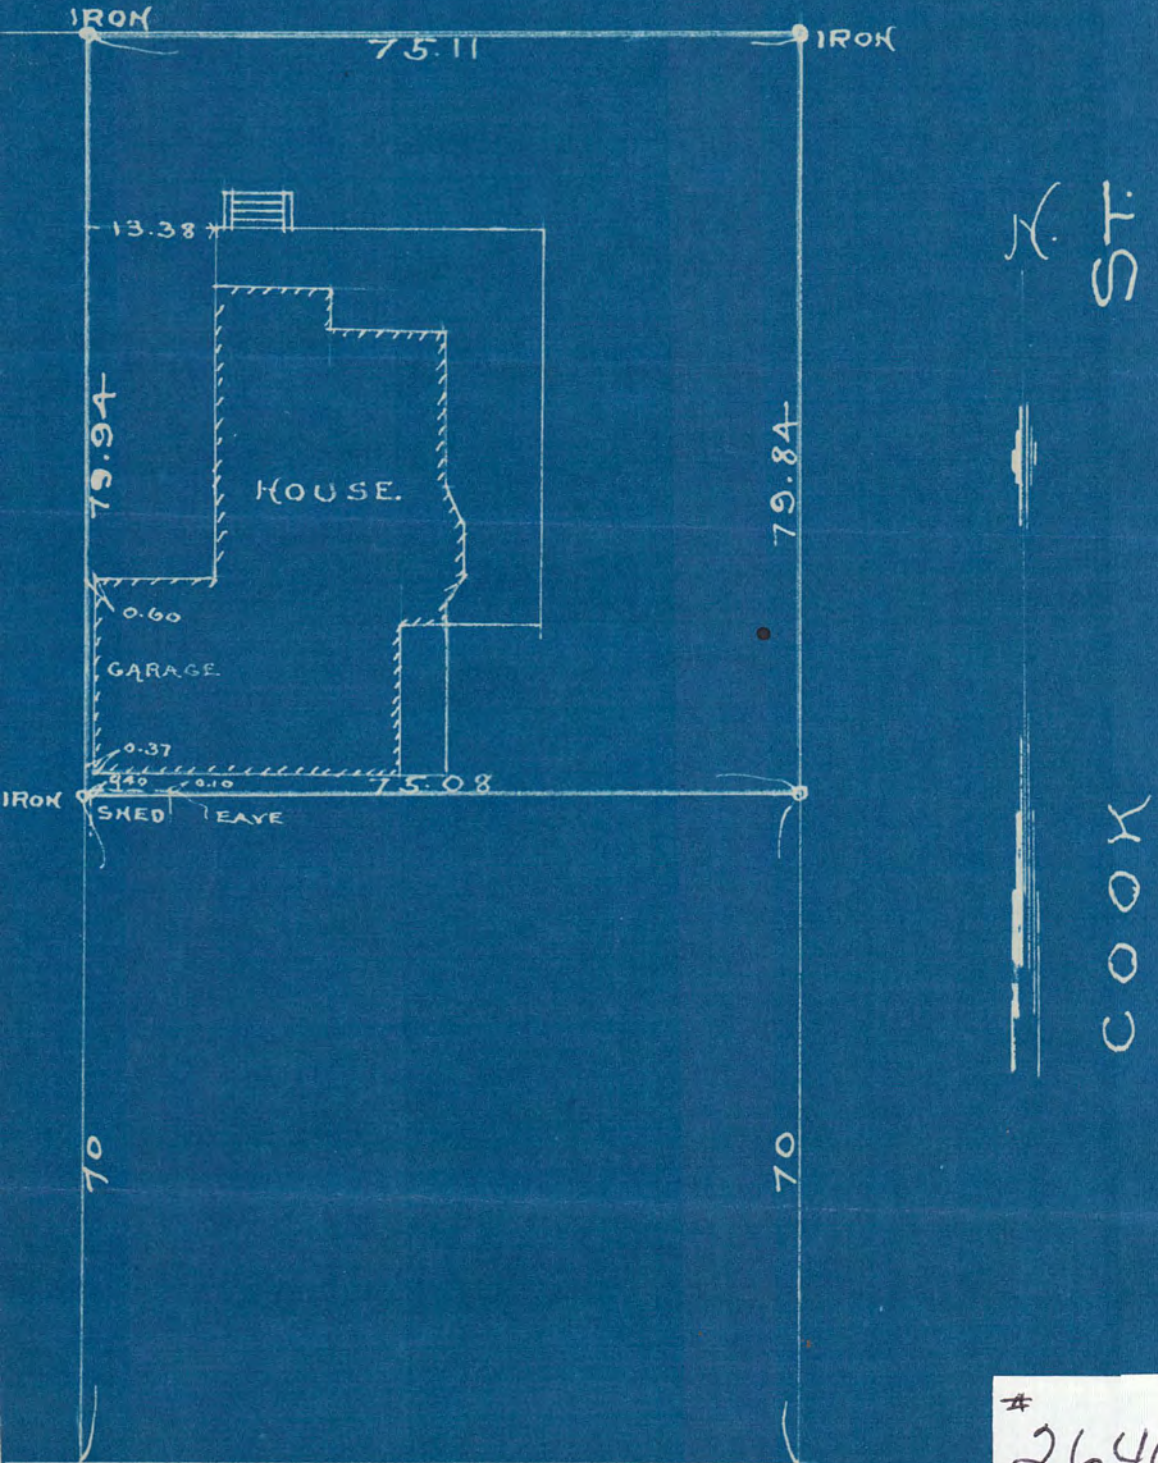

#  
2640