DAYTON & IRVINE'S ADD.

SURVEY OF

LOT 27, BLK. 83; AND THAT PART OF RESERVE STRIP IN NININGER'S ADD. ADJACENT TO SAID LOT.

DEC., 10, 1920.

SCALE 1"=20'.

JENS PEDERSEN
SURVEYOR.

MARSHALL AVE.

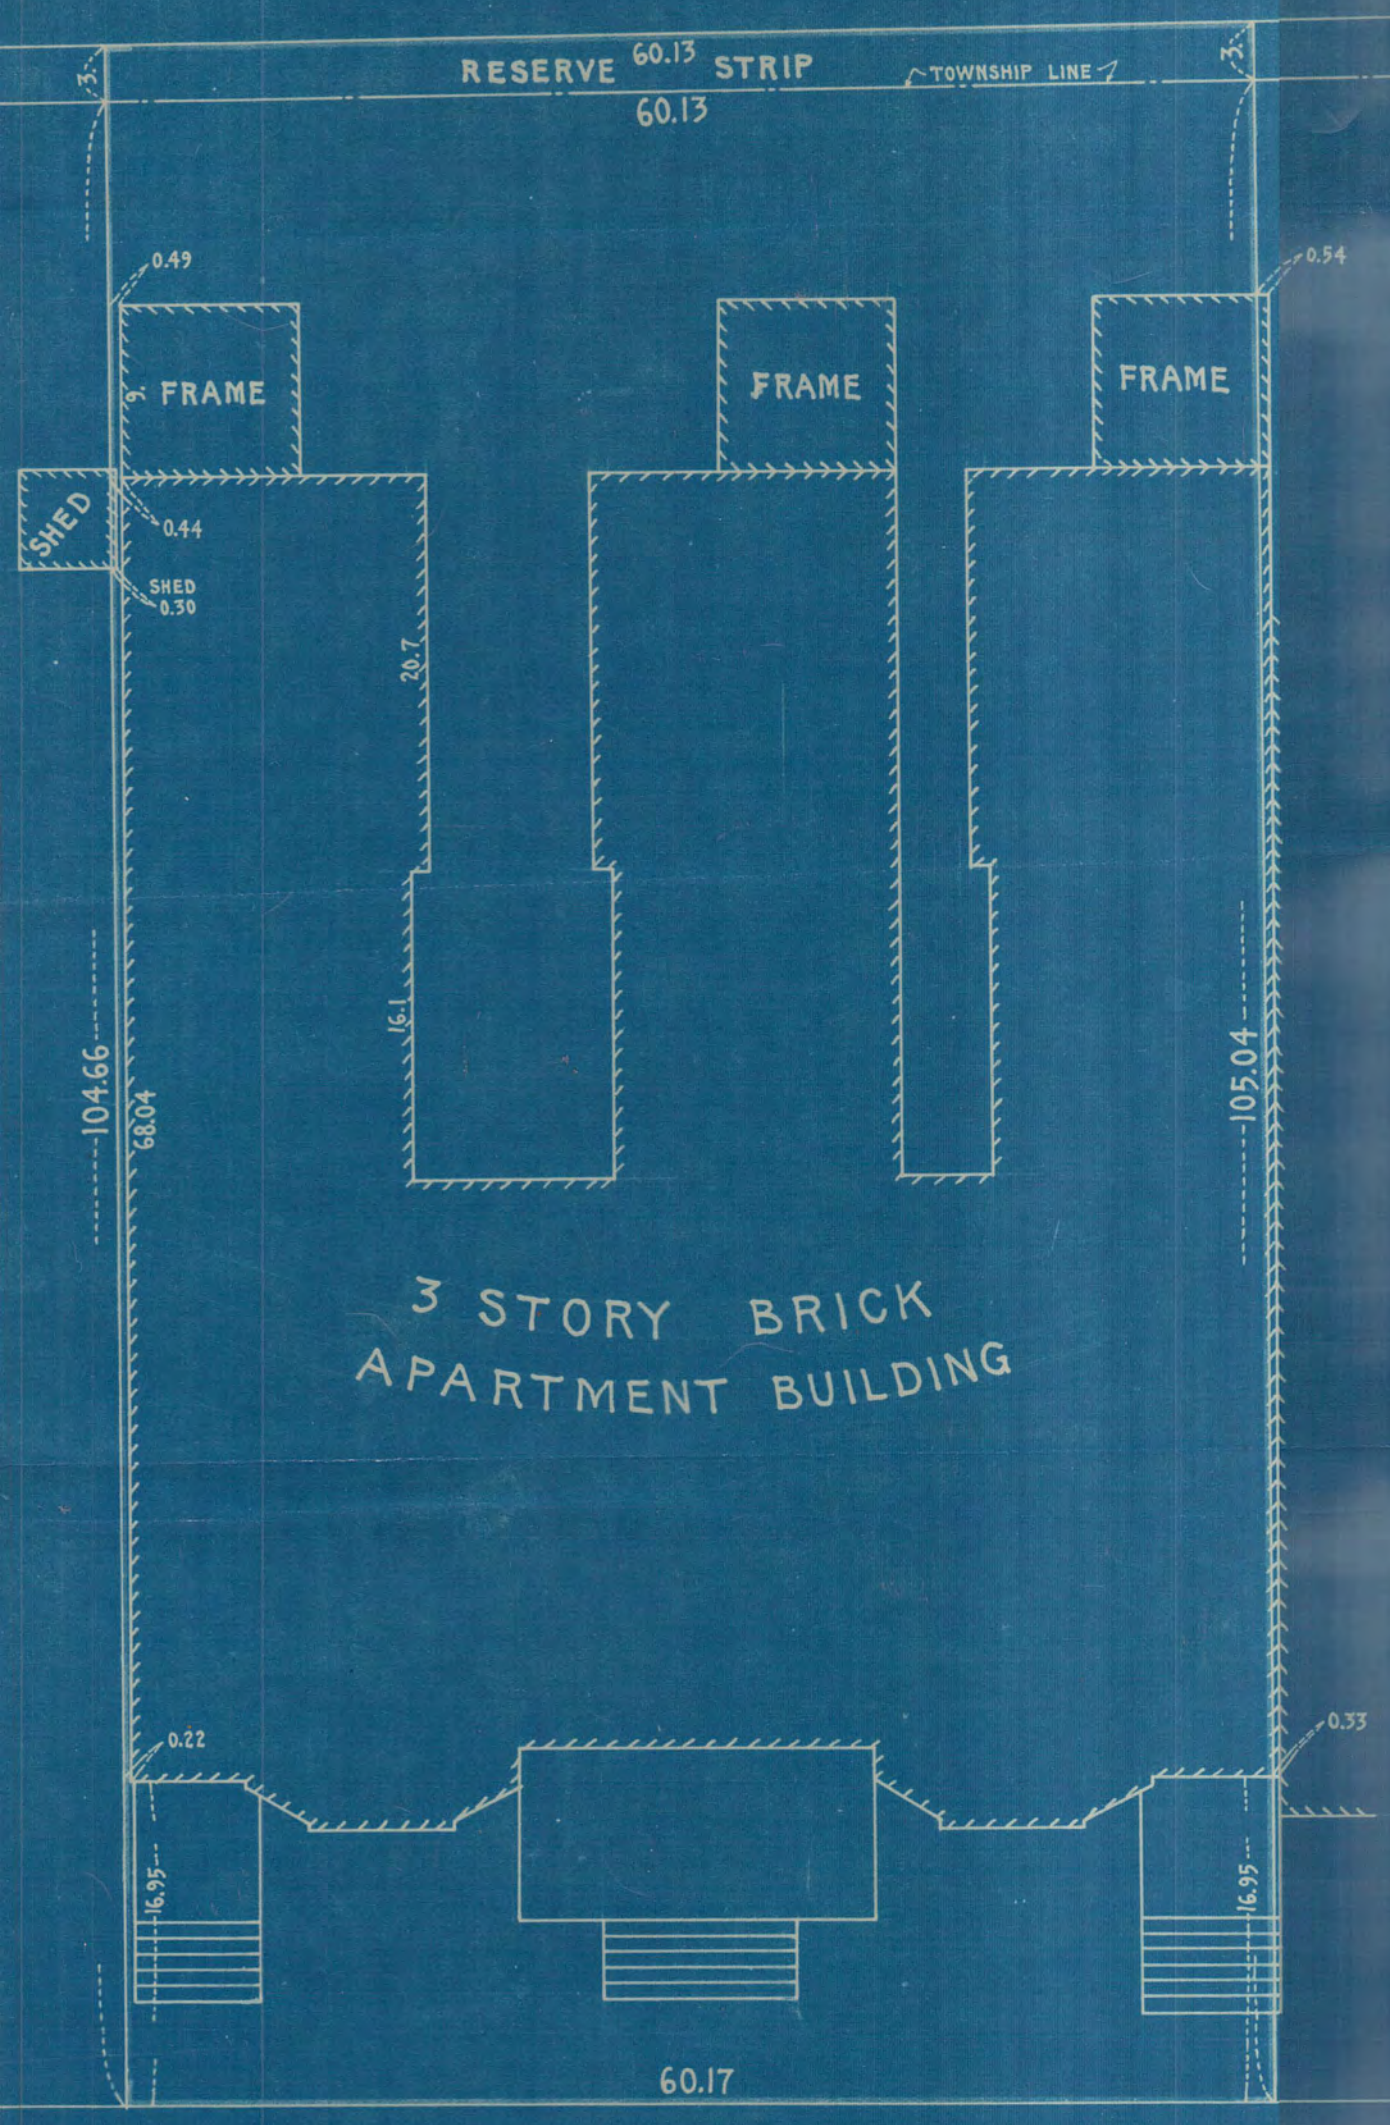

NELSON AVE.

#2648