


J. R. WEIDE'S 2ND ADD.

J. R. WEIDE'S 3RD ADD.


N'S SUB.

16 17 18 19 20 18 19 20 21 22 23 24



MARYLAND ST.

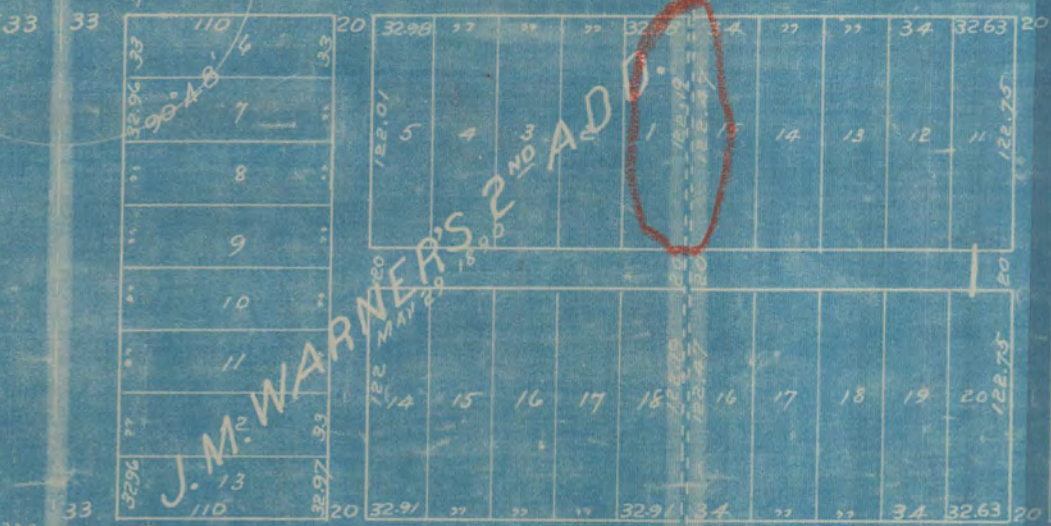

ROSE ST.

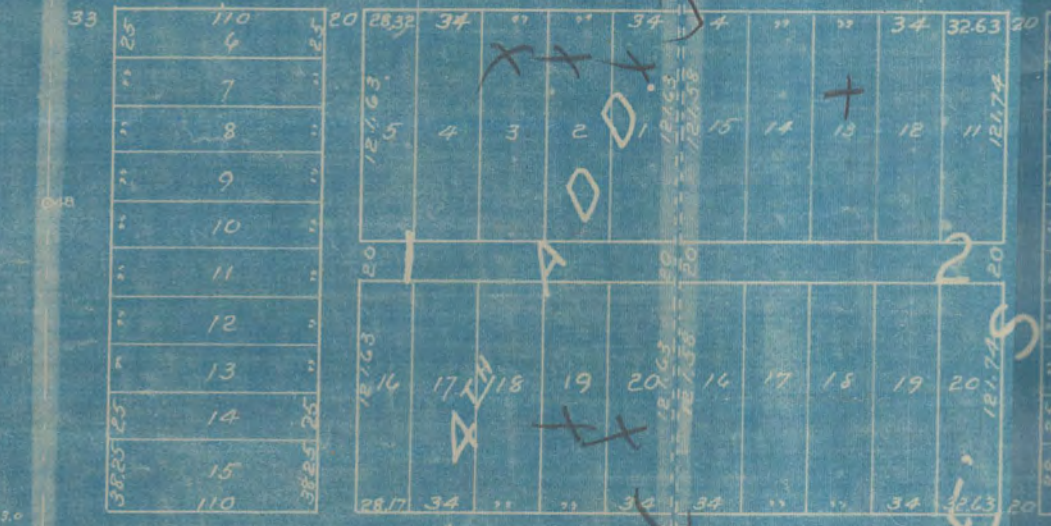

RANUIM ST.

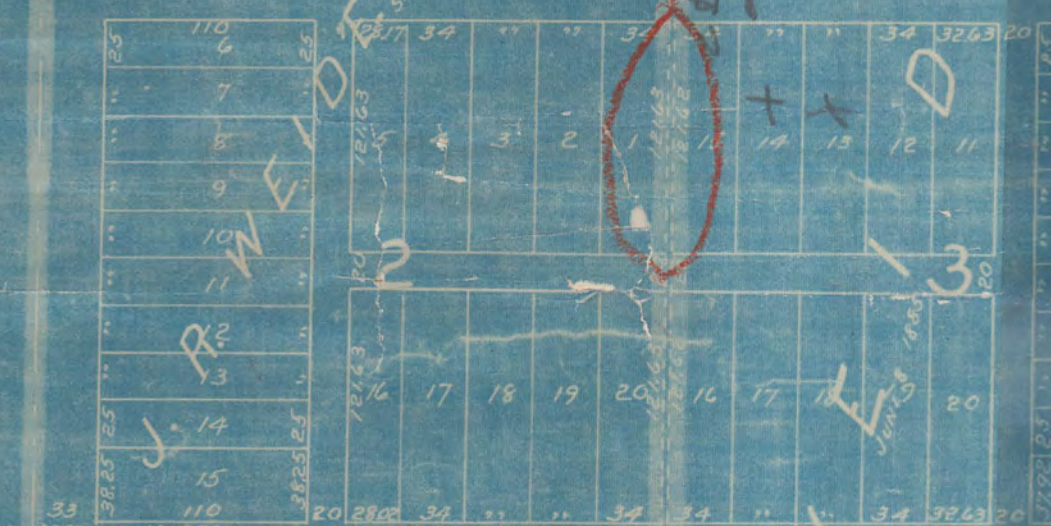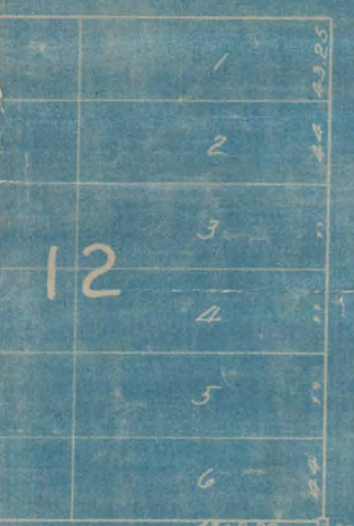


SSAMINE ST.



SNOLIA ST.



COOK ST.

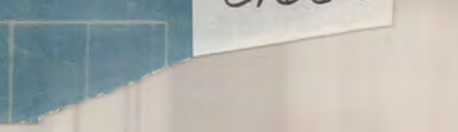

2686