


2692

AVE.

CROMWELL

Scale 1" = 20'

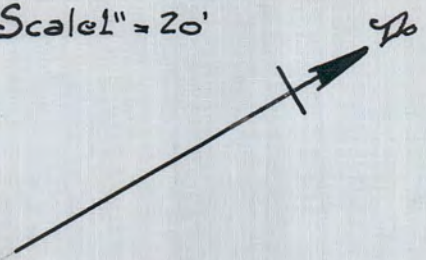

I hereby certify that I have surveyed Lot 2 Block 65 St. Anthony Park an addition to St. Paul; except that part of said Lot 2 described as follows; commencing at a point on the dividing line between said Lot 2 and Lot 3 in said Block 65 forty-one and three tenths (41.3) feet from the alley as laid out along the rear of said lots thence Northerly One hundred twenty-eight and eight tenths (128.8) feet along said dividing line towards and to the dividing line between said lots and Cromwell Avenue St. Paul; thence Easterly along said last mentioned dividing line a distance of Ten (10) feet; thence Southerly by straight line towards and to the point of beginning; and I further certify that above plat is a true and correct representation of said survey.

J. J. Garvey
Surveyor

720 Phoenix Bldg
Mpls. Minn

2692

