

EASTLY 1/2 LOT 5 BLOCK 8 ED. RICE'S 2ND ADDN.

Scale 10 ft. per. inch

Oct. 1921

F. J. Armstrong
Civil Eng.



WESTLY LINE LOT 5

137.0

EASTLY 1/2 LOT 5

138.5

0.62


0.76

25.08

28.1

0.4

GI NORTHERN RY

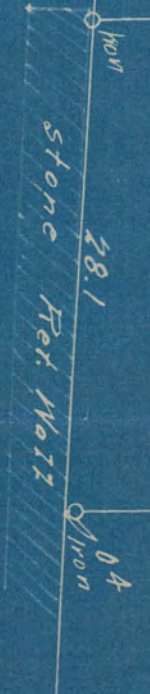

Frame
Bldg.

ACKER ST.

2793

ABSTRACT OF TITLE

Prepared by The St. Paul Abstract Company

No. 1

To Easterly $\frac{1}{2}$ of lot 5 block 8, Edmund Rice's 2nd Addition to the City of St. Paul.

State of Minnesota }
County of Ramsey }

The St. Paul Abstract Company does hereby certify that the following exhibit, consisting of 14 sheets, from 1 to 14 inclusive (each of which bears its Corporate Seal), and 118 entries from 1 to 118 inclusive, is a true and complete Abstract of Title to the real estate described in No. 1 hereof, as shown by the records in the office of the Register of Deeds in and for said County and State, up to this 7th., day of September 19. 21. at 8 o'clock A.M.

THE ST. PAUL ABSTRACT COMPANY
ABSTRACTERS

Henry C. Louis heray
Treasurer
VICE-PRESIDENT

-2-

