

Exhibit A

LOTS 5-6-7-8, BLOCK 7 RICE and IRVINE'S ADDITION


Scale 10 ft. per inch

Jan - Feb. 1922

J. Priestley
Civil Engr.

WEST SIXTH ST.

WEST SEVENTH ST.

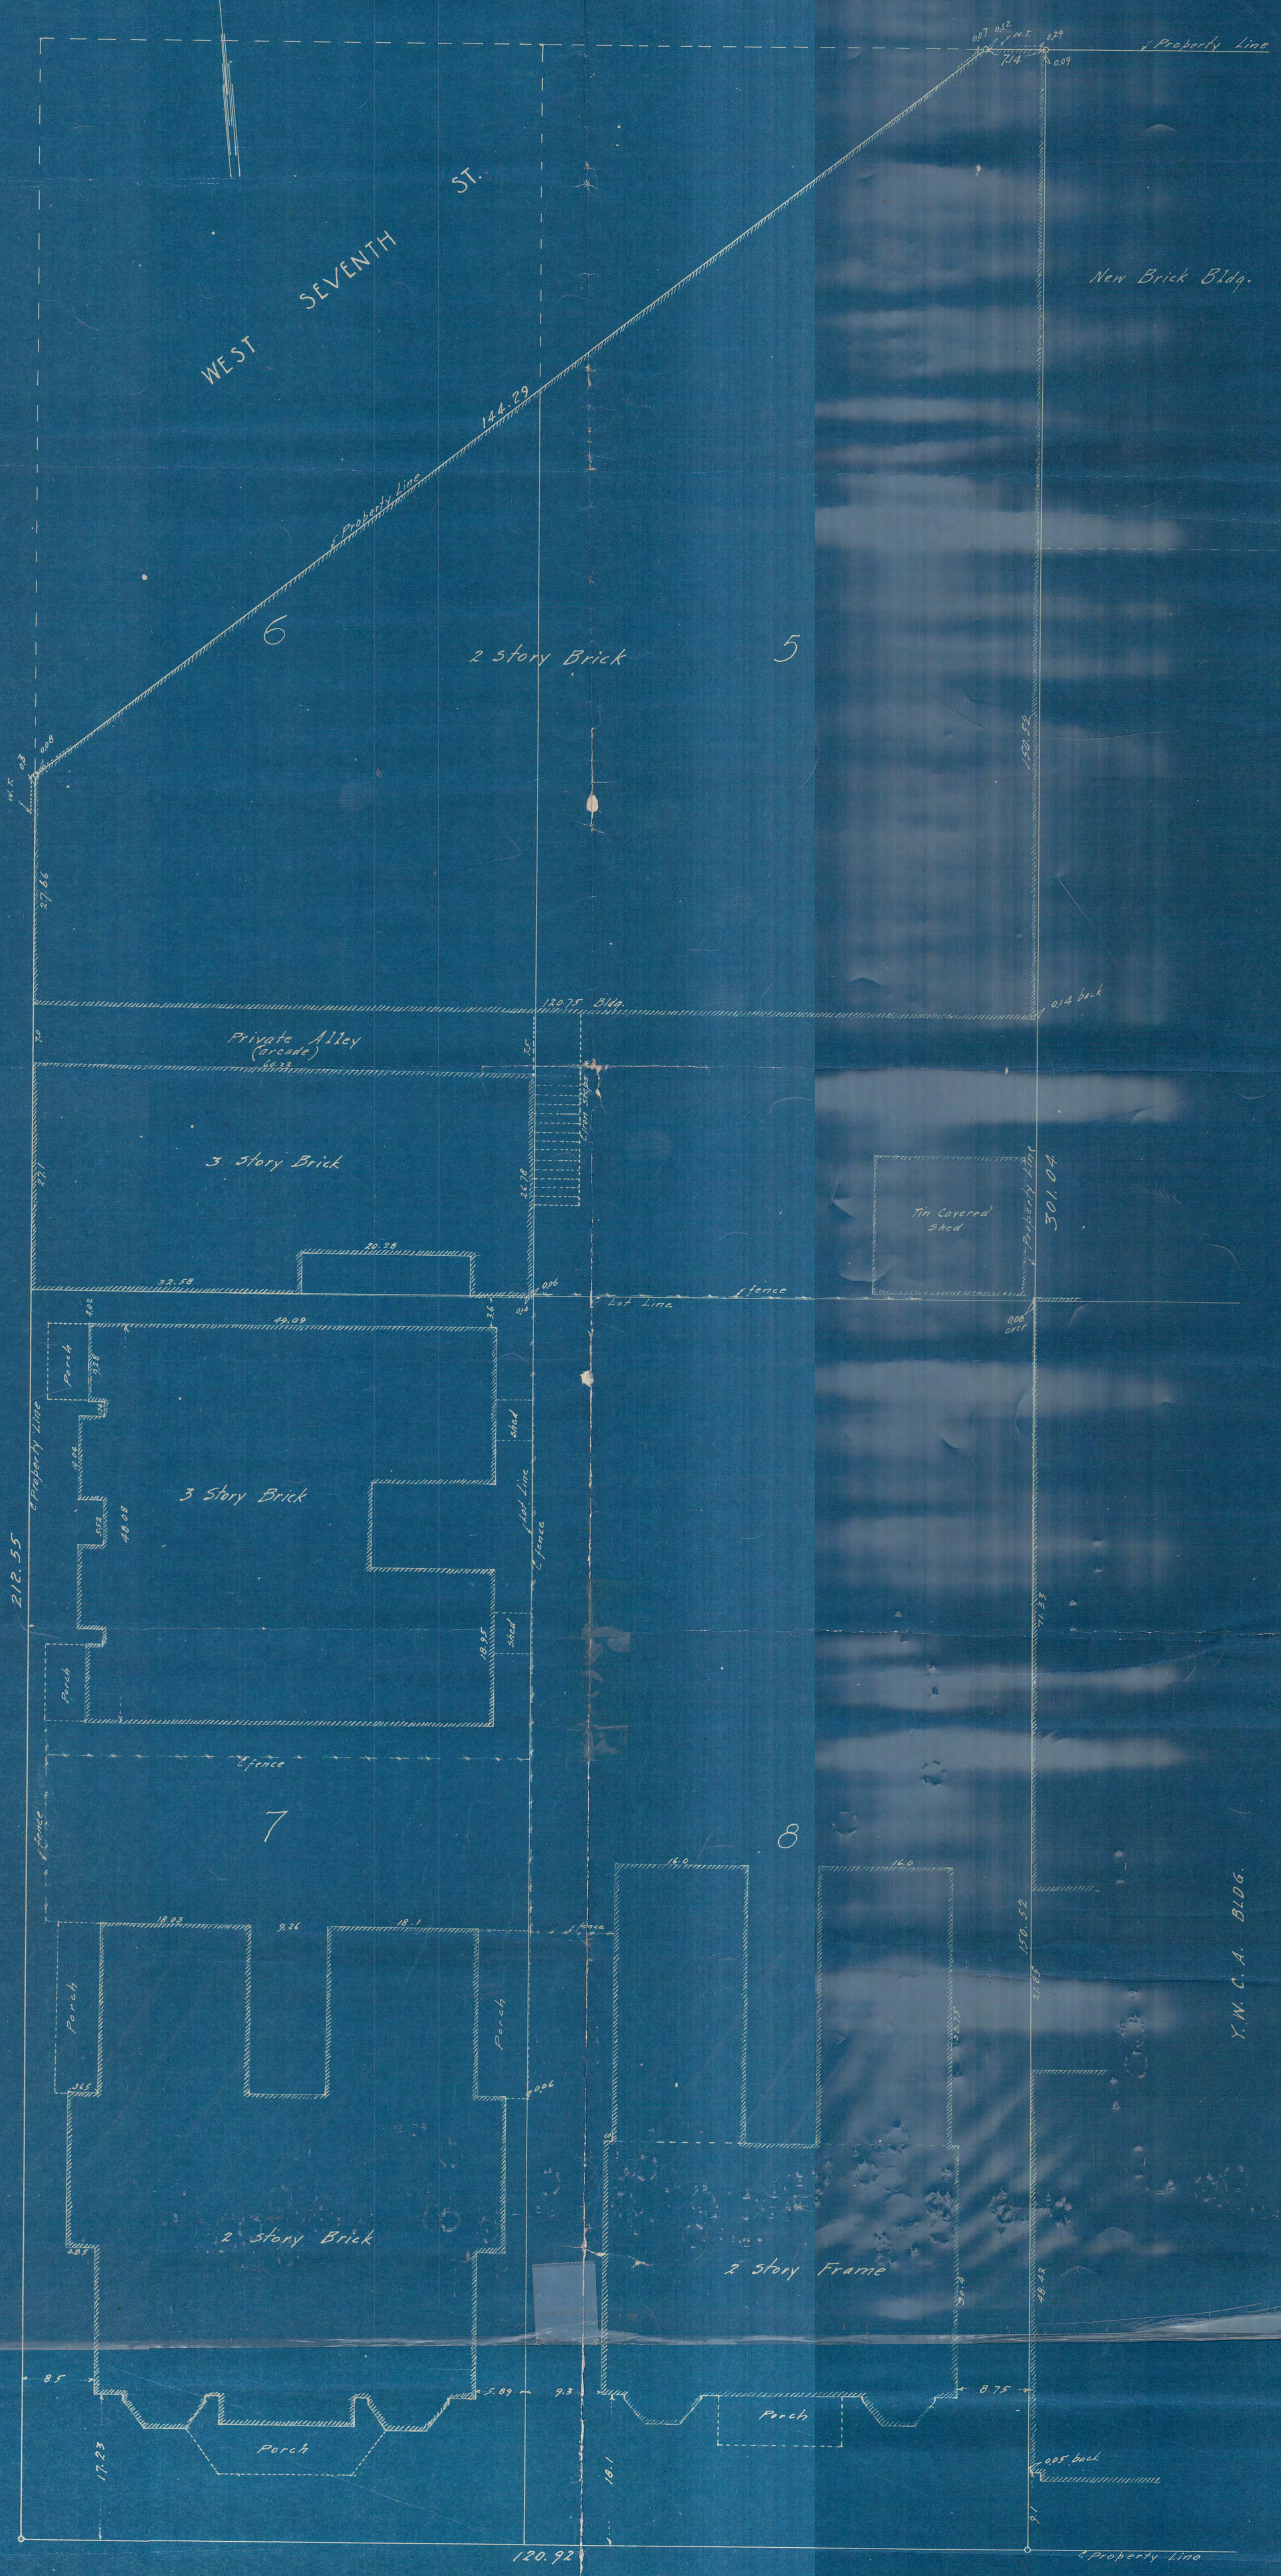

New Brick Bldg.

2 story Brick

3 story Brick

3 story Brick

2 story Brick

2 story Frame

Tin Covered Shed

FRANKLIN ST.

X.W.C.A. BLDG.

WEST FIFTH ST.

2795