

BRIGHTWOOD PARK


SURVEY OF

LOTS 1, 2 & 3, EXCEPT PART LOT 3 TAKEN FOR ALLEY; BLK. 1.

MAR., 14, 1922.

SCALE - 1" = 20'

JENS PEDERSEN
SURVEYOR.

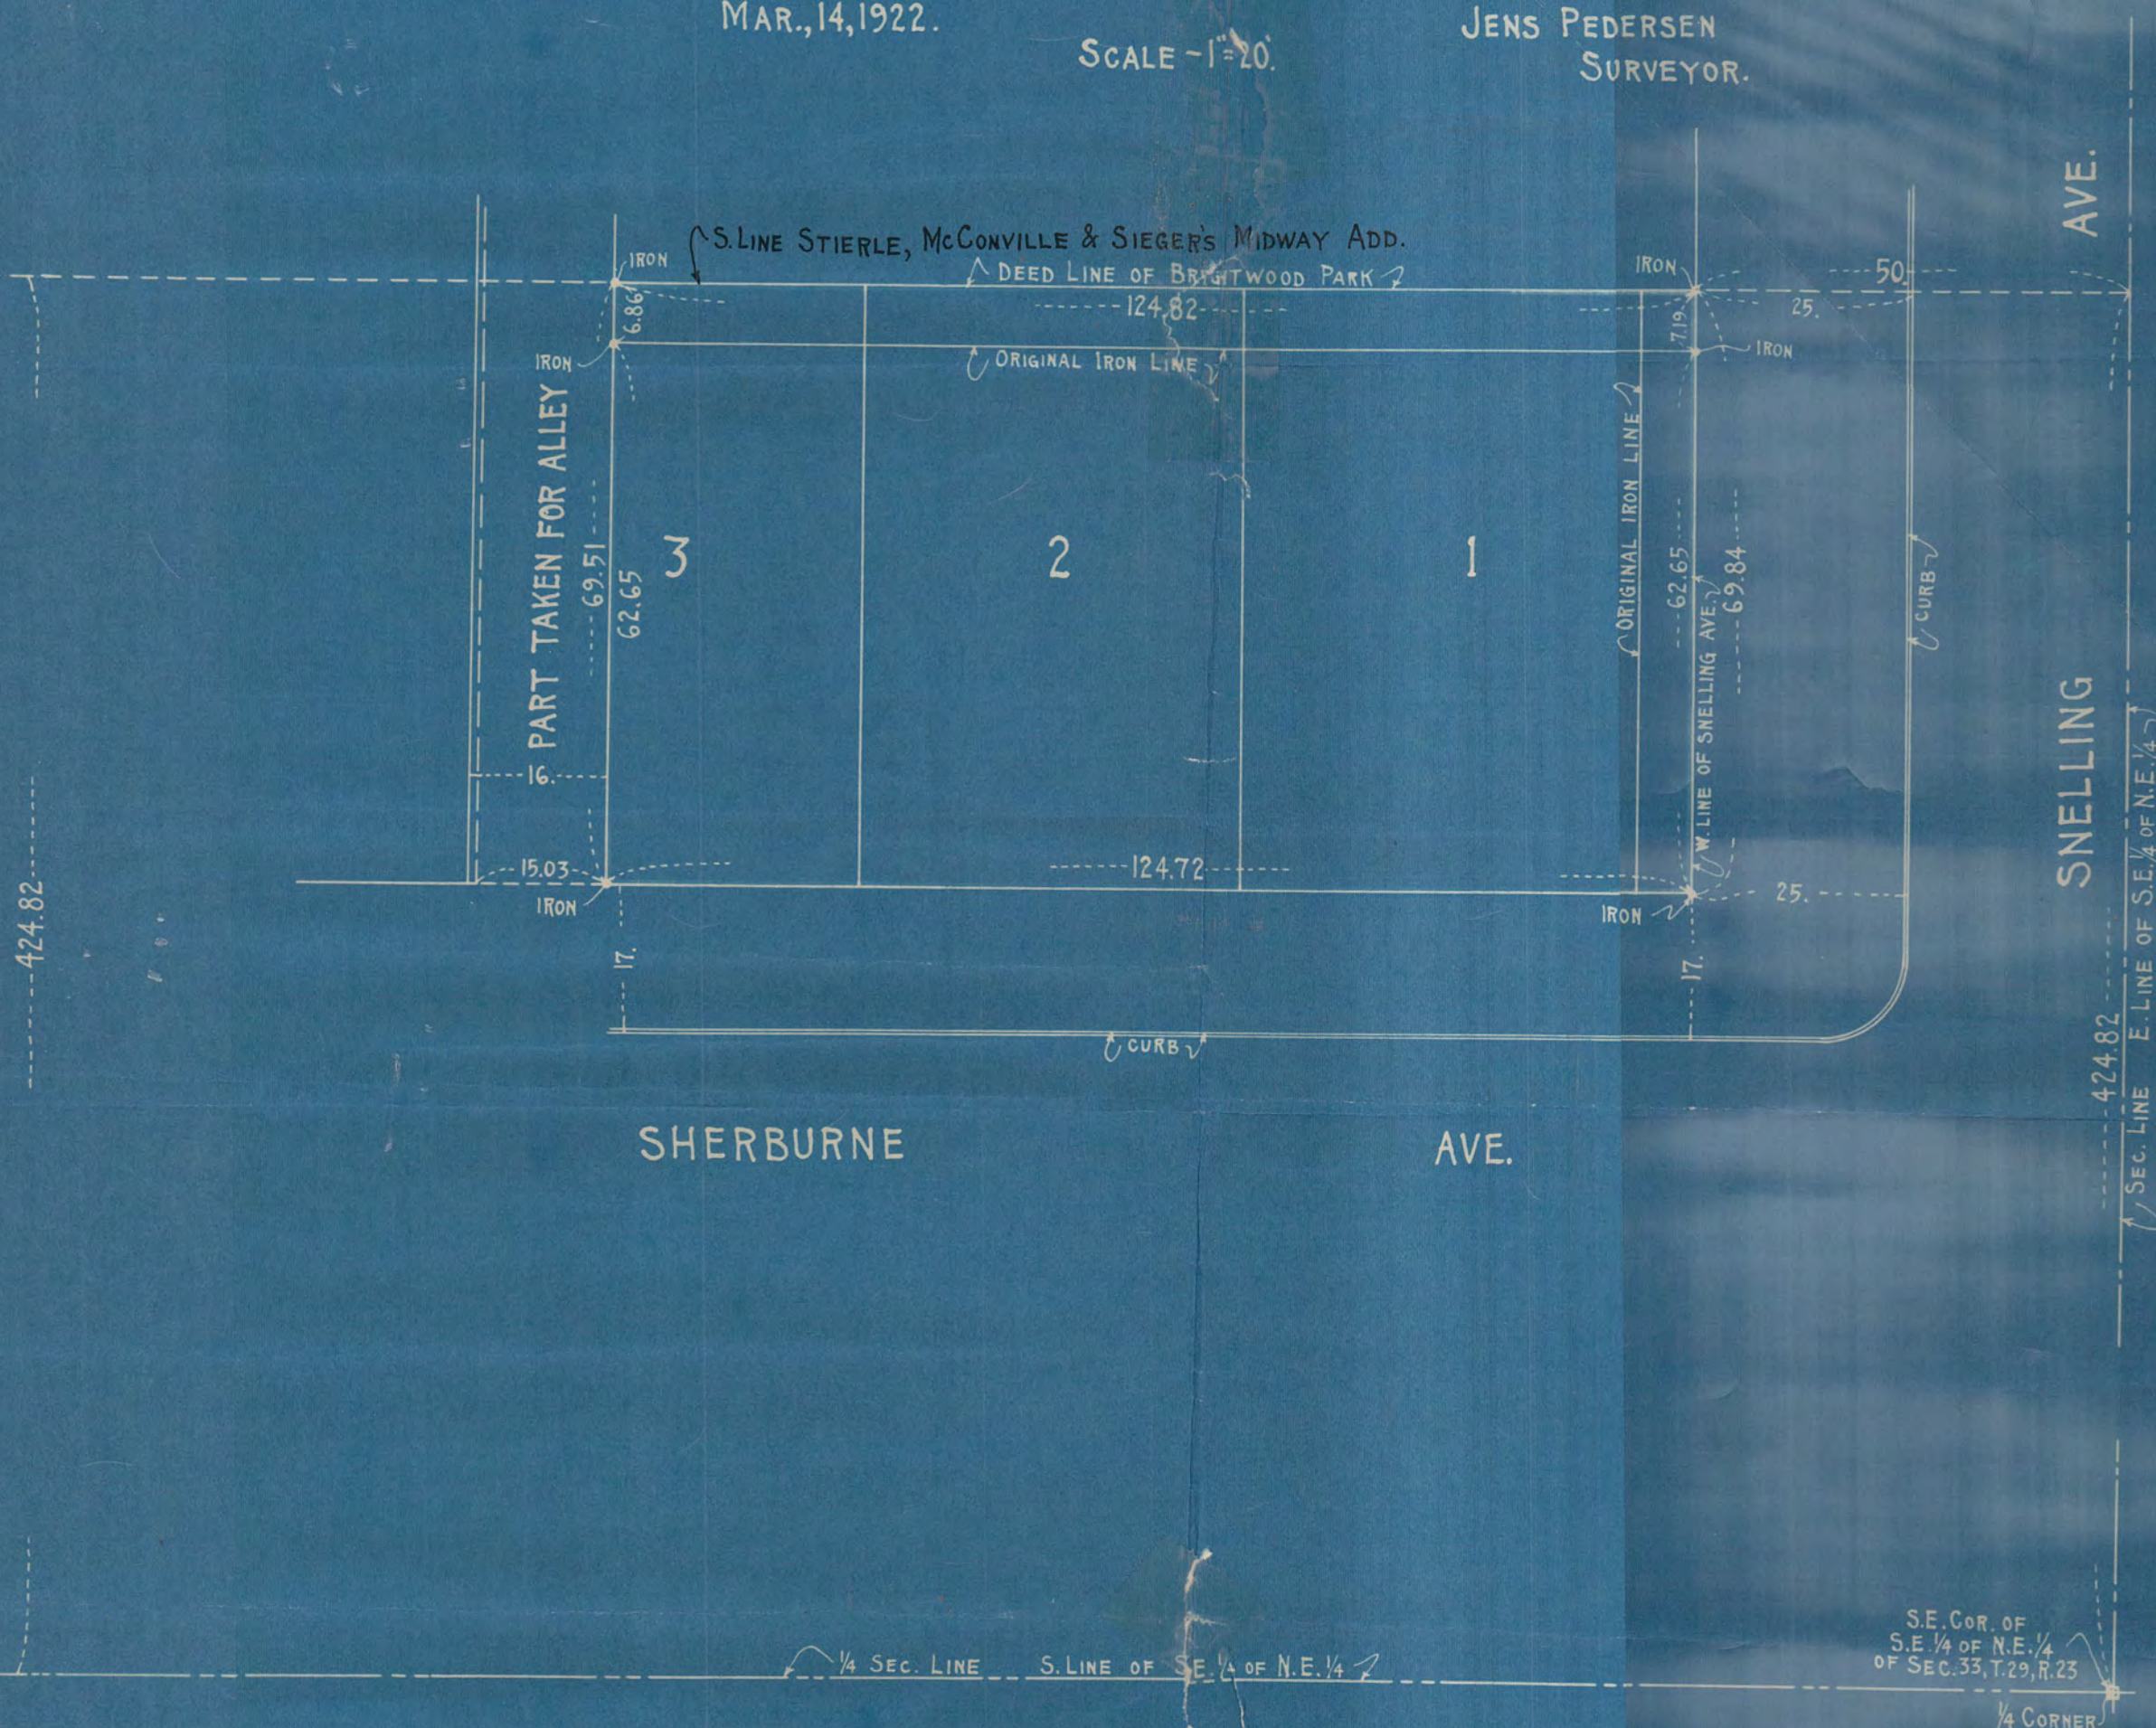

S.E. COR. OF
S.E. 1/4 OF N.E. 1/4
OF SEC. 33, T. 29, R. 23

1/4 CORNER

2805