


2846

SURVEY OF  
LOT - 15 - BLOCK - 1 -  
BRYANTS RANDOLPH ST. ADDITION

Scale 20' = 1 inch  
Oct - 14 - 1922

W. F. Brettschneider  
Surveyor

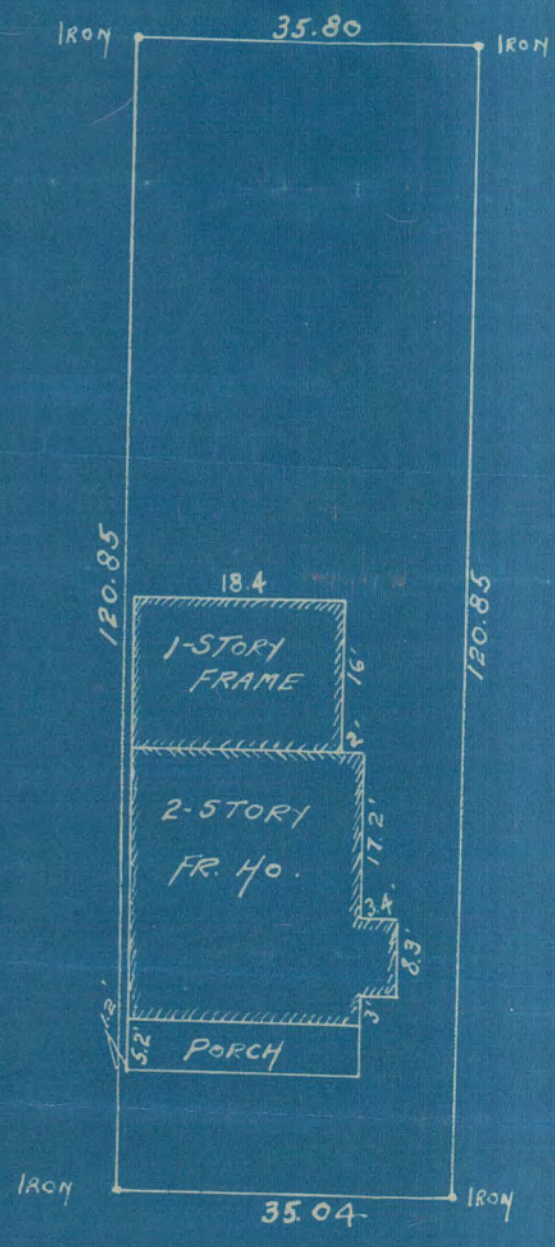

JUNO ST.

#  
2846