


2931

SURVEY OF
LOT No. 8

APR., 30, 1923.

JENS PEDERSEN
SURVEYOR

SCALE - 1" = 20'

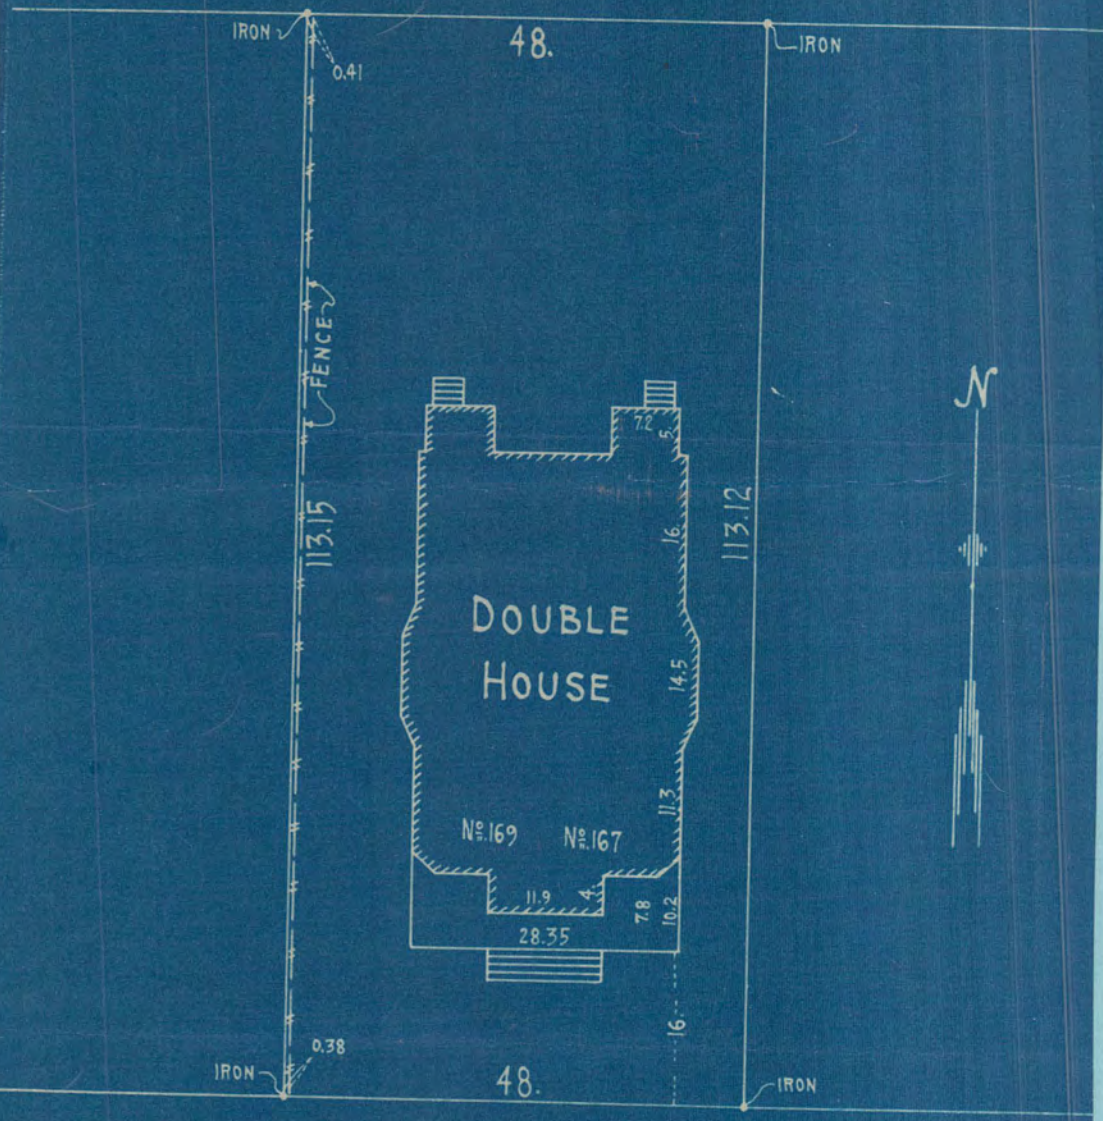

FULLER

ST.

2931