


SMITH AVE.

ALLEY

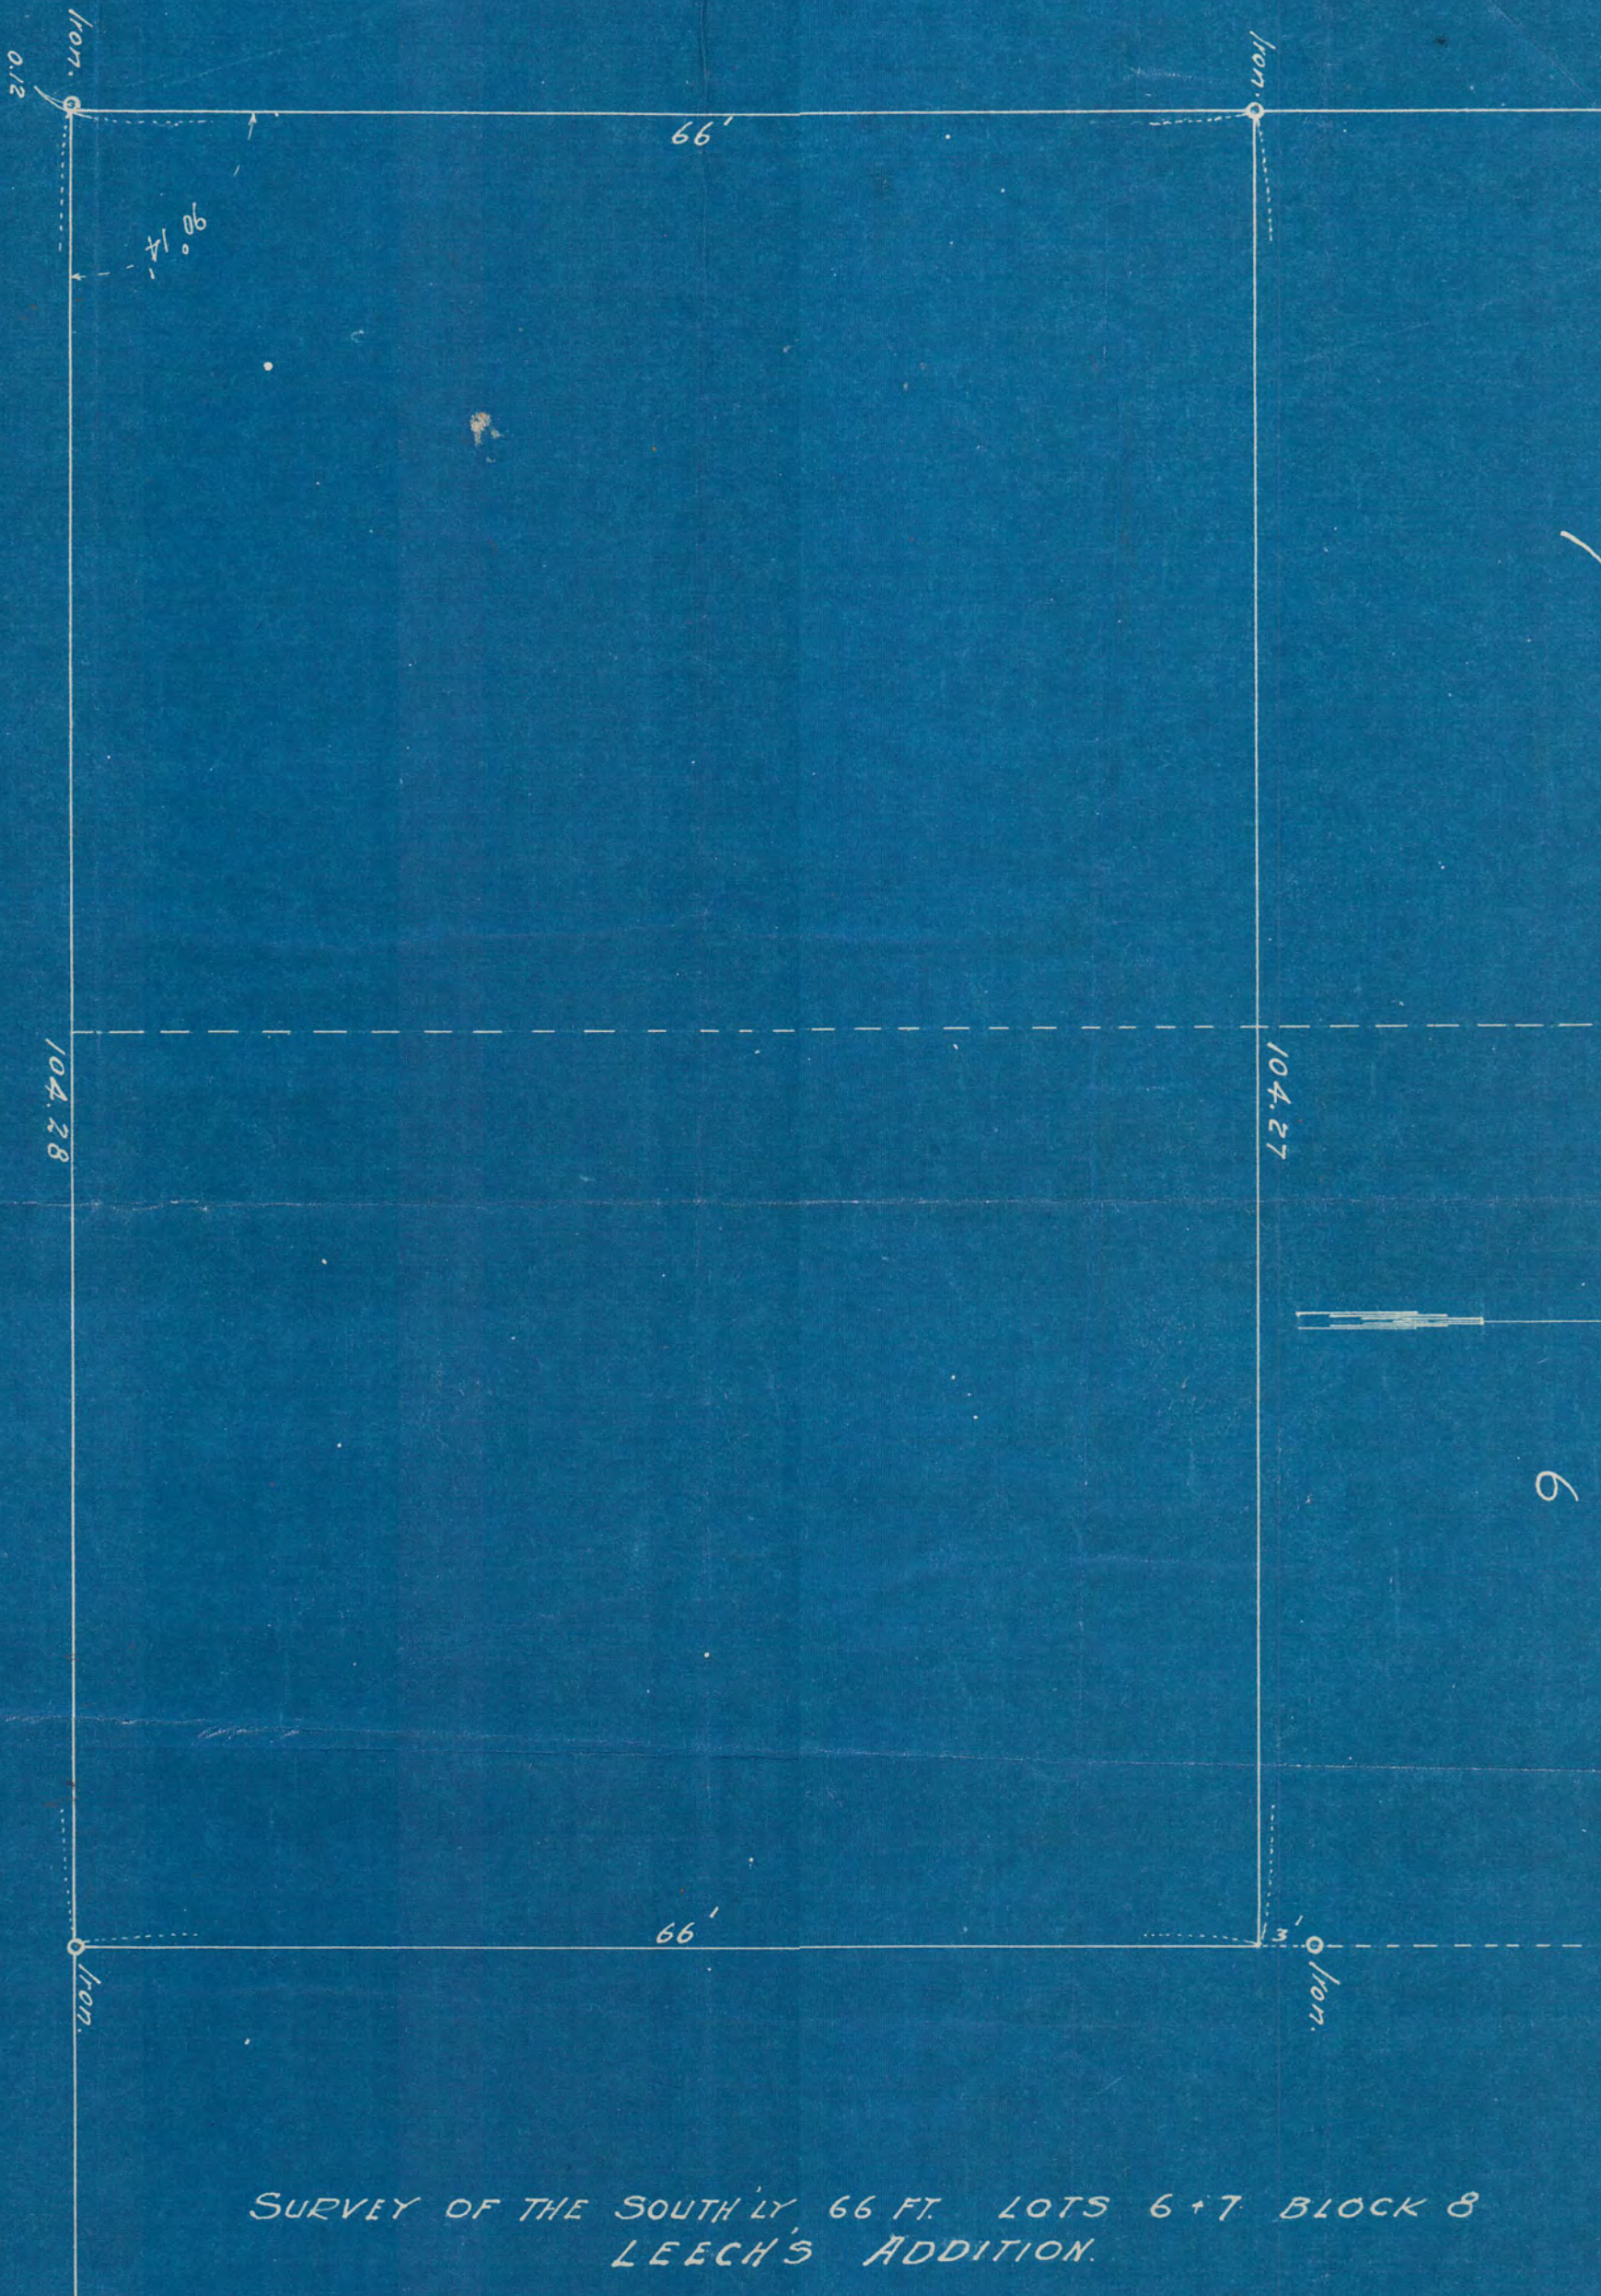

SURVEY OF THE SOUTHLY 66 FT. LOTS 6+7 BLOCK 8 LEECH'S ADDITION.

Scale 10 ft. per. inch

Aug. 31-1922.

*F. Armstrong
Civil Eng'r.*

2937

2937