


LOT 9 BLOCK 31
 RICE & IRVINE'S ADD.

SURVEYED BY
 SECURITY SURVEYING CO.
 11 DETROIT BLDG.
 ST. PAUL, MINN.

NOV. 22ND 1923.

SCALE 20 FT. PER INCH.

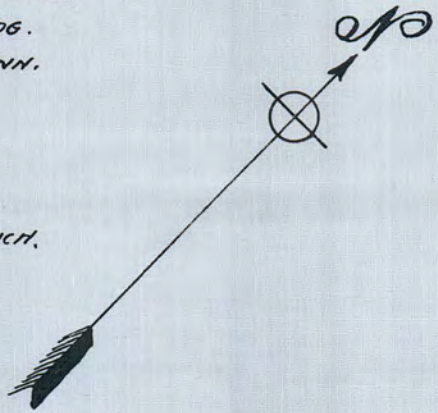

I, Paul R. McLaughlin, proprietor of the Security Surveying Co., here by
 certify that I have this 22nd day of Nov. AD. 1923, surveyed the
 property as described on this map, made the locations as shown
 and the same is correct.

Security Surveying Co.
 by Paul R. McLaughlin, Prop.



IRVINE PARK

2989

2989

STATE OF MINNESOTA

DISTRICT COURT

County of Ramsey

Second Judicial District

In the Matter of the Application
of Herman A. Krengel to register the
title to Lot numbered nine of Block
numbered thirty-one, Rice and
Irvine's Addition to St. Paul.

-vs-

SURVEYOR'S AFFIDAVIT

Northern Savings Bank, L. L. Cornwell,
James J. Finley, Agnes Benson, Charles
Lundstrom, Herman C. Gieske, C. E.
Speakes, John Holm, Capital City
Lumber Co., Snell Sash & Door Co.,
Lewis M. Glass, E. R. Richardson,
Christ Kvan, Iver L. Mattson, Nels G.
Bjorklund, Adolf Carlson, Arthur
Ingvaldstad, Northern Insulating Co.,
Twin City Stucco Co., A. C. Jefferson,
Gustaf Edman, and all other persons
or parties unknown, claiming any
right, title, estate, lien or
interest in the real estate described
in the application herein. Defendants.

STATE OF MINNESOTA)
)ss
County of Ramsey)

Paul R. McLagan, being first duly sworn
upon oath says that he is a Civil Engineer residing and
practicing his profession in the City of St. Paul, Minnesota
that the accompanying survey of Lot numbered nine (9) of
Block numbered thirty-one (31) in Rice and Irvine's
Addition to St. Paul, situate in the County of Ramsey
and State of Minnesota is a true and correct survey of
said Lot numbered nine (9) of Block numbered thirty-one
(31) in Rice and Irvine's Addition to St. Paul, the
property therein more particularly described and that there
are no encroachments thereon.

Subscribed and sworn to before
me this 22nd day of November, 1923.

Albert J. Mueller

Paul R. McLagan

Albert J. Mueller,
Notary Public Ramsey County, Minn.
My Commission expires Nov. 20th, 1928.

2989