

PROSPECT HILL

SURVEY OF

THE SOUTH 132. FT. OF THE WEST 330 FT.
OF LOT 7

MAY 13, 1924

JENS PEDERSEN
SURV.


SCALE 40' = 1"

Applicant's E.D.



OAK ST.

OAK

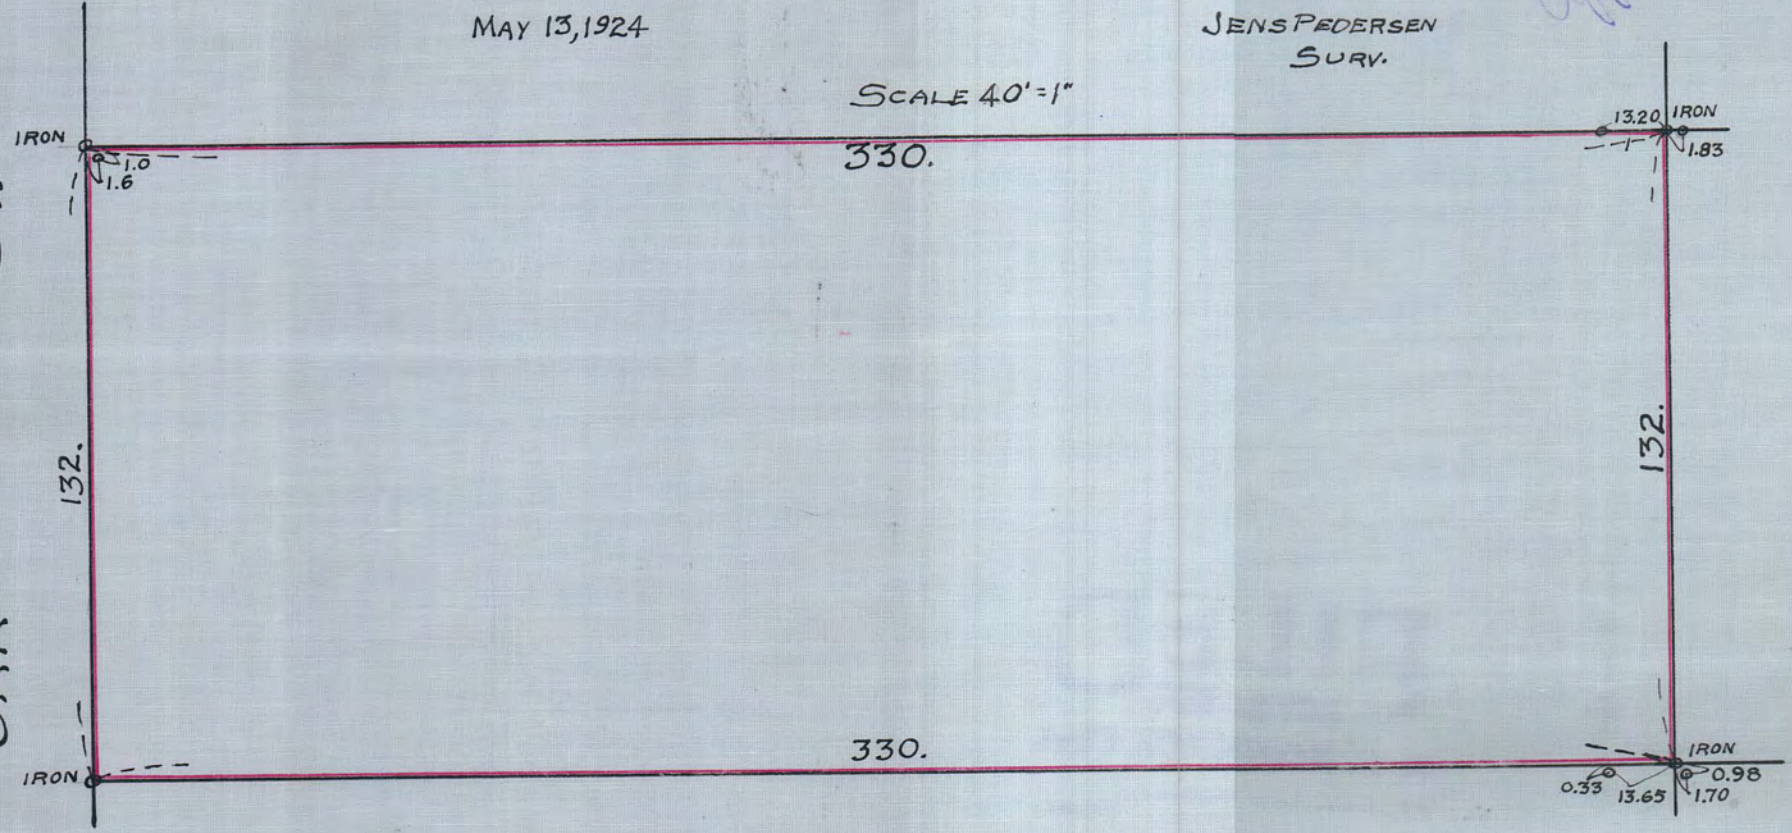

head

3024