3028

CERTIFICATE OF SURVEY

GUARDIAN–LIFE BLDG.

Franklyn J. Armstrong
CIVIL ENGINEER
and
SURVEYOR
Successor to
D. L. CURTICE
J. H. ARMSTRONG

ST. PAUL, MINN.

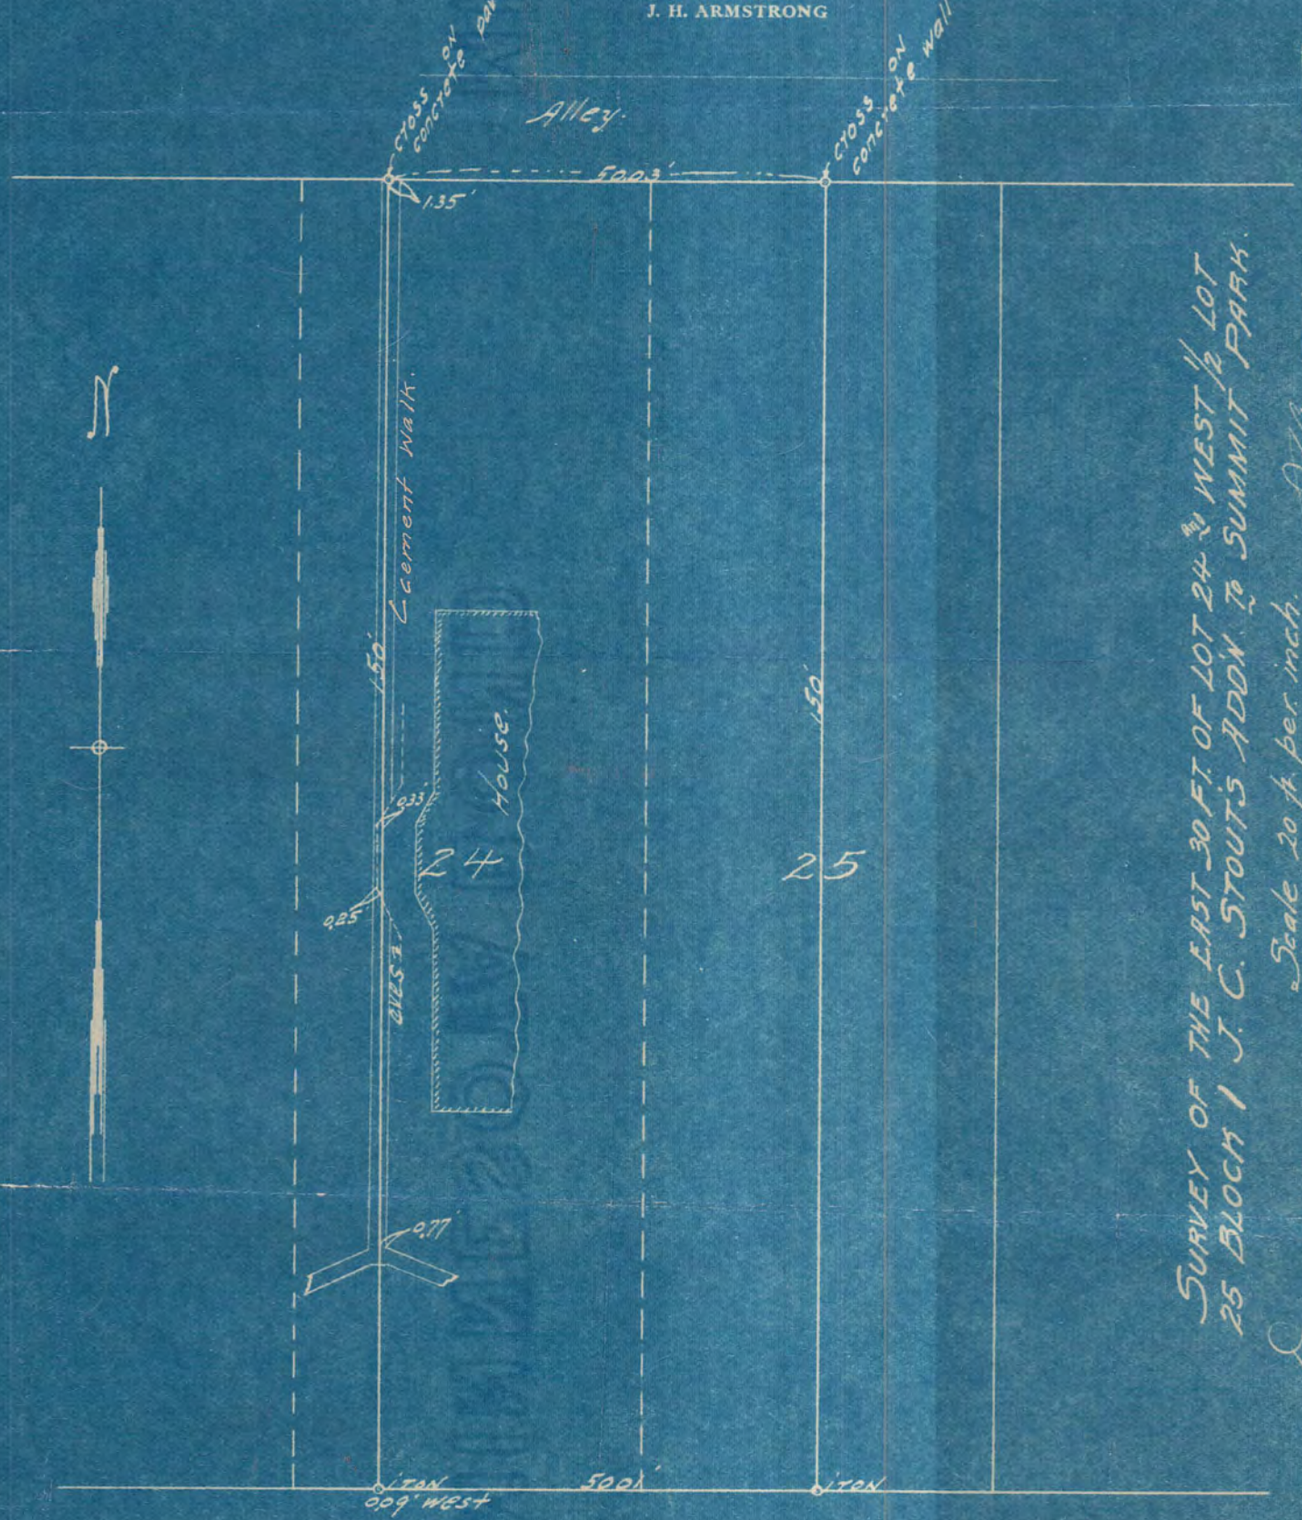

Survey of the East 30 ft. of Lot 24 and West ½ Lot 25 Block 1 J. C. Stout's Add'n to Summit Park.
Dec. 1923.
Scale 20 ft. per inch.

F. J. Armstrong
Civil Engr.

FAIRMONT AVE.

3028