

3046


SURVEY OF THE EAST 50 FT OF LOT 4 ALL OF LOT 3 AND THE WEST 20 FT OF LOT 2 SUMMIT COURT.

2001.1925

Scale 10 ft per inch

W. H. ...
C. H. ...

SUMMIT AVE.

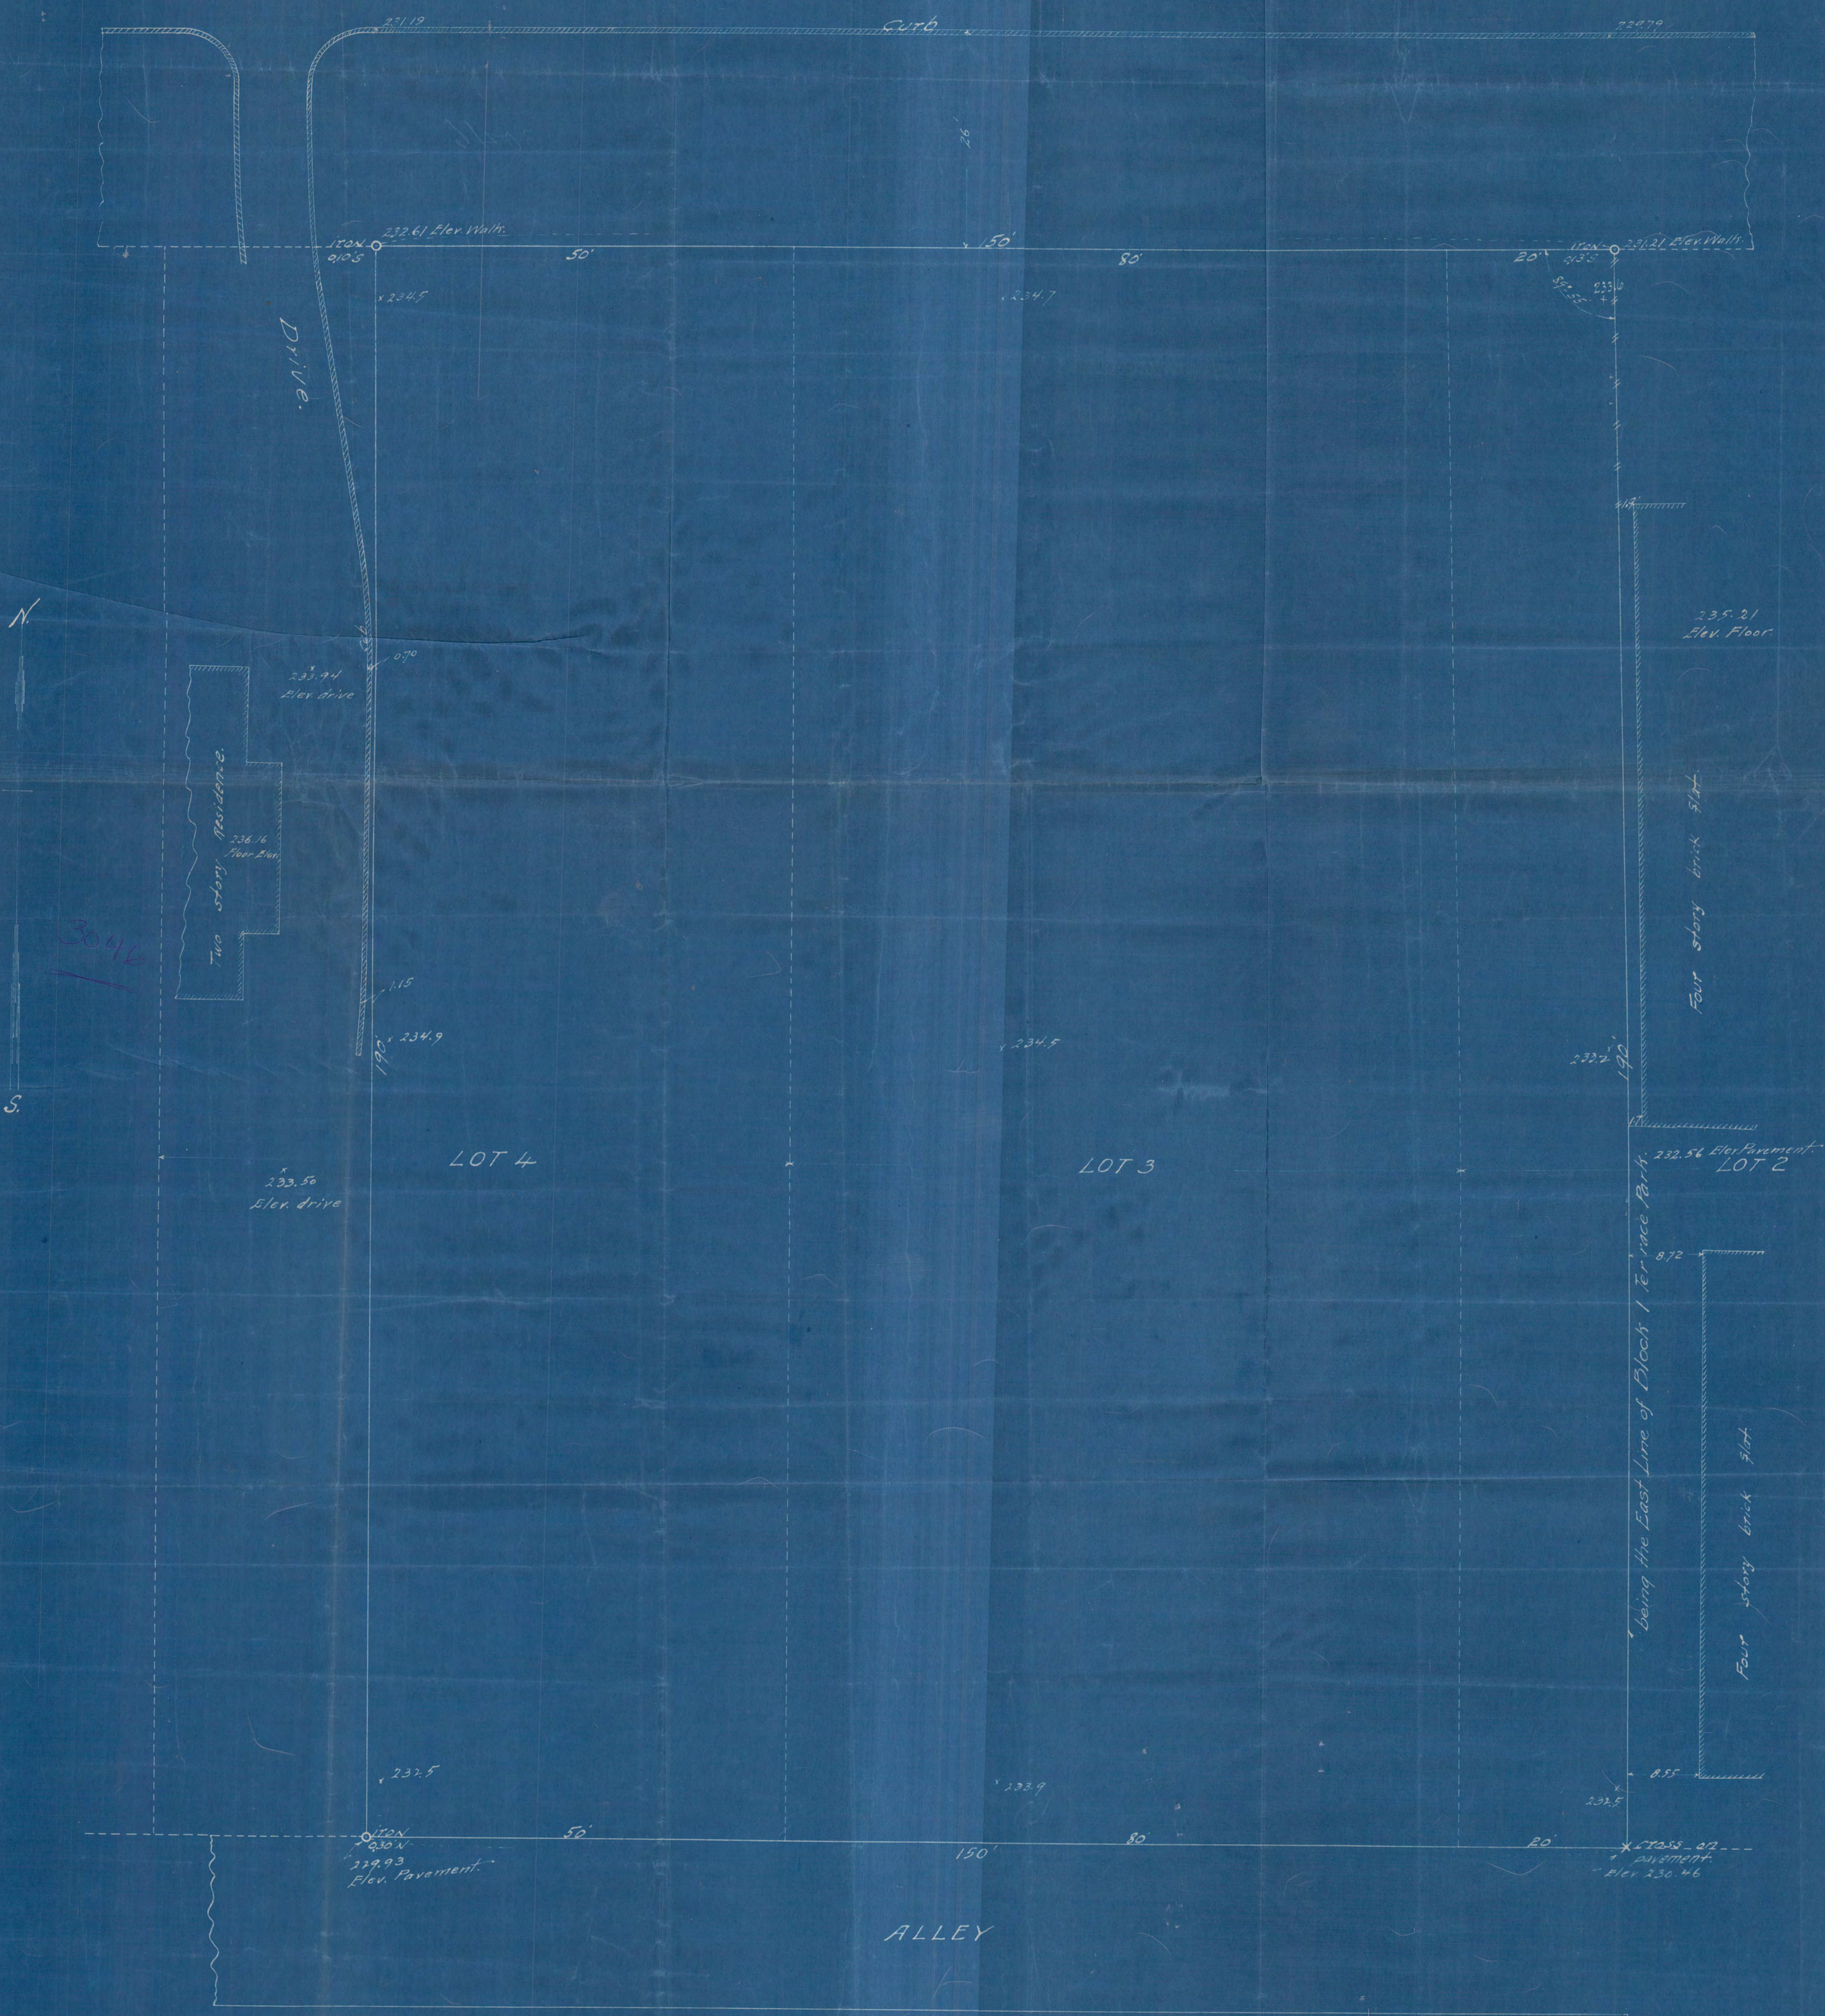

3046

3046