



# BALME'S ADDITION

#3076


SURVEY OF

N. 1/2 OF LOT 23 & ALL OF LOT 24 EXCEPT W. 35 FT. OF SAID LOT 24  
BLOCK 27

DEC. 18, 1925

JENS PEDERSEN  
SURV.

Scale 20' = 1"

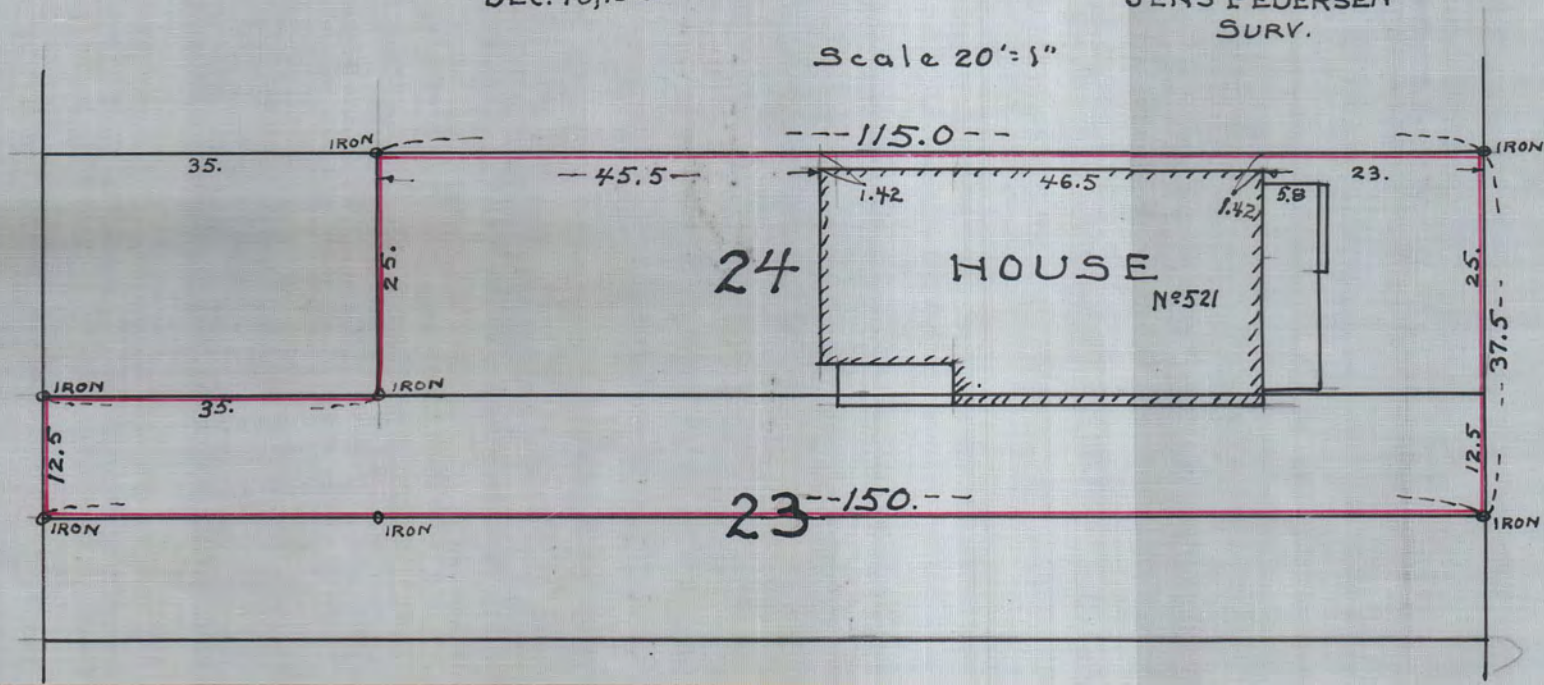

SMITH AVE.

