

LEECH'S ADD.

SURVEY OF

W. 40 FT. OF E. 62 $\frac{50}{100}$ FT. OF LOTS


13 & 14

BLOCK 2

JENS PEDERSEN
SURV

SCALE 20' = 1"

RAMSEY ST.

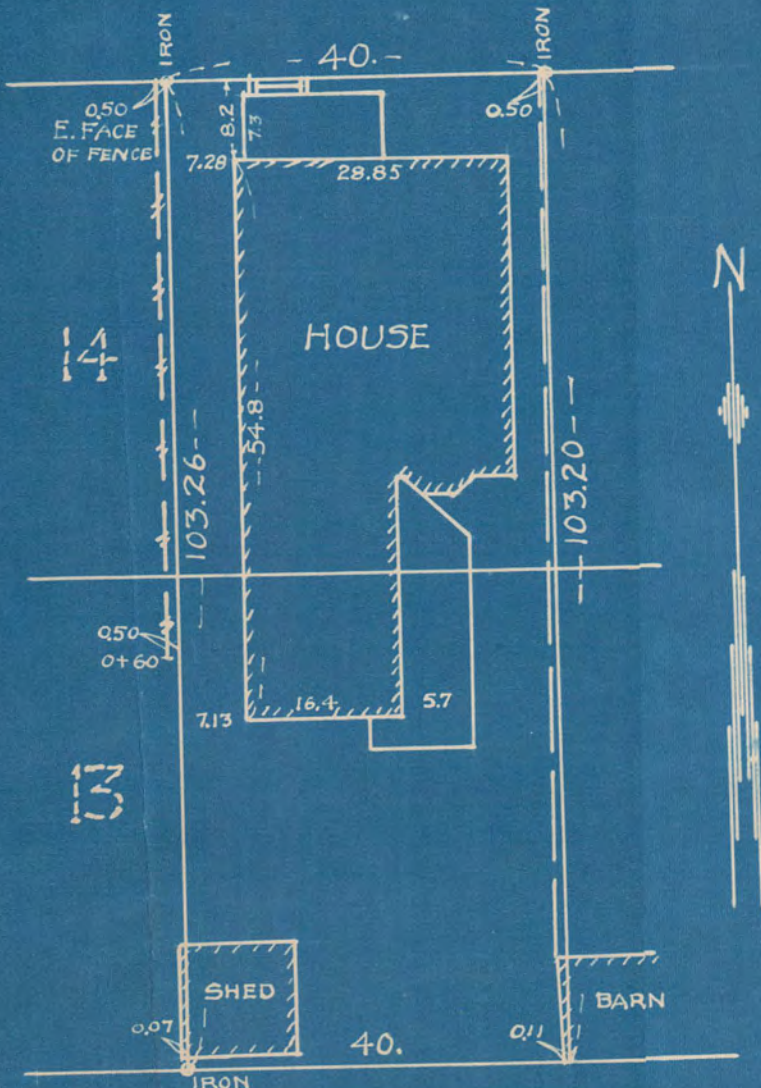

3126