

3132

LAMPREY'S SUB. OF BLOCK 11
ROBERT & RANDELL'S ADD.

SURVEY OF

EXHIBIT A.


LOTS 5 AND 16

August 9, 1924

JENS PEDERSEN
SURV.

SCALE 20' = 1"

E. 10TH ST.

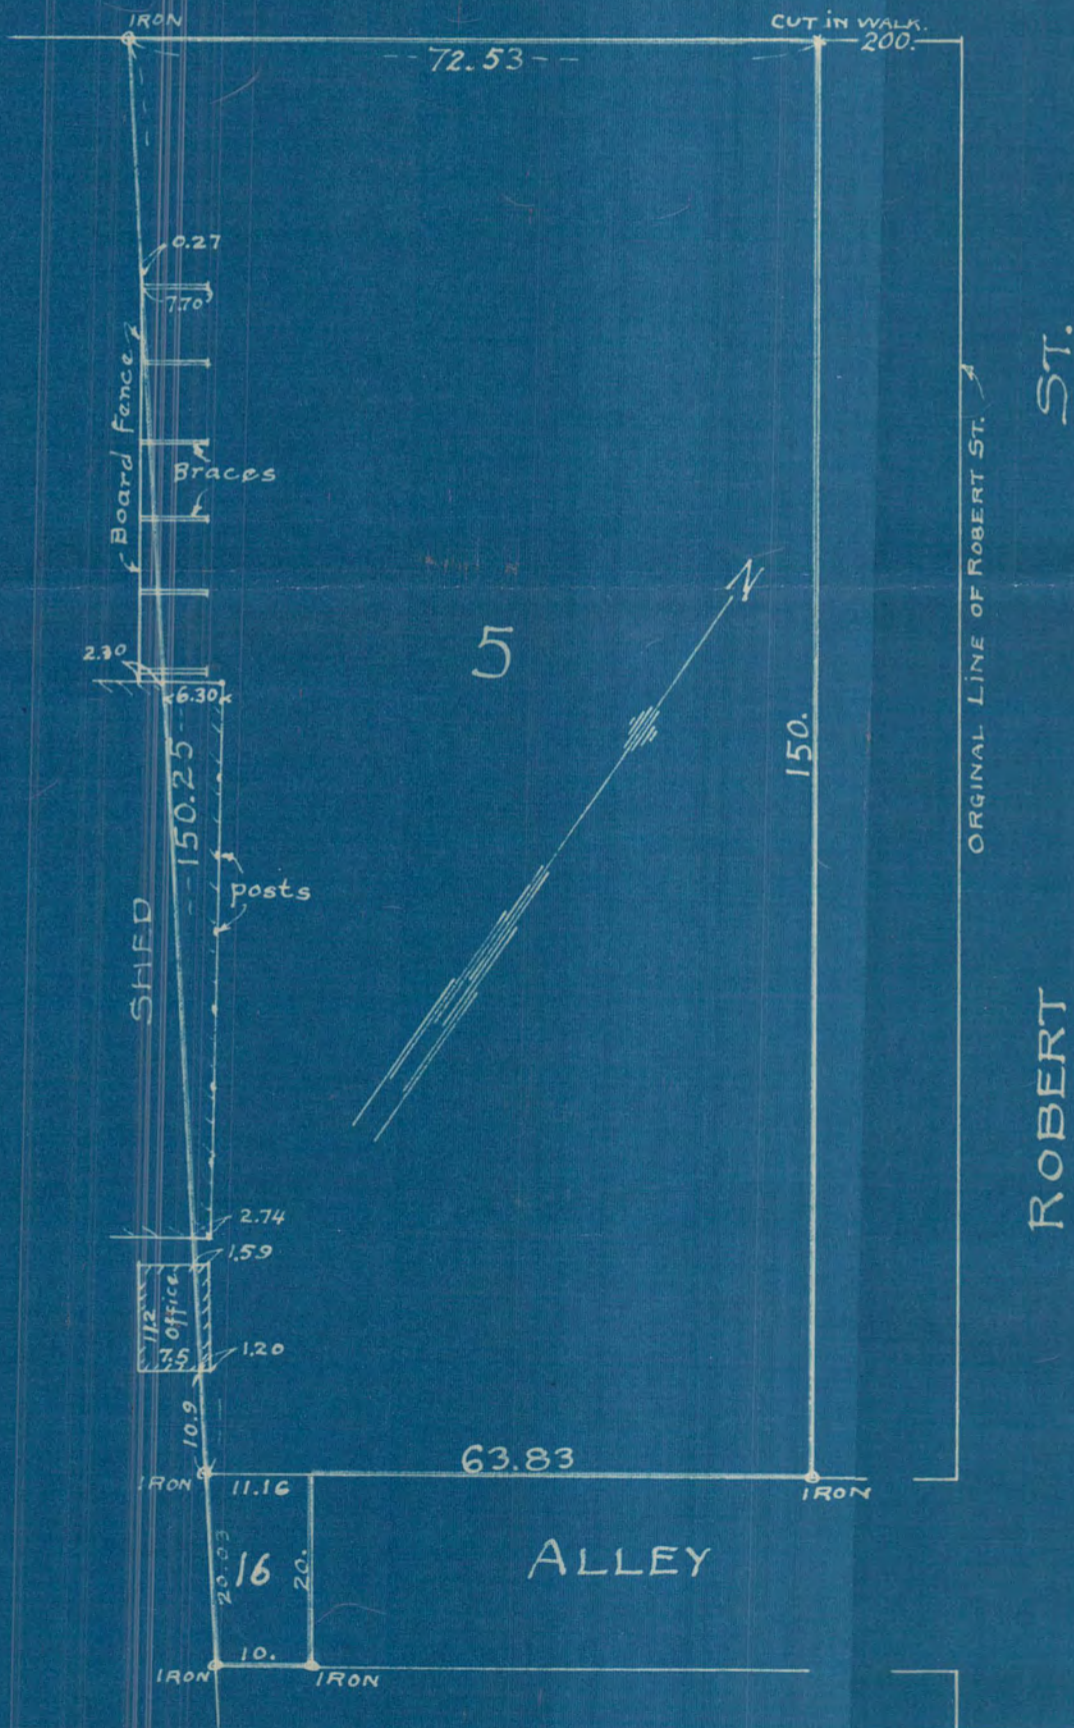

3132