

GOODHUE ST.

IRON

40.75

IRON

TRUE LINE 117.

FENCE  
SPIKE

2  
10

FENCE

COBBLE STONE WALL  
38.5 FT.

19.5  
100  
70  
2.80

GARAGE


130

SPIKE

90  
100



GARAGE

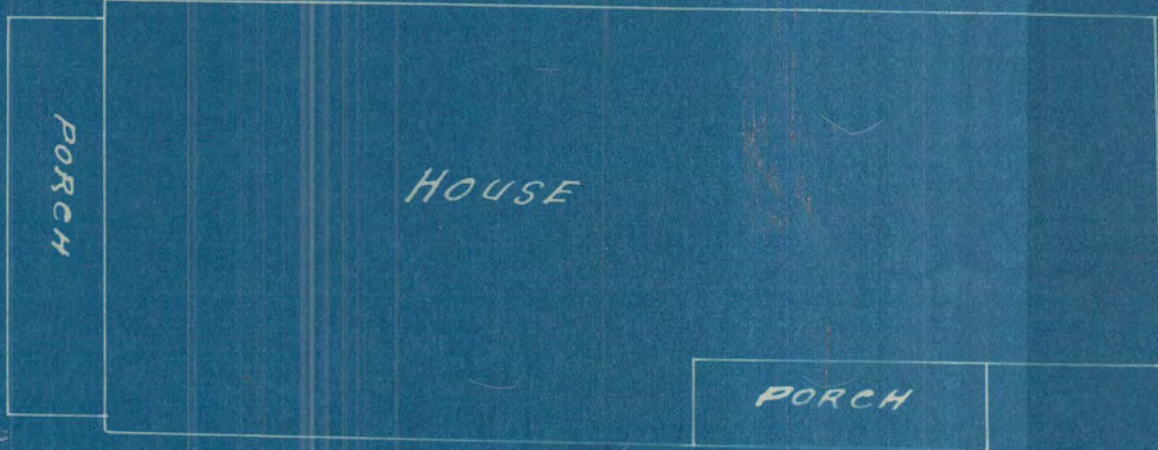

HOUSE

PORCH

PORCH

WEST 1/2 OF LOT 7 BLOCK  
2 WINSLOW'S ADDITION  
TO ST. PAUL RAMSEY CO.  
MINN.

FRANK J. TAVERNIER.  
Surveyor.

Office 509 Cour 2 Block.  
9-25-1924

40.75

IRON

117.

in

3146

#  
3146