

3171

# ABSTRACT OF TITLE

Prepared by The St. Paul Abstract Company

No. 1

To West 35 feet of lots 6 and 7 block 108, West St. Paul Proper.


State of Minnesota }  
County of Ramsey }

The St. Paul Abstract Company does hereby certify that the following exhibit, consisting of 9 sheets, from 1 to 9 inclusive (each of which bears its Corporate Seal), and 69 entries from 1 to 69 inclusive, is a true and complete Abstract of Title to the real estate described in No. 1 hereof, as shown by the records in the office of the Register of Deeds in and for said County and State, up to this 28th. day of June 1919 at 8 o'clock A. M.

THE ST. PAUL ABSTRACT COMPANY  
ABSTRACTERS.

*J. A. Suchcray*  
VICE-PRESIDENT

- 2 -

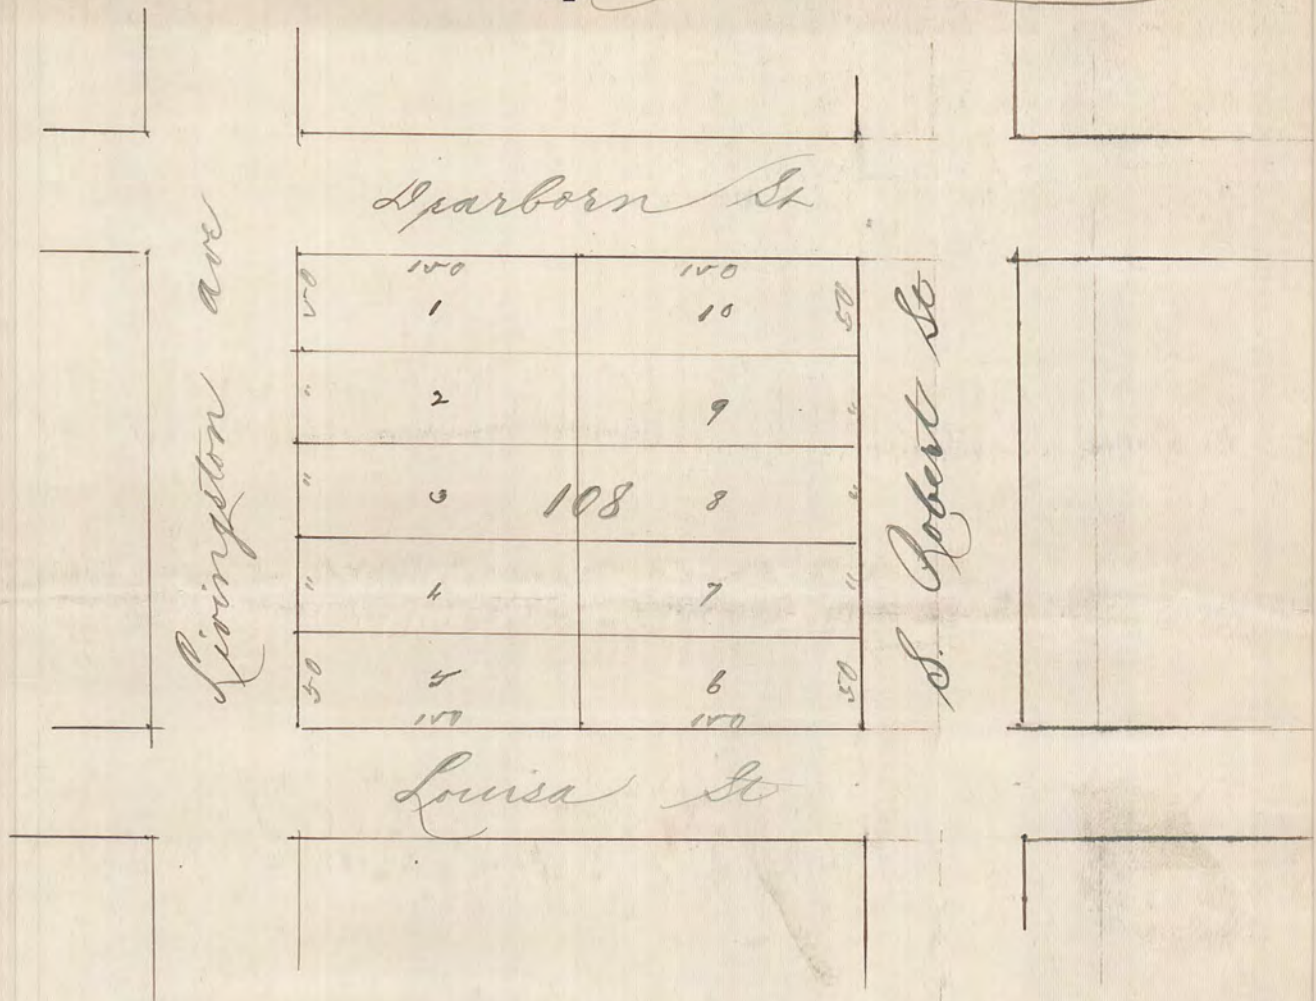

WEST ST. PAUL PROPER

3171

SURVEY OF


WLY. 35 FT. OF LOTS 6 & 7

BLOCK 108

OCT. 13, 1924

JENS PEDERSEN  
SURV.

SCALE 10'=1"

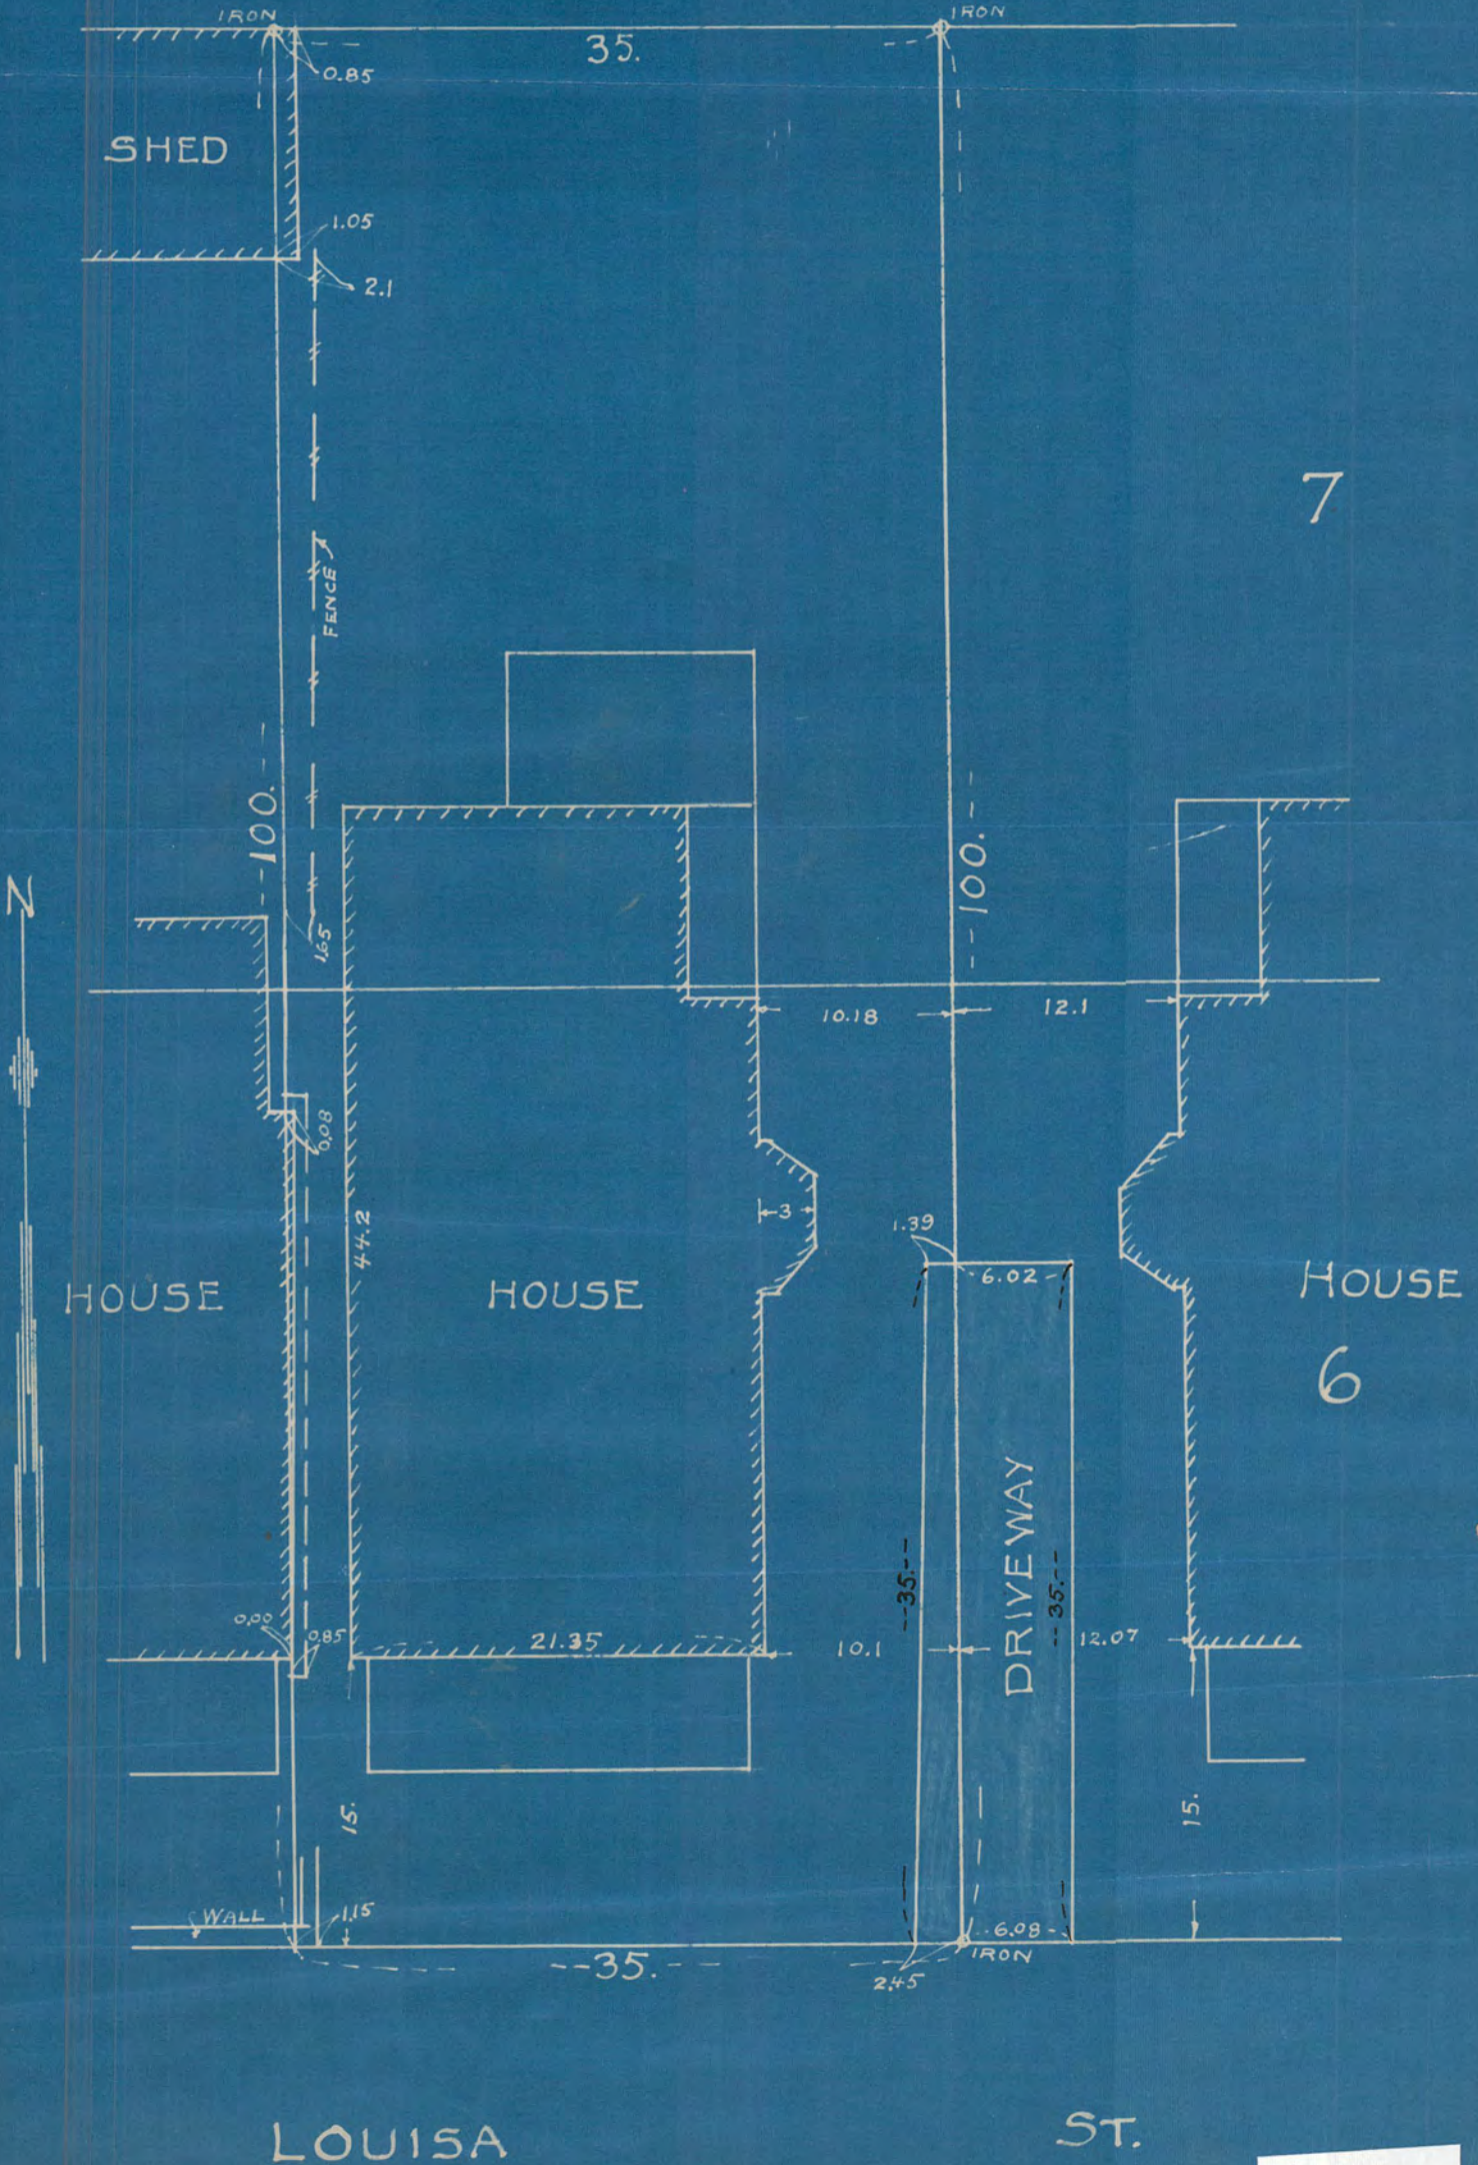

7

HOUSE  
6

LOUISA

ST.

#  
3171