

OFFICE OF RAMSEY COUNTY ENGINEER
 RAMSEY COUNTY MINN.
 PAUL H. COATES
 COUNTY ENGINEER.


~ CERTIFICATE OF SURVEY ~

~ DESCRIPTION ~

The North 50.0 ft. of Lots 6 & 7, Block 19, Olivier's Addition to West St. Paul; Also that part of Lot 8, Block 19, Olivier's Addition to West St. Paul described as follows. Commencing at the N.W. Cor. of Lot 8, Block 19, Olivier's Addition to West St. Paul, thence East 15 ft.; thence South and parallel to the West line of said Lot 8 to the North line of Lot 1 of Marion Addition to West St. Paul; thence Northwesterly along the North line of said Lot 1 of Marion Addition to West St. Paul to the N.W. Cor. thereof; thence North along the West line of said Lot 1 extended Northerly to the place of beginning.



60' SOUTH AVE.

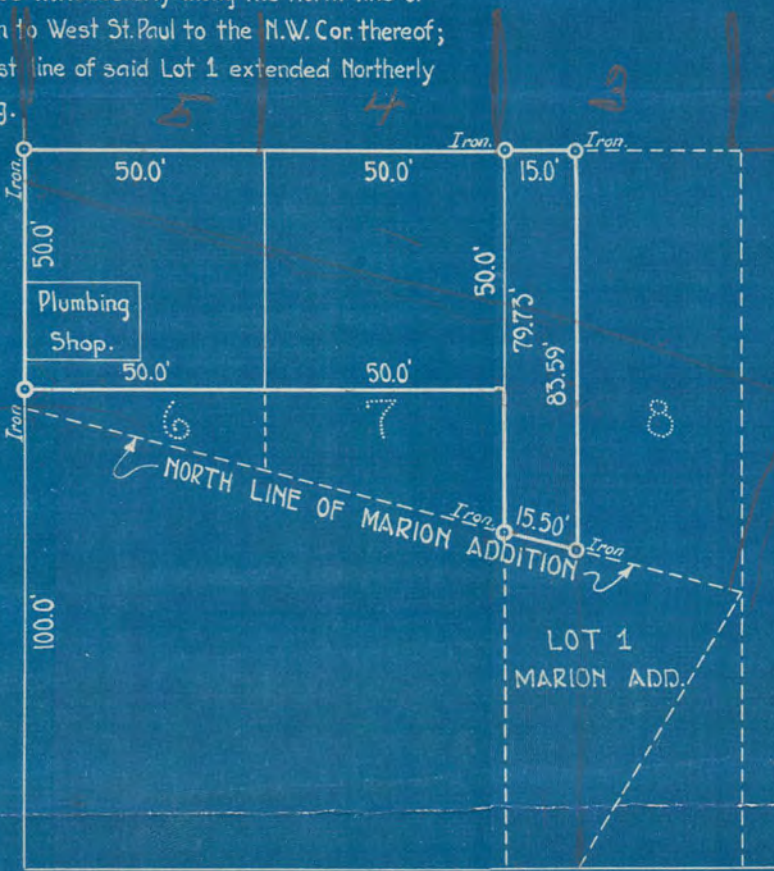

60' KING ST.

I hereby certify to having surveyed the property herein described and have placed iron monuments at the corners as shown, and the same is correct.

Robert Holterhoff Surveyor.

State of Minnesota }
 County of Ramsey } On this 16 day of June A.D. 1925, before me personally appeared, Robert Holterhoff, to me well known, and acknowledged that he executed the foregoing certificate as his own free act and deed.

Elmer G. Anderson
 Notary Public, Ramsey Co. Minnesota - My Commission expires Oct 3, 1922

3210

ANDERSON
 Notary Public, Ramsey County, Minn.
 My Commission Expires Oct 3, 1922
 H.R.P.