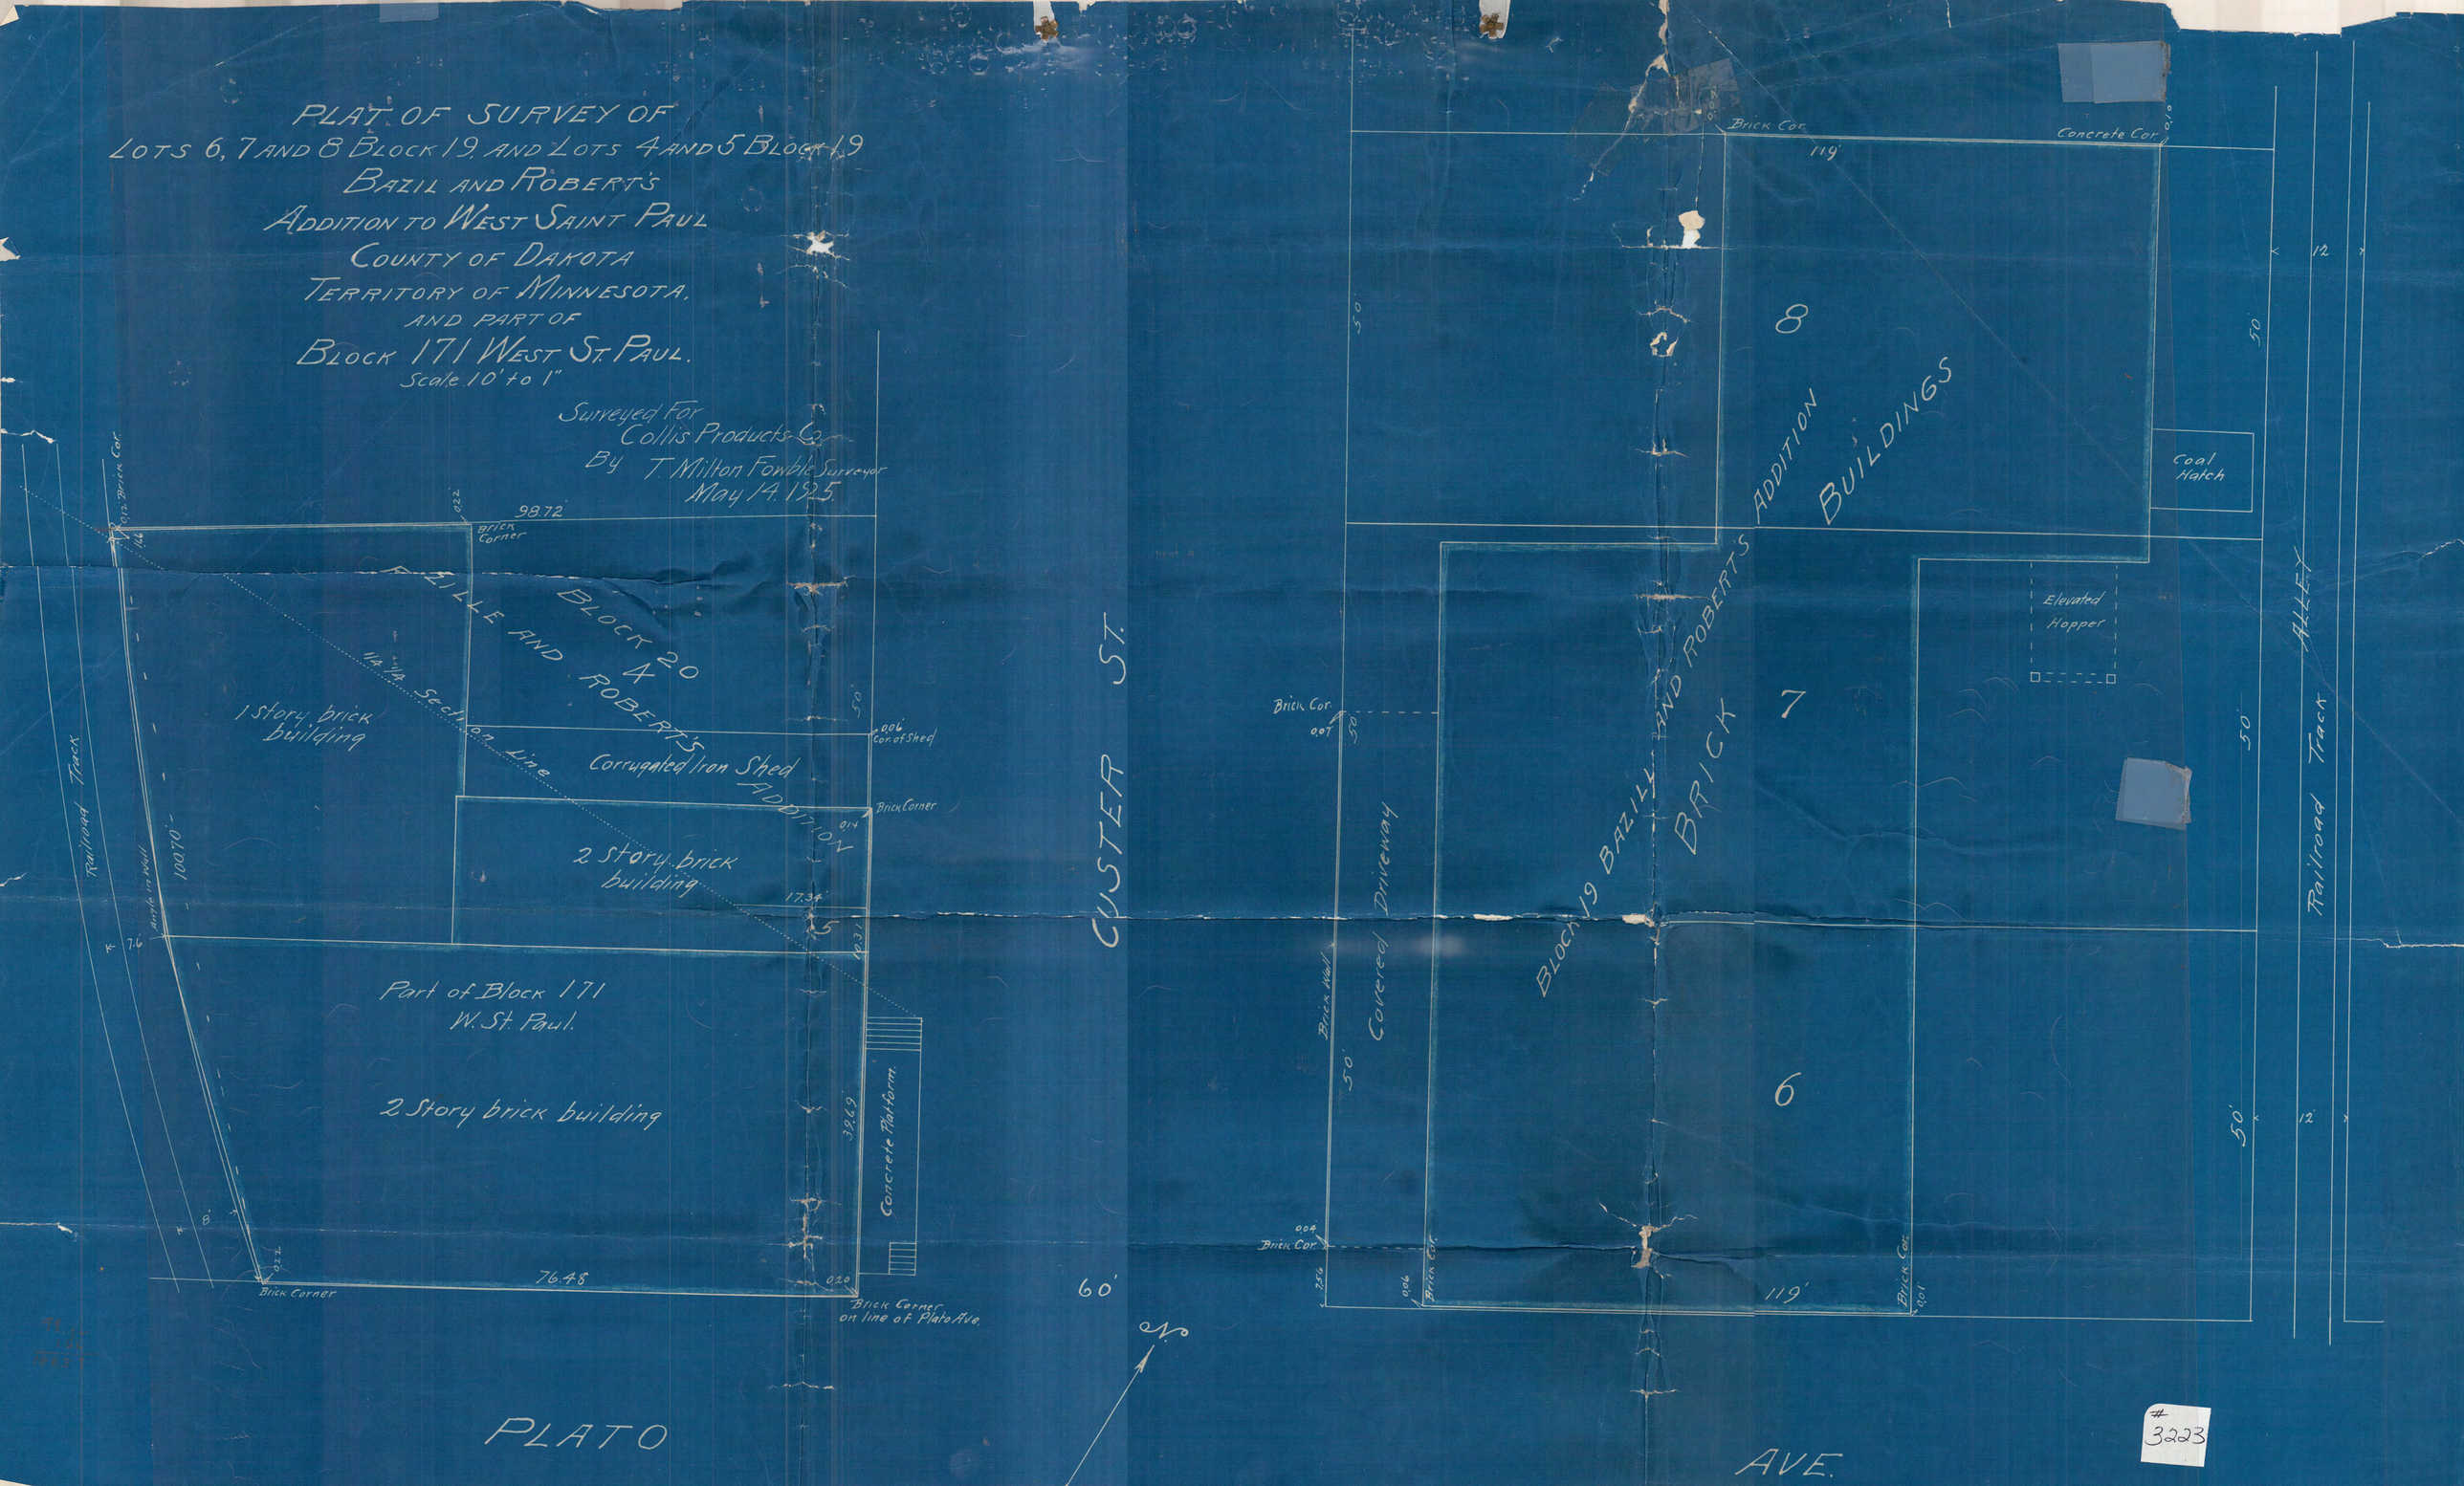
PLAT OF SURVEY OF
LOTS 6, 7 AND 8 BLOCK 19, AND LOTS 4 AND 5 BLOCK 19
BAZIL AND ROBERT'S
ADDITION TO WEST SAINT PAUL
COUNTY OF DAKOTA
TERRITORY OF MINNESOTA,
AND PART OF
BLOCK 171 WEST ST. PAUL.
Scale 10' to 1"
Surveyed For
Collis Products Co.
By T. Milton Fowble Surveyor
May 14, 1925
BLOCK 20
BAZILLE AND ROBERT'S ADDITION
1 Story brick building
Corrugated Iron Shed
2 Story brick building
Part of Block 171
W. St. Paul.
2 Story brick building
Concrete Platform
Railroad Track
Brick Corner
Brick Corner on line of Plato Ave.
98.72
76.48
100.70
17.34
39.69
CUSTER ST.
PLATO AVE.
60'
N
BLOCK 19 BAZILLE AND ROBERT'S ADDITION
BRICK BUILDINGS
8
7
6
Brick Cor.
Concrete Cor.
Coal Hatch
Elevated Hopper
Covered Driveway
Brick Wall
119'
50'
12'
ALLEY
Railroad Track
#3223