

SURVEY OF

Part of Lots 1 + 6 Ziegler and Mainzer's Sub. of block 13 of Winslow's Add. described as follows to wit; Commencing on the S. line of Von Minden St. 50 ft. Ely. from the NW. Corner of Lot 1 Ziegler and Mainzer's Sub. of Block 13 Winslow Add. to St. Paul, running thence Ely. along the S. Line of Von Minden St. 50 feet; thence running Sly. at right angles with the S. line of Von Minden St. 75 ft. thence running Wly. and parallel with the S. line of Von Minden St. 50 ft. thence running Nly. and at right angles with last named line 75 ft. to place of beginning.


June 1926

Scale 20' = 1"

JENS PEDERSEN
SURVEYOR

VON MINDEN

ST.

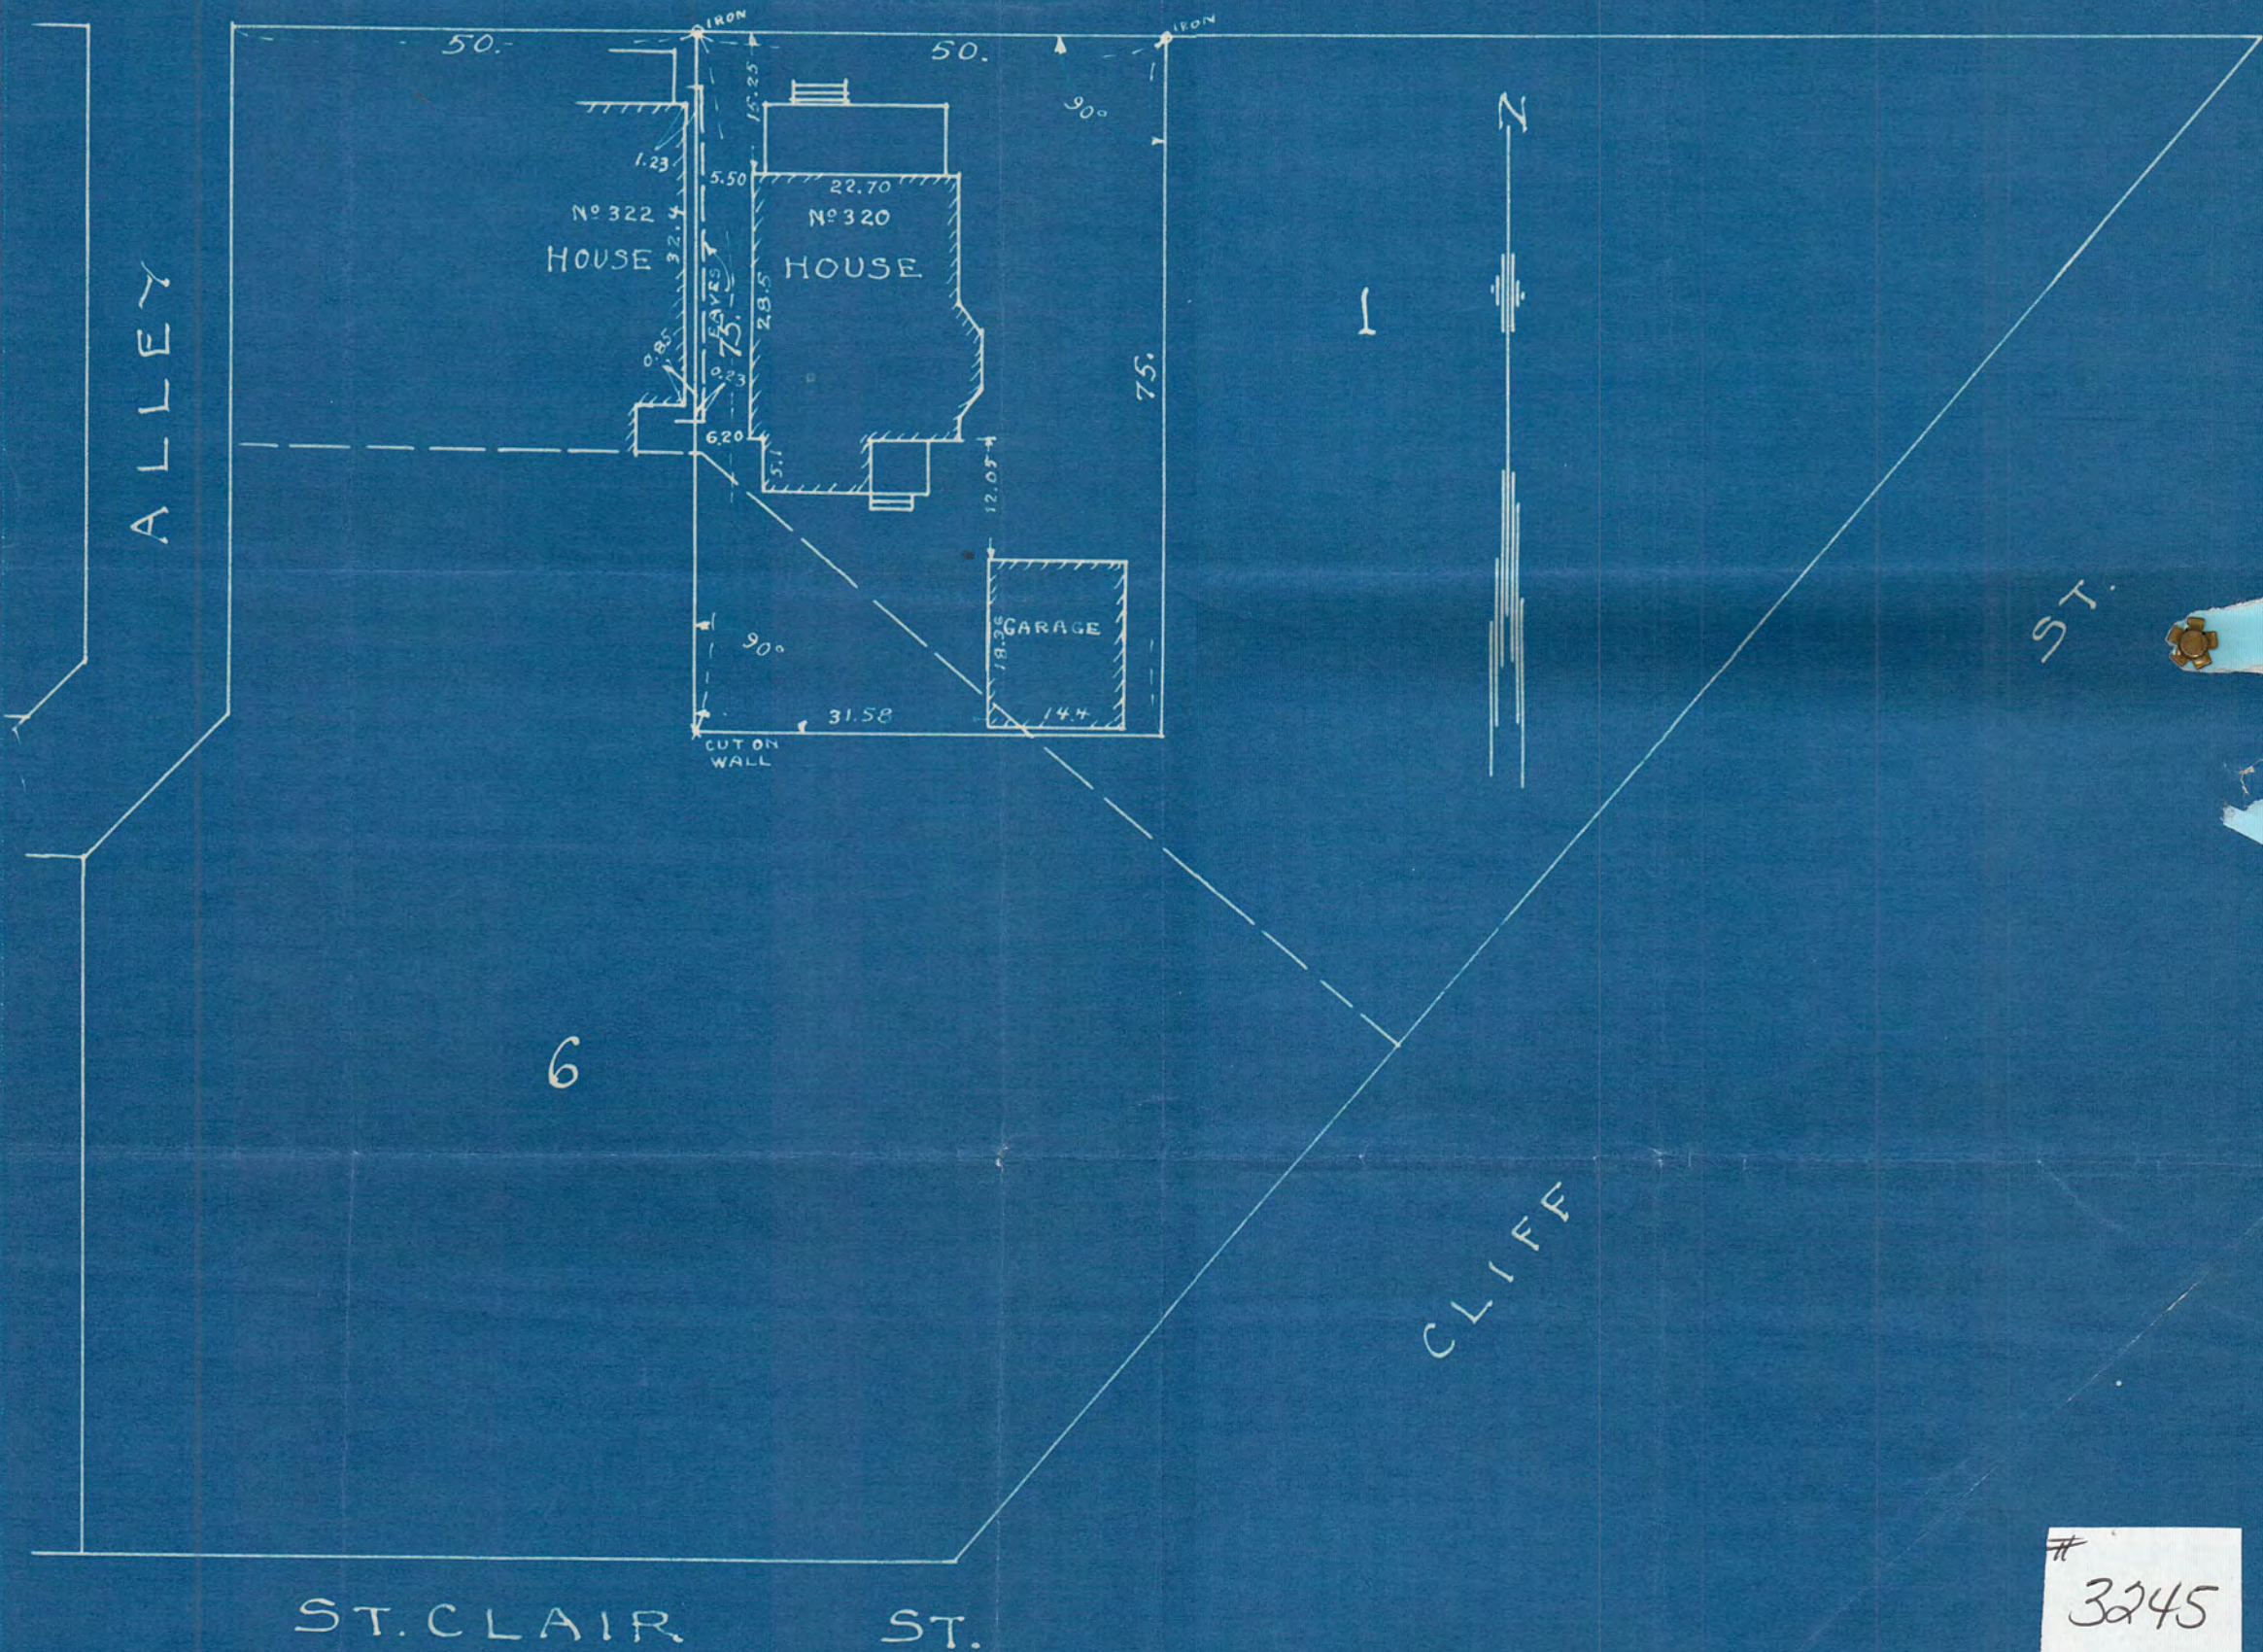

3245