

CERTIFICATE OF SURVEY


Franklyn J. Armstrong
 CIVIL ENGINEER
 and
 SURVEYOR
 Successor to
 D. L. CURTICE
 J. H. ARMSTRONG

GUARDIAN-LIFE BLDG.

ST. PAUL
 MINN.

DECATUR ST.

Present Southeastly
 Line of Decatur St.

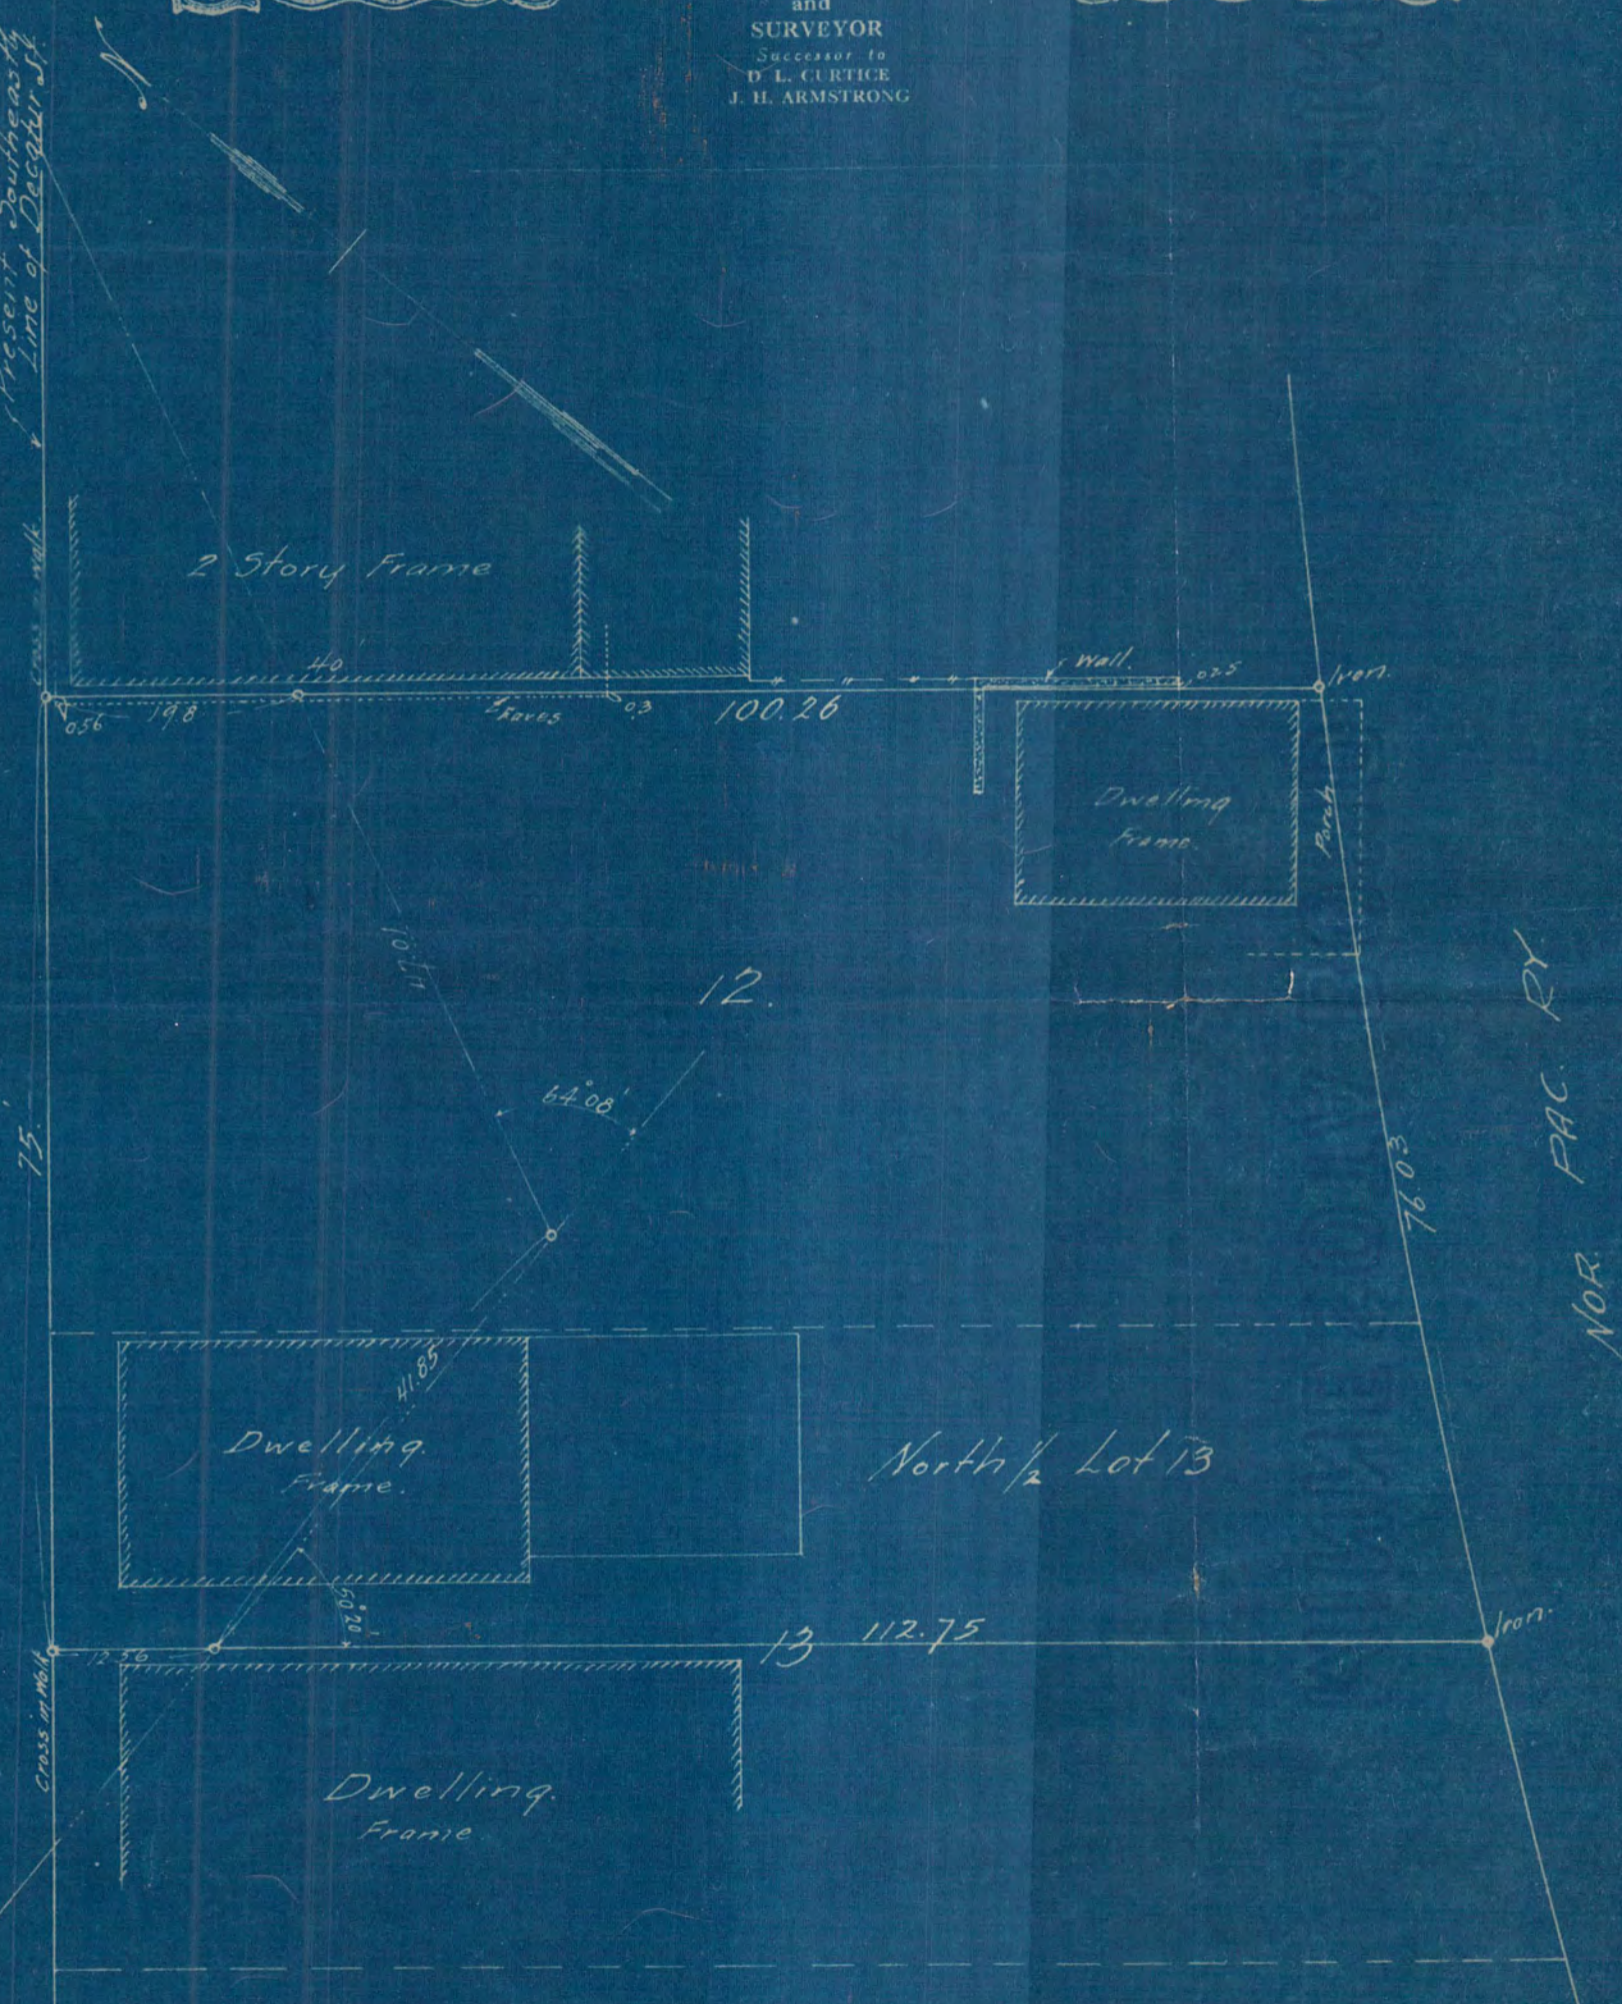

LOT 12 ^{cont.} NORTHLY 1/2 LOT 13 BLOCK 6
 IRVINE'S 2ND ADDITION.
 Scale 15 ft per inch.

Nov. 1924.

F. J. Armstrong
 Civil Engr.

3266