

# RICE AND IRVINE'S ADD.

SURVEY OF  
LOT 4 & W. 20 INCHES OF LOT 3

Nov. 18, 1925


BLOCK 4

JENS PEDERSEN  
SURV.

Scale 10' = 1"

W. NINTH

ST.

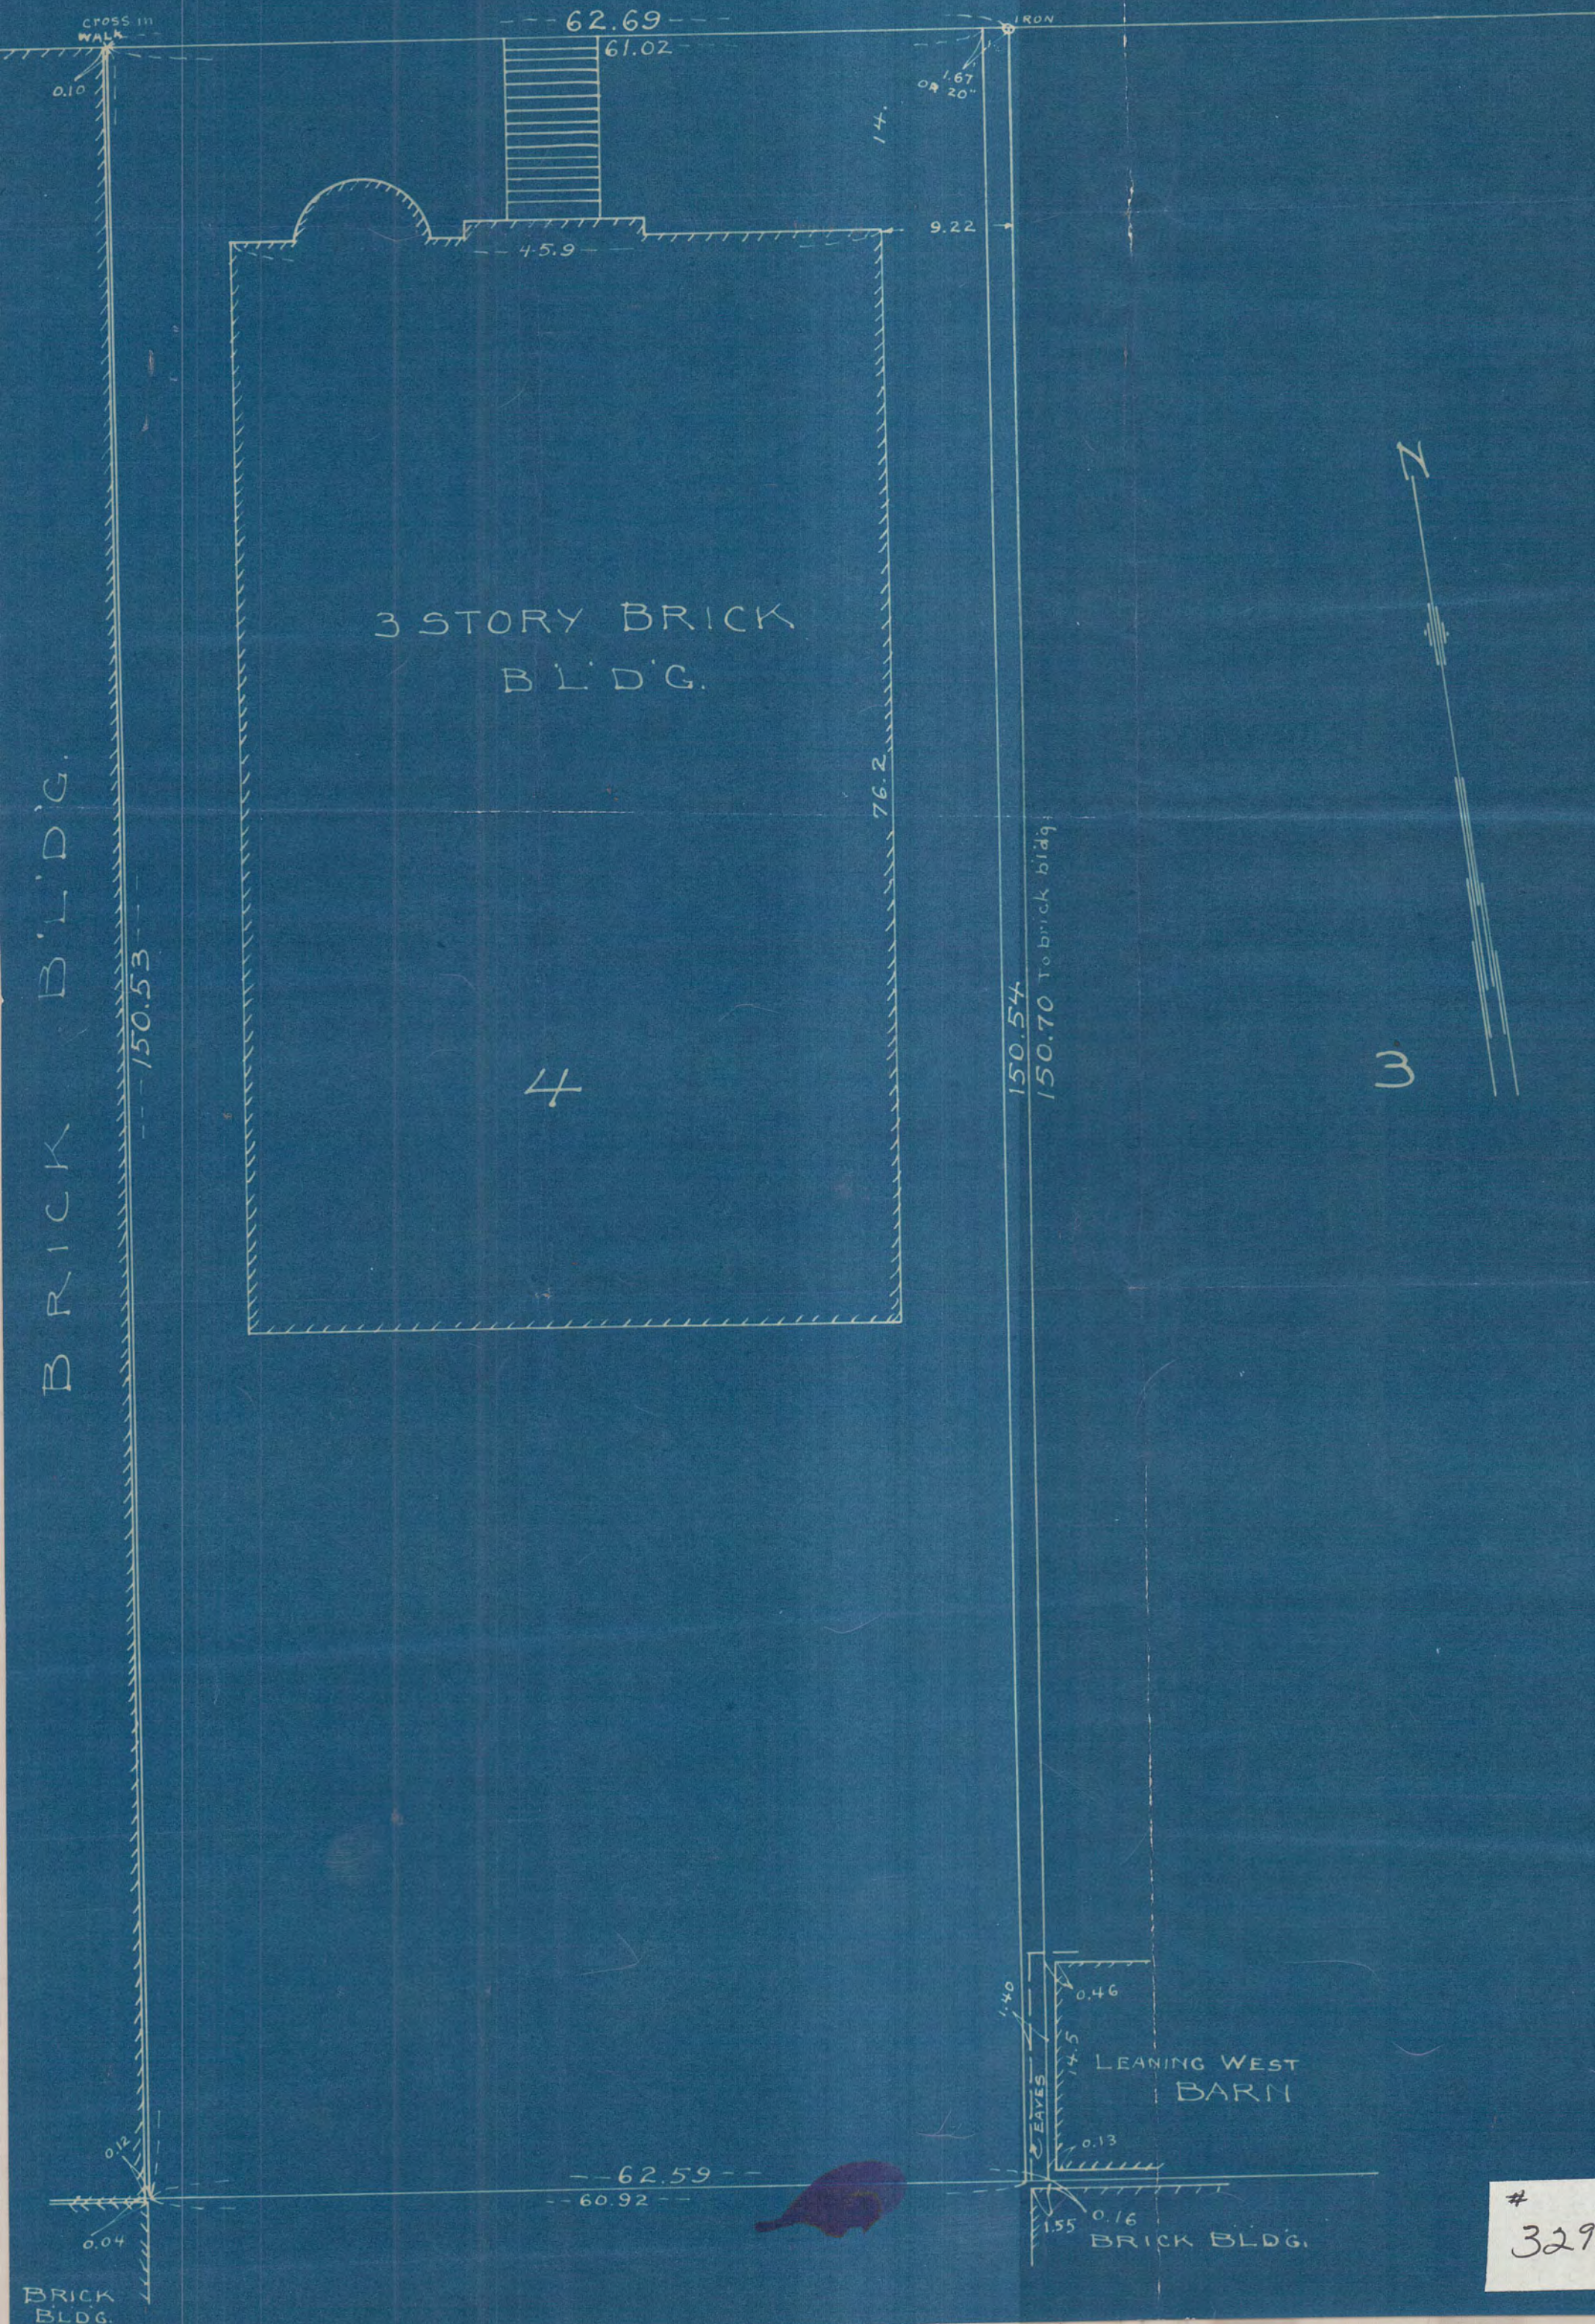

#  
3295