

# ANNA E. RAMSEY'S ADD.

SURVEY OF  
N. 90 FT. OF LOTS 1, 2, 3 & 4 EXCEPT PART  
TAKEN FOR PARKWAY BLOCK 18  
Aug. 1926


JENS PEDERSEN  
SURVEYOR

*Exhibit A.*

Scale 20' = 1"

LAUREL

AVE.

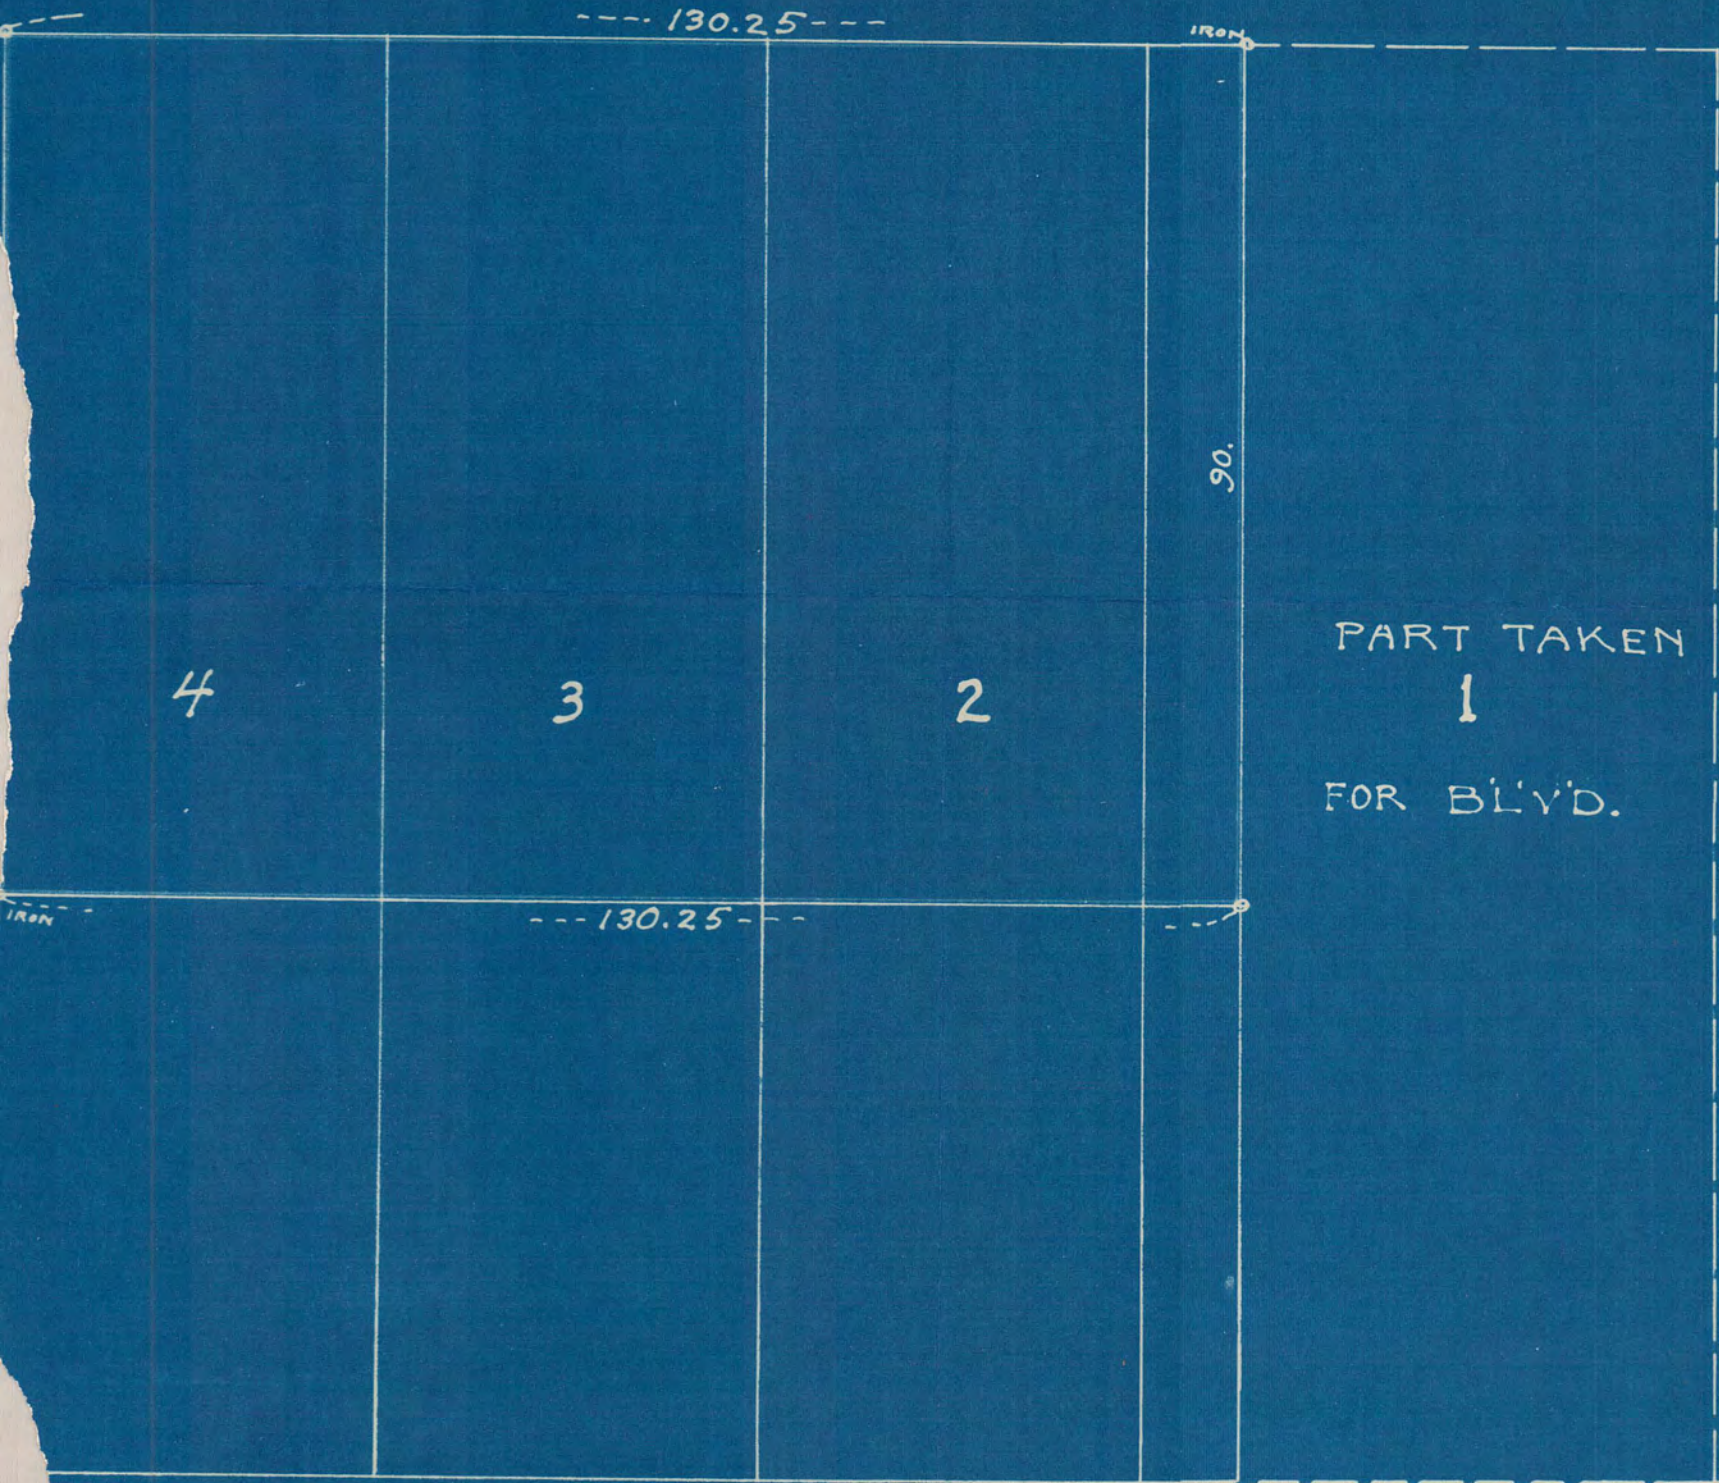

LEXINGTON  
AVE.

PART TAKEN  
1  
FOR BL'VD.

ALLEY

#  
3400