




# CERTIFICATE of SURVEY

Franklyn J. Armstrong  
CIVIL ENGINEER AND SURVEYOR  
GUARDIAN LIFE BLDG. ST. PAUL, MINN.

ST. PETER ST.

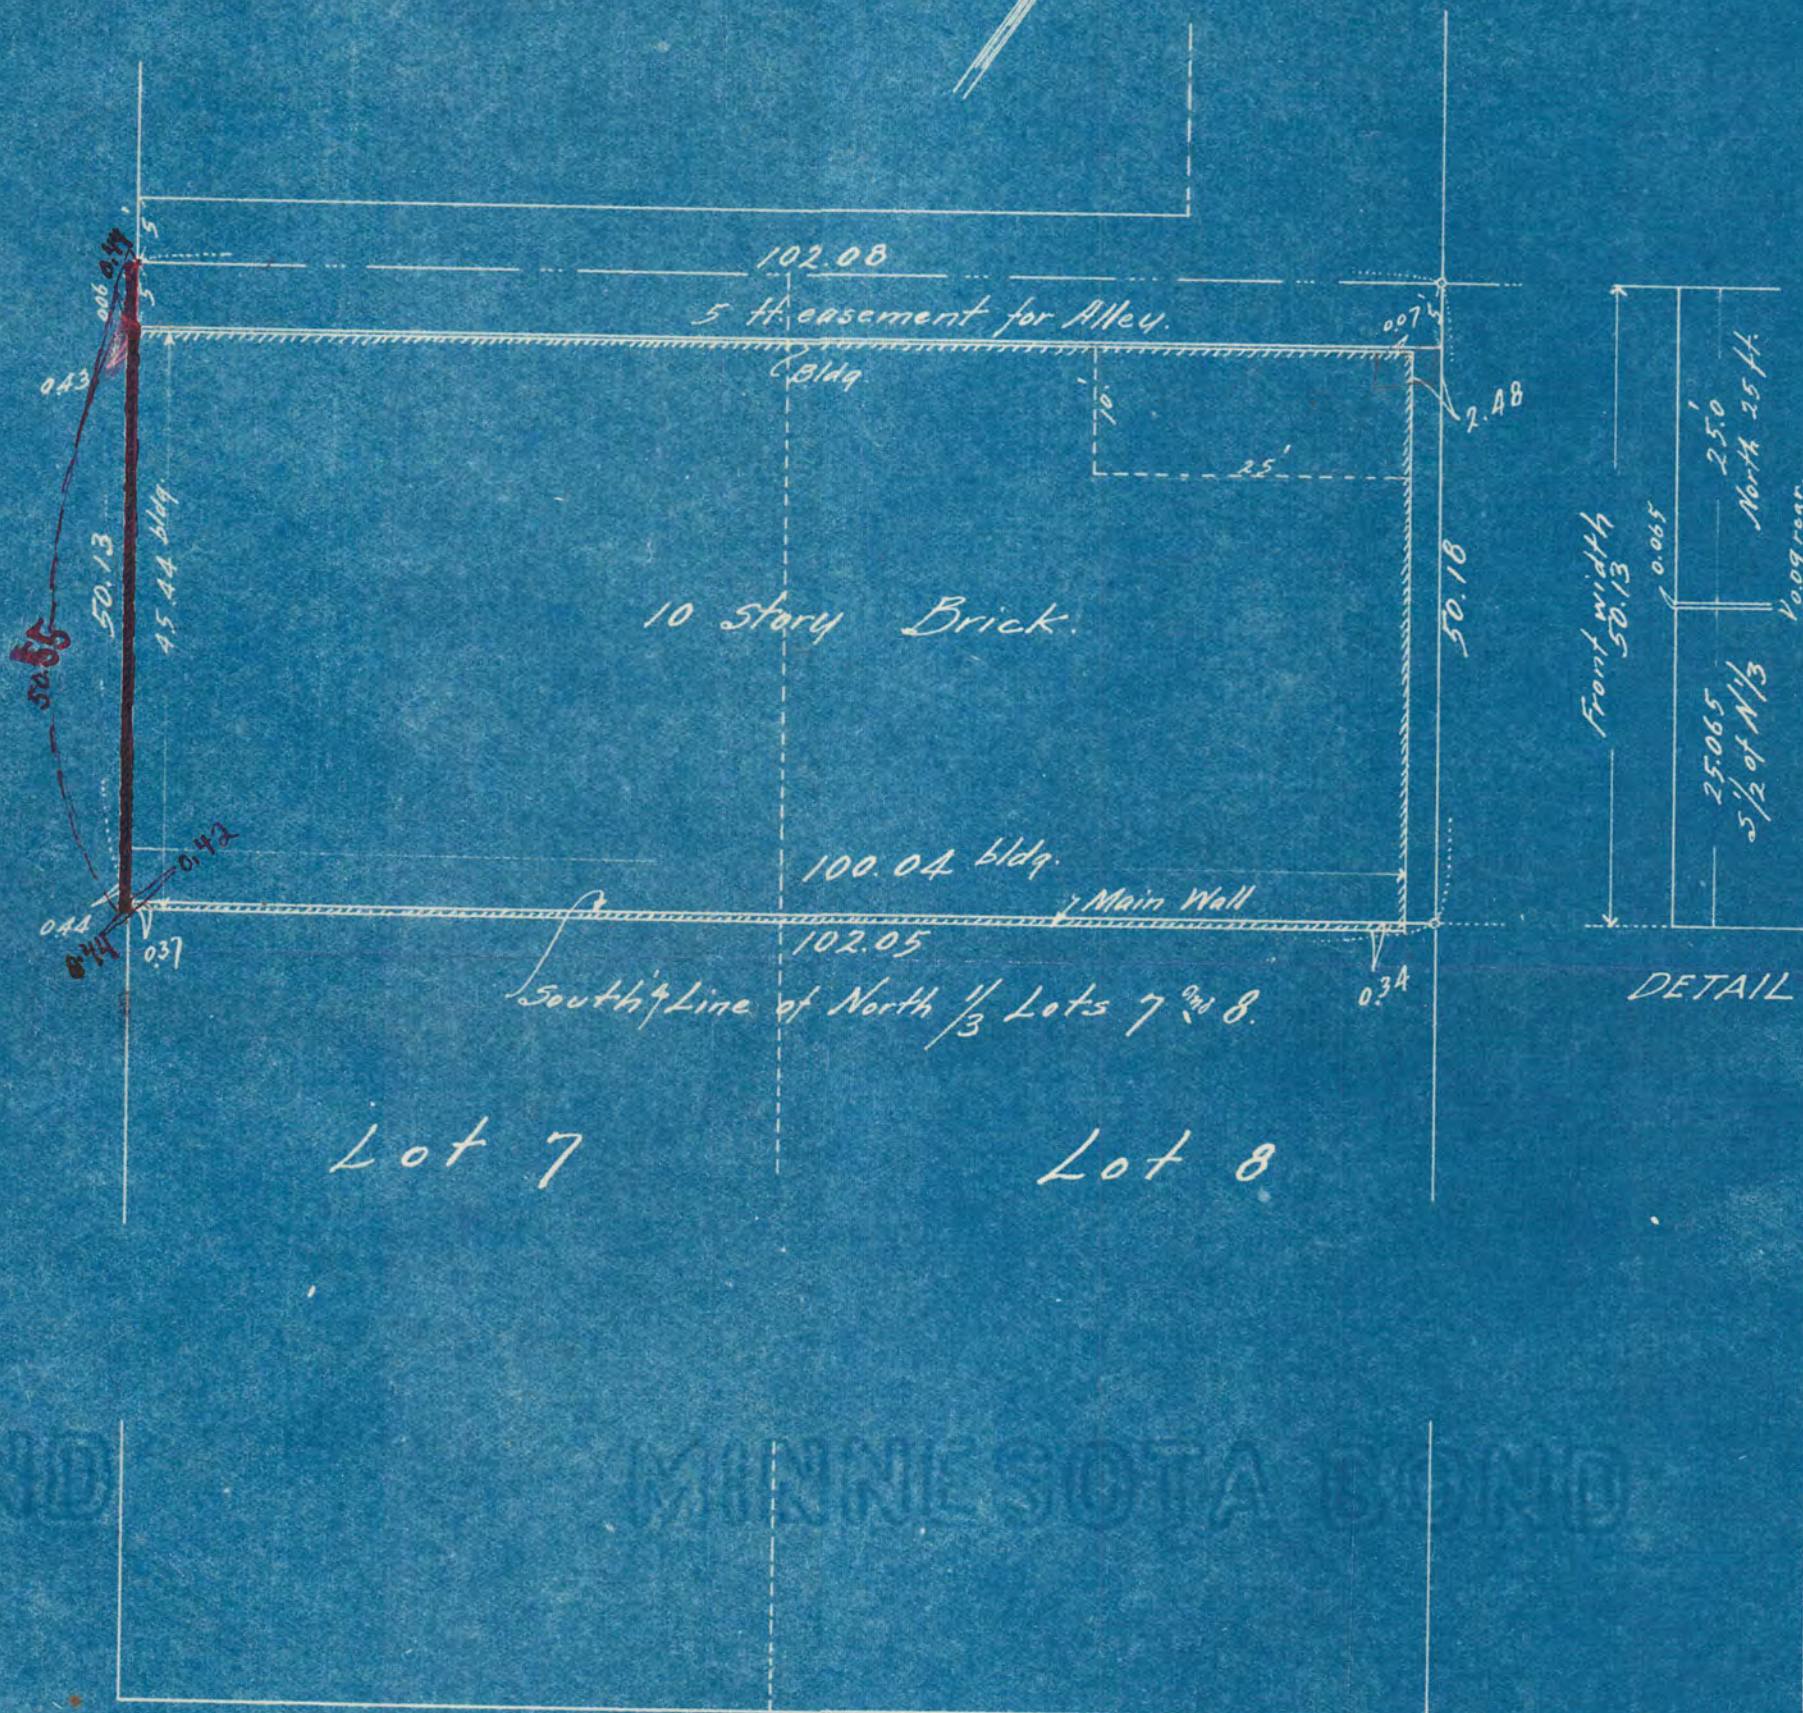

Lot 7

Lot 8

EXCHANGE ST.

I hereby certify that on the 19<sup>th</sup> day of May 1926  
 I made a survey of the following described premises to wit: N 25 ft.  
5 1/2 of N 1/3 Lots 7-8 Blk. 5 Bazille & Guerin  
 and that the plat hereto attached is a true and correct plat of said  
 premises: photograph of said premises and that the lines shown on said plat  
are the lines of said premises

Subscribed and sworn to before me  
 this \_\_\_\_\_ day of \_\_\_\_\_ 19\_\_\_\_  
 \_\_\_\_\_  
 Notary Public  
 My commission expires \_\_\_\_\_

*F. J. Armstrong*  
 Civil Engineer  
 Patent Applied For

# 3407