

MANSON & SIMONTON ADD.

SURVEY OF

LOTS 11 & 12 EXCEPT PART TAKEN BY C.M.&ST.P.RR.

Sept. 1926


BLOCK 6

JENS PEDERSEN
SURVEYOR

Scale 20' = 1"

LINCOLN

AVE.

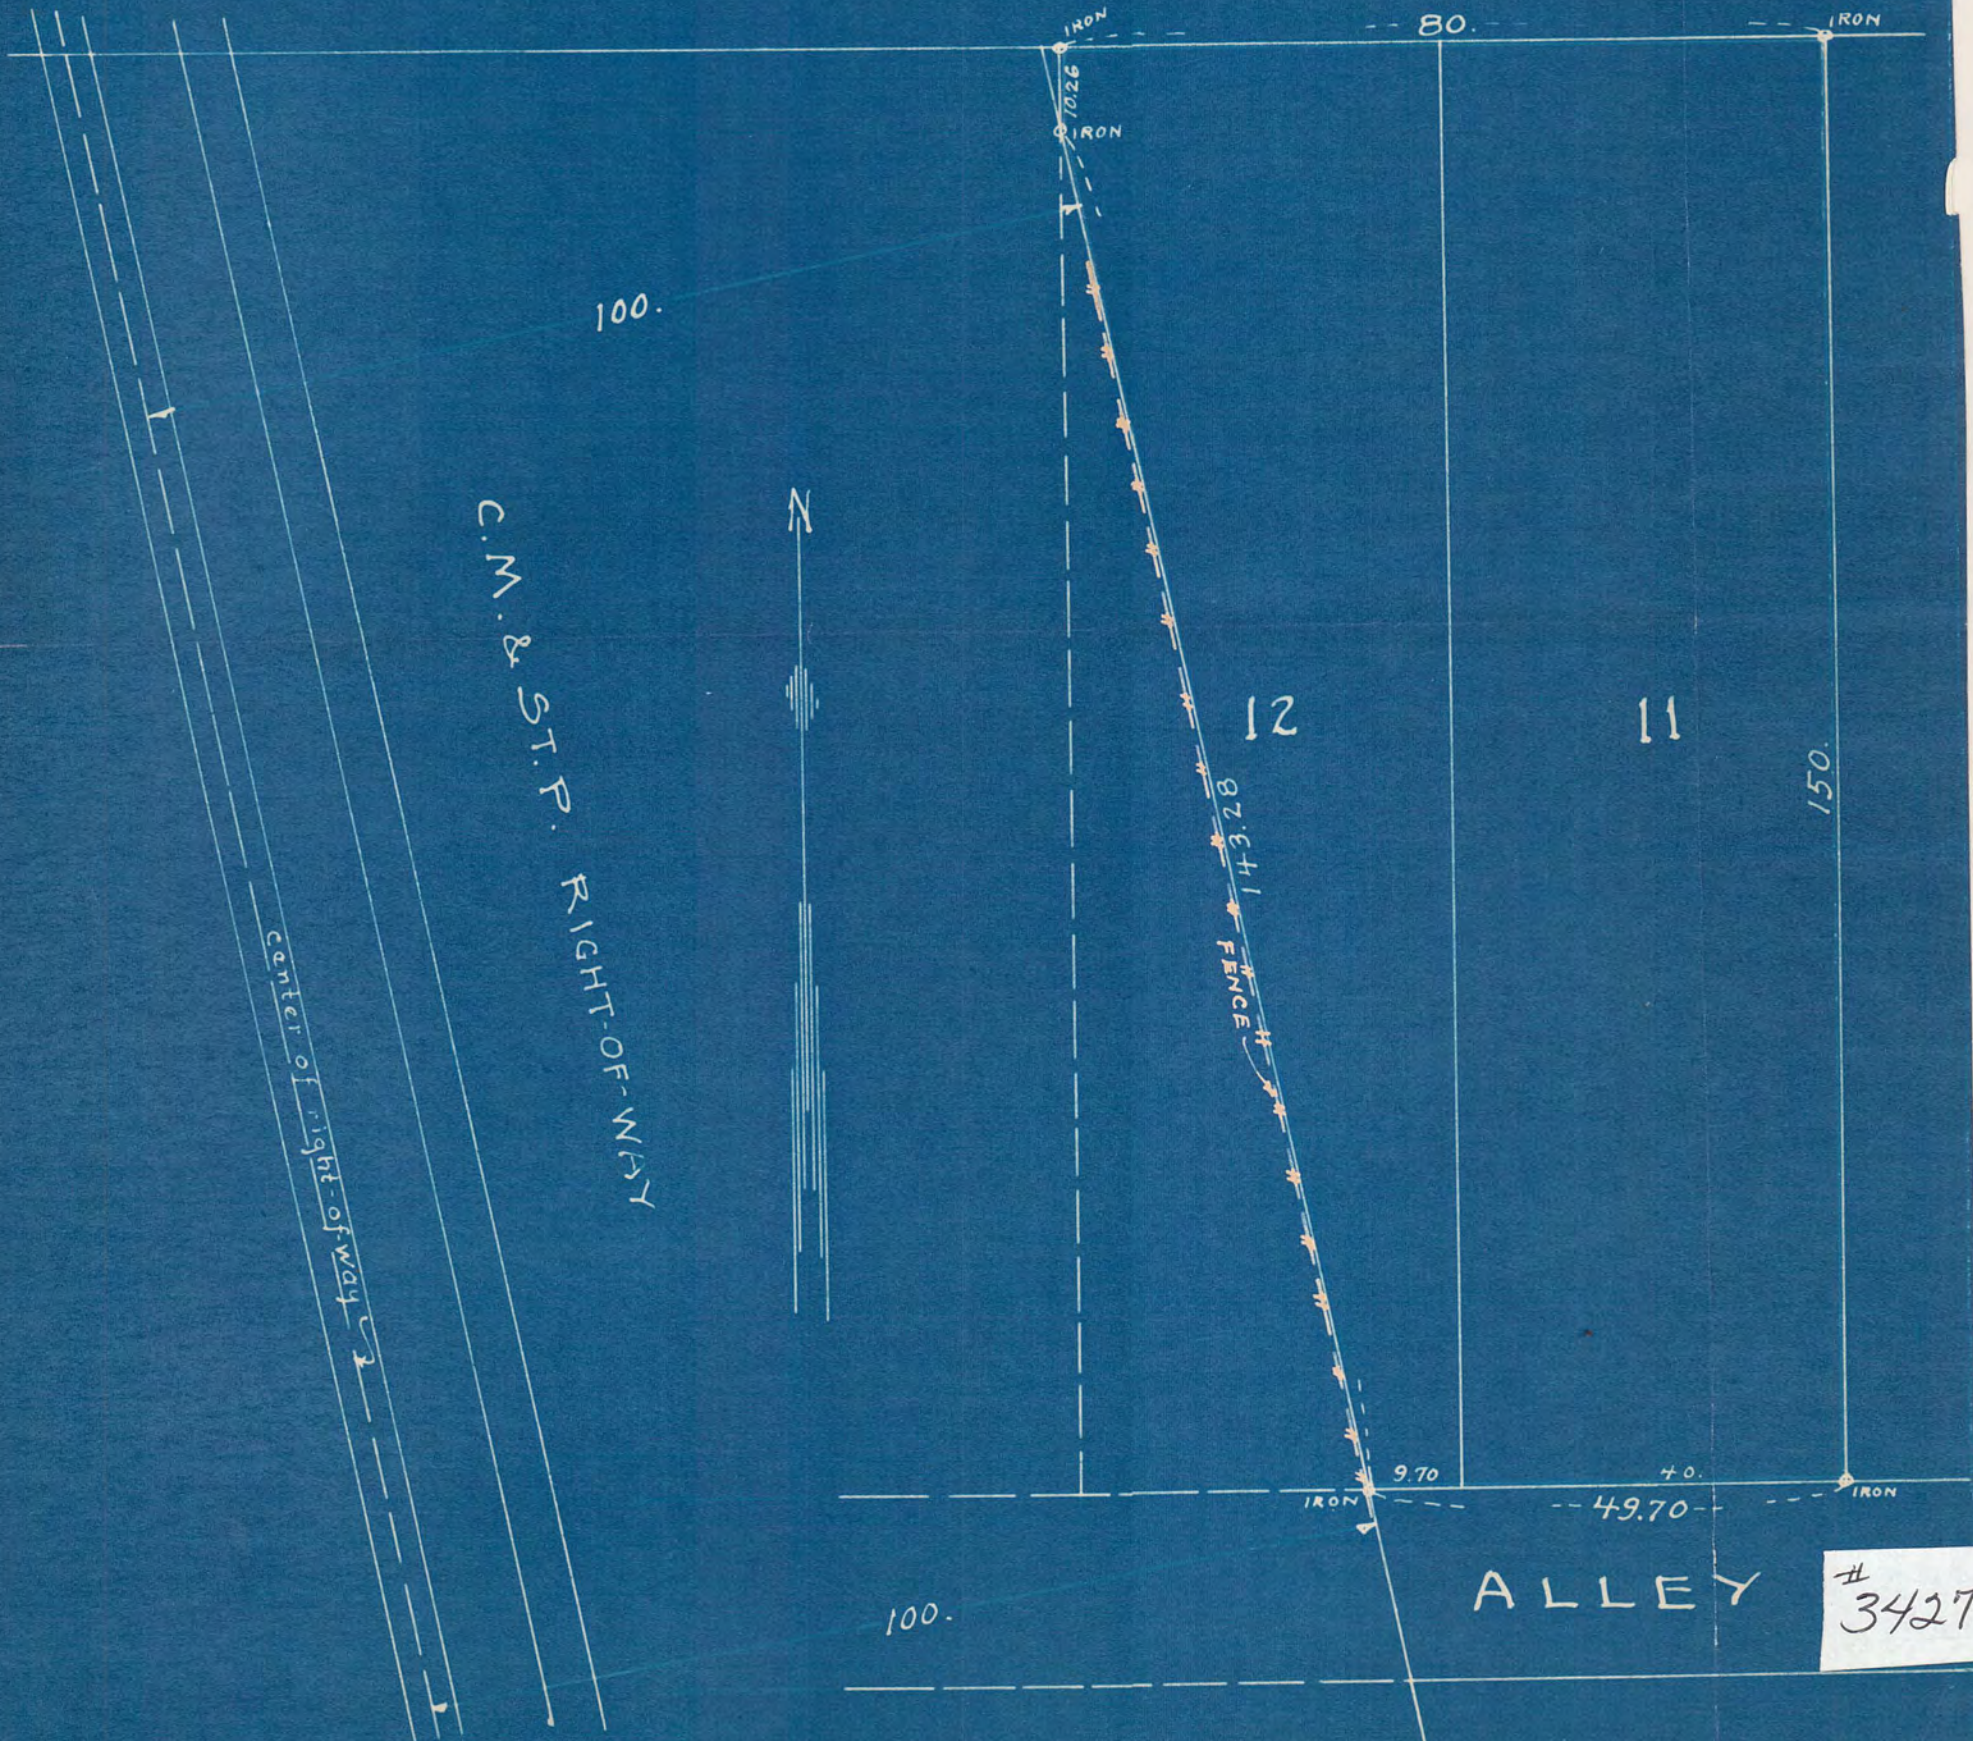

3427