
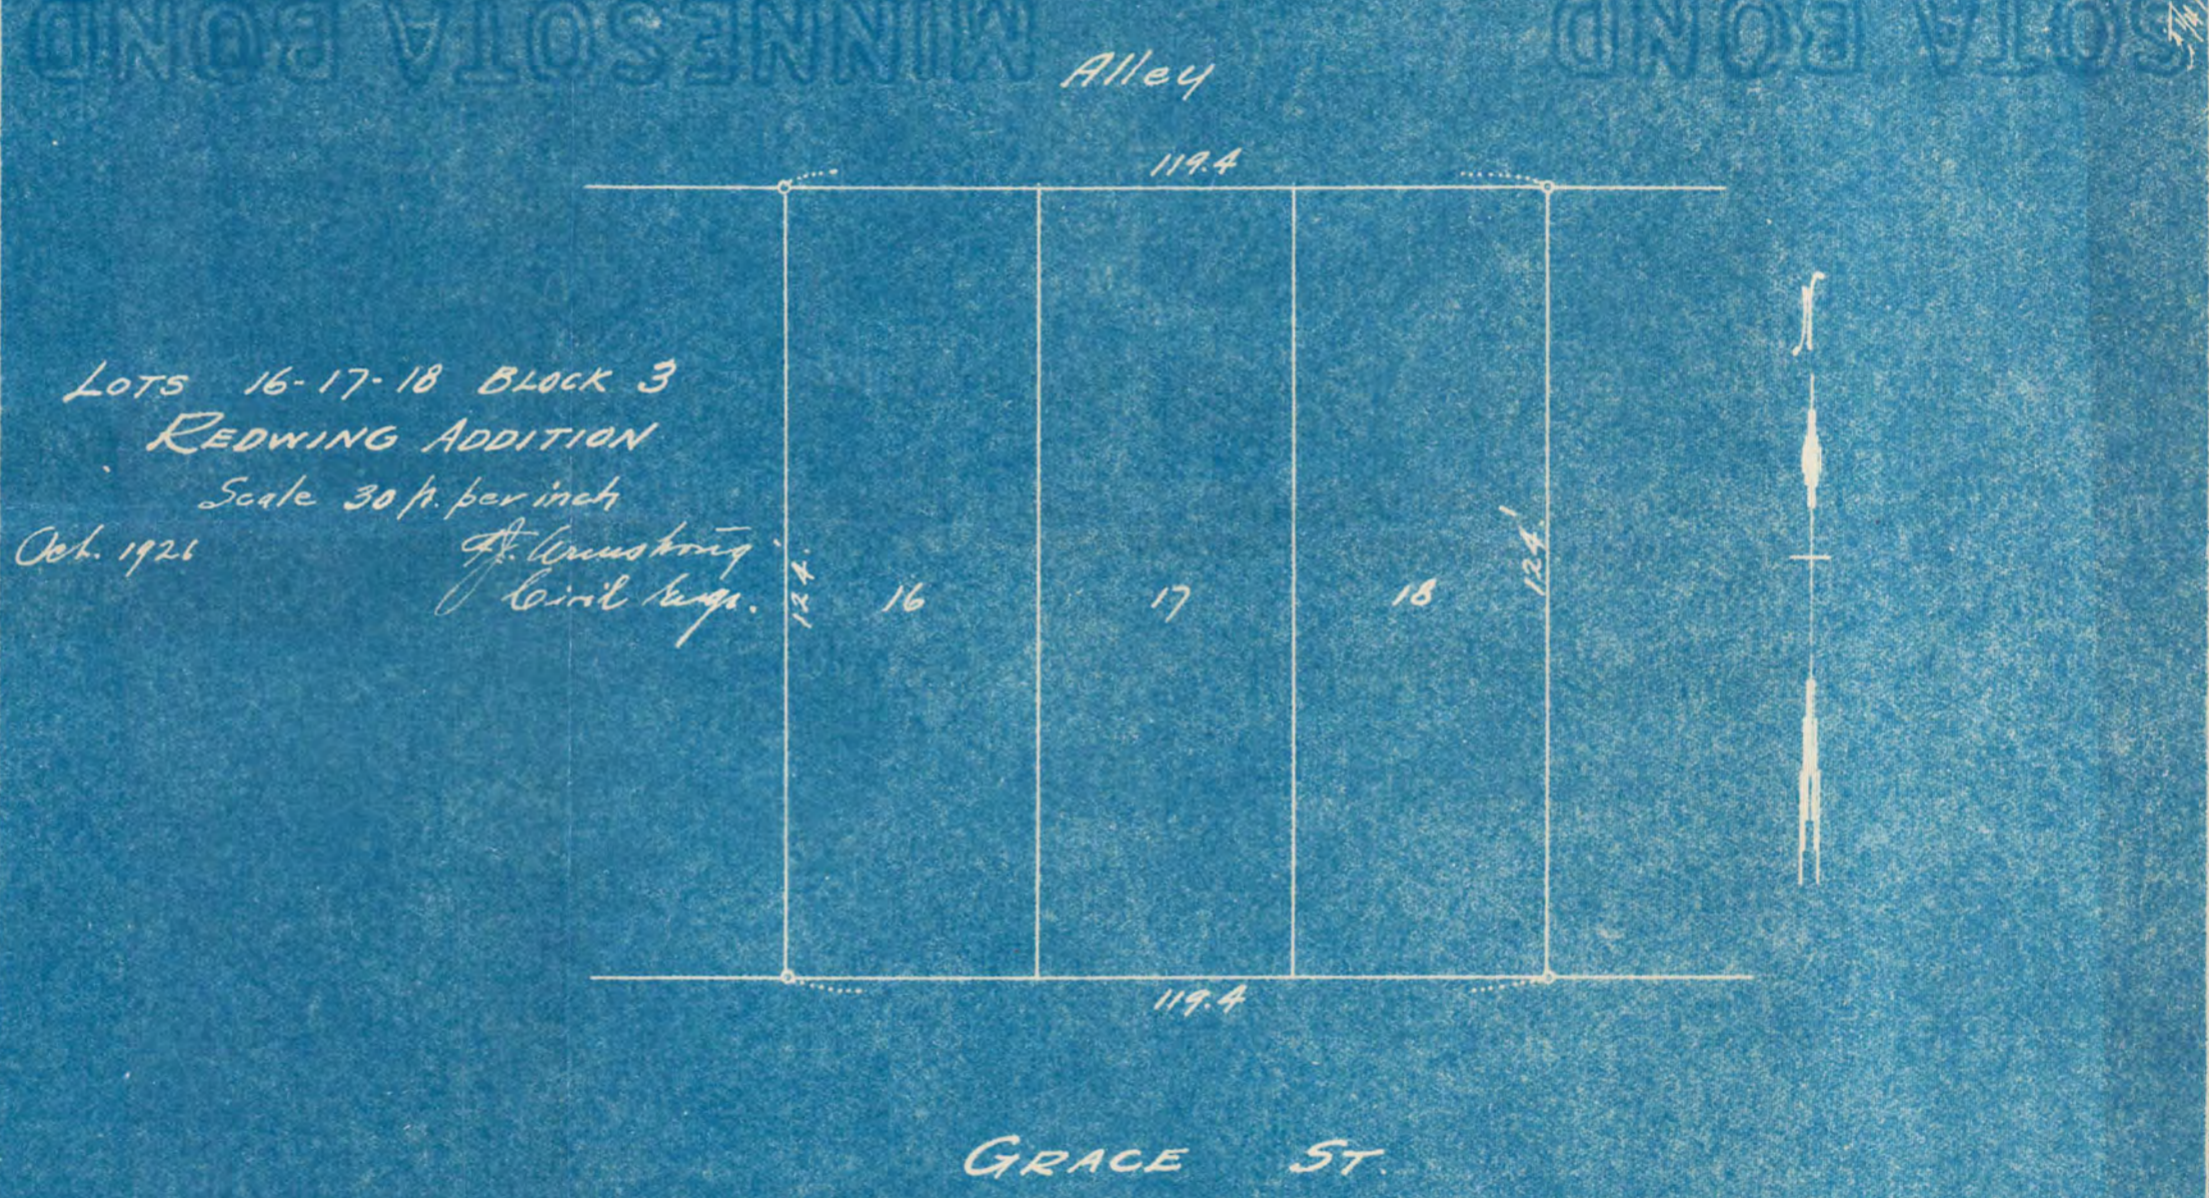


Location \_\_\_\_\_  
 House No. \_\_\_\_\_  
 Construction \_\_\_\_\_  
 Position \_\_\_\_\_  
 View \_\_\_\_\_  
 Date \_\_\_\_\_

**CERTIFICATE of SURVEY**  
 Franklyn J. Armstrong  
 CIVIL ENGINEER AND SURVEYOR  
 ST. PAUL, MINN.  
 GUARDIAN LIFE BLDG.

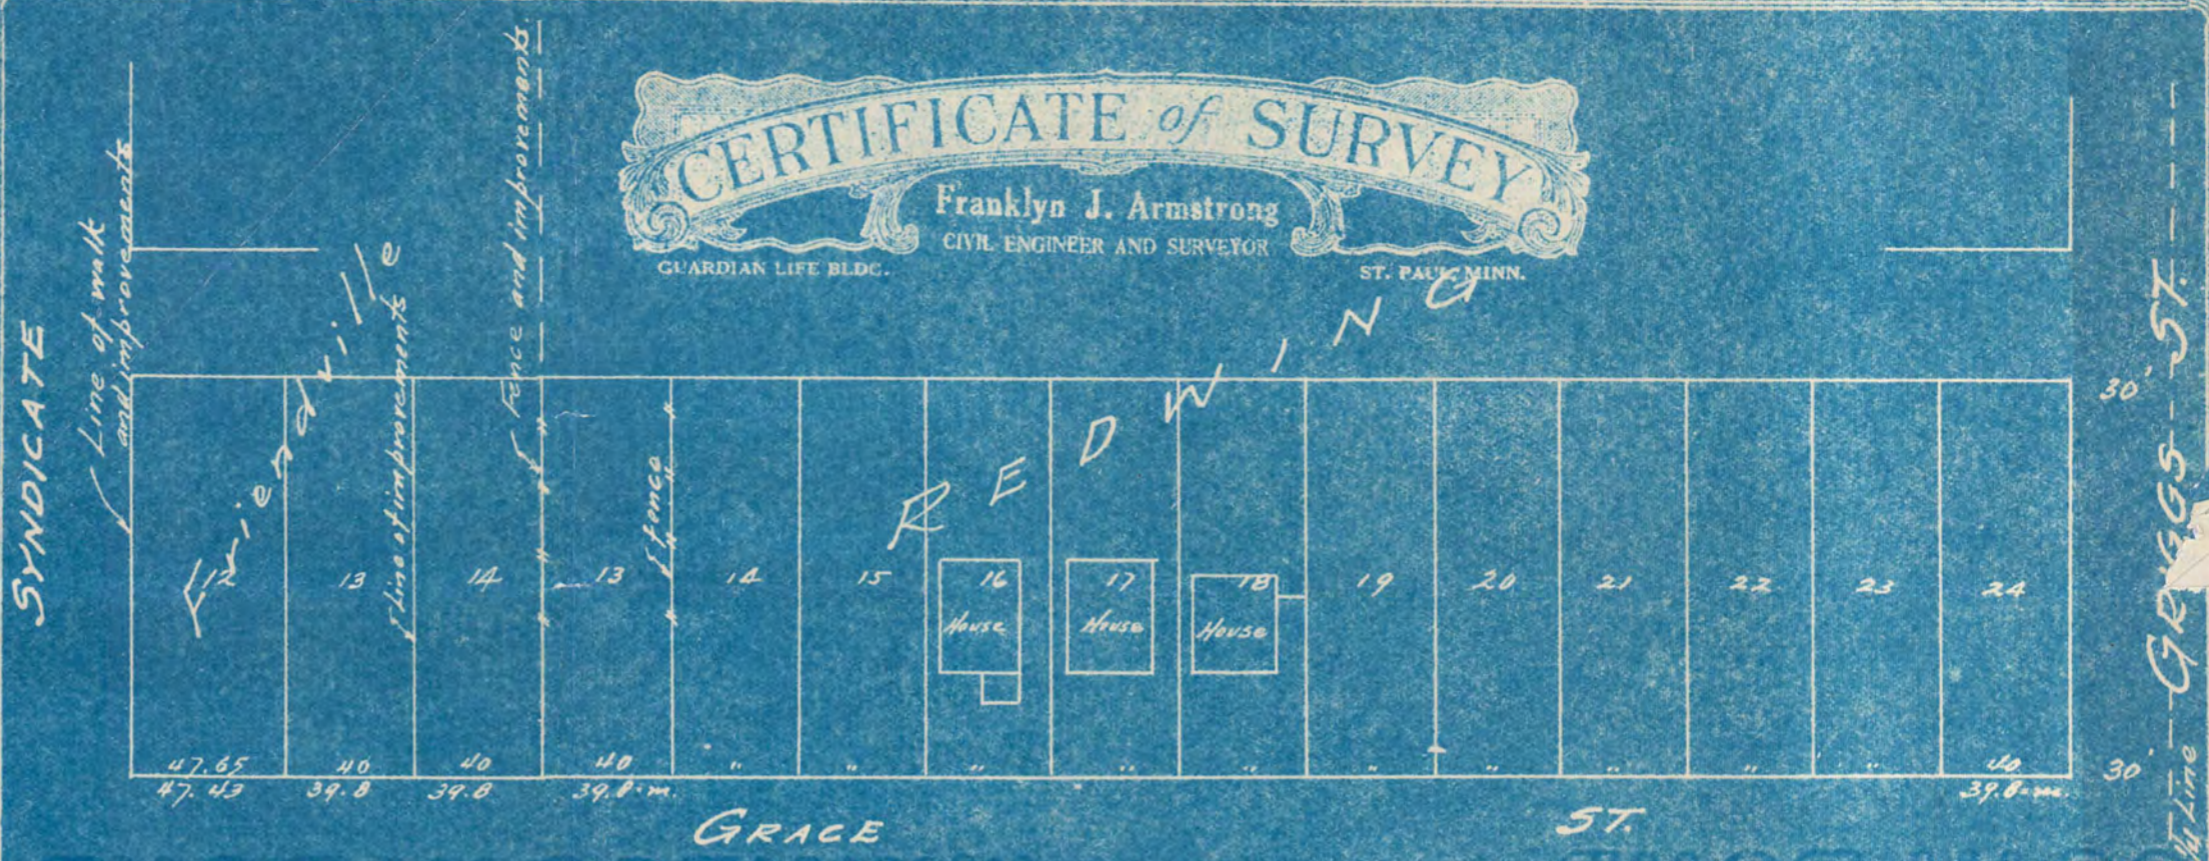

LOTS 16-17-18 BLOCK 3  
 REDWING ADDITION  
 Scale 30 ft. per inch  
 Oct. 1921  
 F. J. Armstrong  
 Civil Eng.

I hereby certify that on the 23<sup>rd</sup> day of October 1921  
 I made a survey of the following described premises to wit: Lots  
16-17-18 Block 3 Redwing Addition  
 and that the plat hereto attached is a true and correct plat of said  
 premises; and structures thereon that the photograph hereto attached is a true and correct  
 photograph of said premises; and that the line shown on said photo-  
 graph corresponds with \_\_\_\_\_ said plat.

Subscribed and sworn to before me  
 this \_\_\_\_\_ day of \_\_\_\_\_ 19\_\_\_\_  
 \_\_\_\_\_  
 Notary Public  
 My commission expires \_\_\_\_\_

*F. J. Armstrong*  
 Civil Engineer  
 Patent Applied For

3438