

3455

SUMMIT PARK ADD.

SURVEY OF

LOT 4 & WLY. 30 FT. OF LOT 3 BLOCK 24


MARCH 12

JENS PEDERSEN
SURVEYOR

SCALE 20'=1"

LINCOLN

AVE.

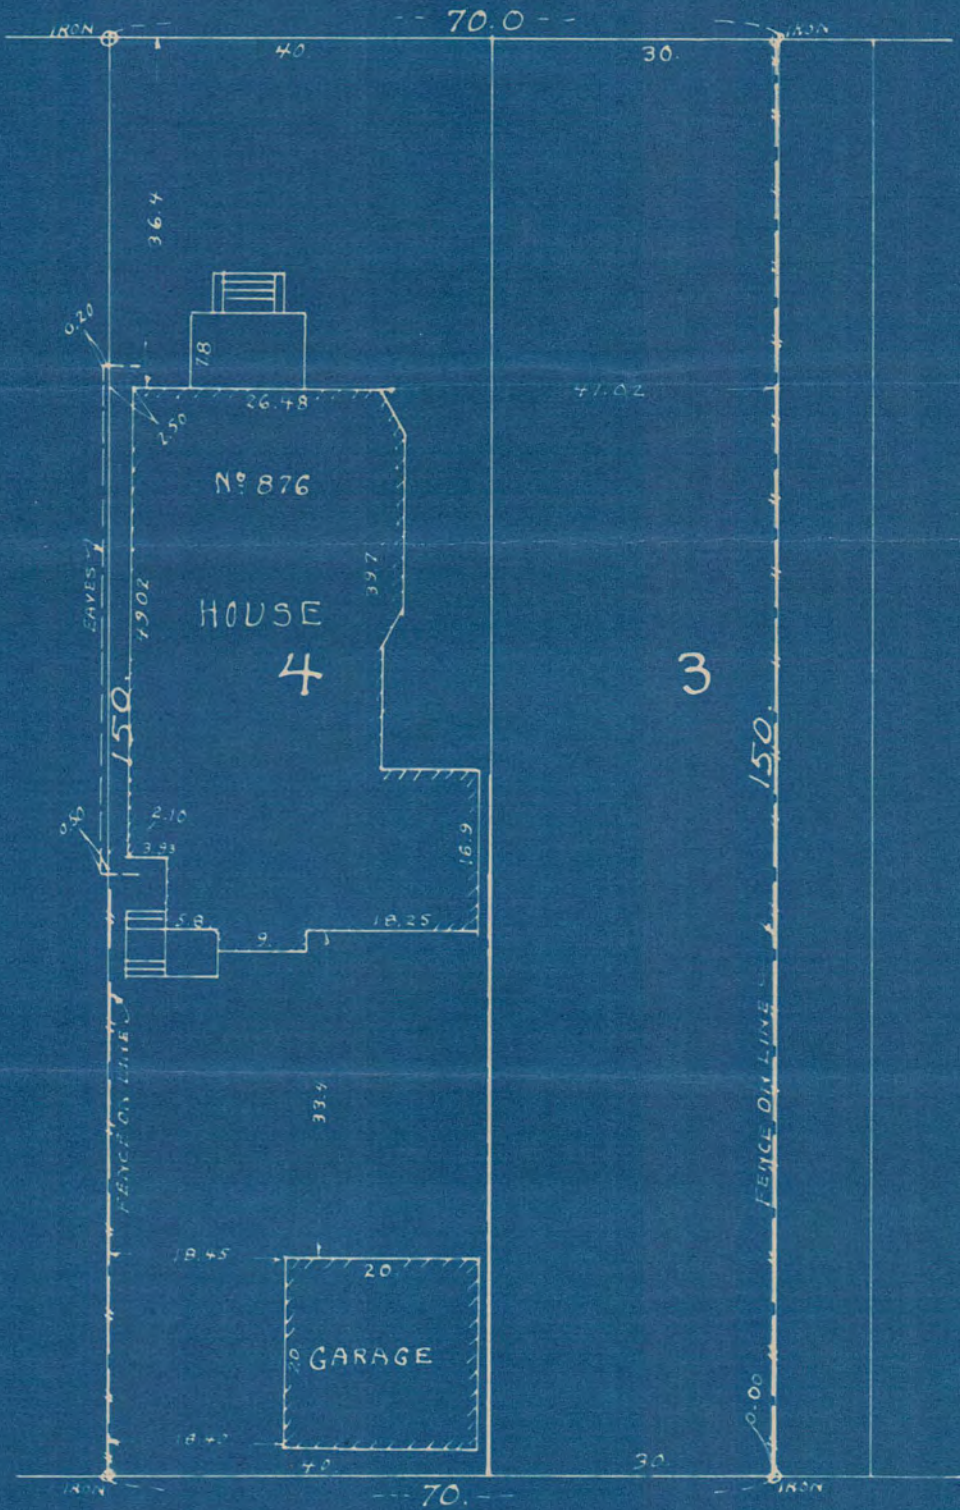

ALLEY

3455